


T. 8S. R. 39E. W.M.

↑
N

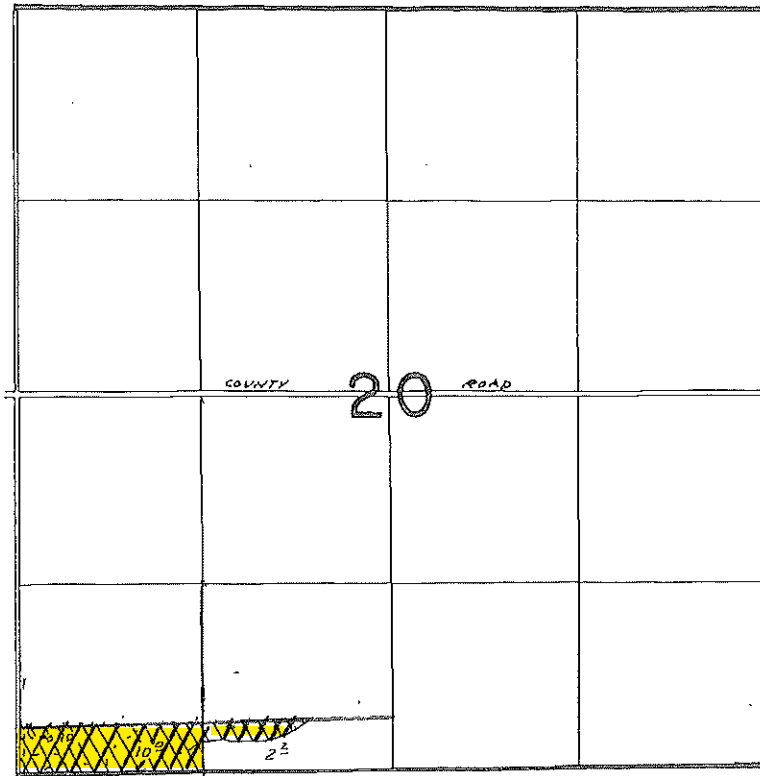

1" = 1320'

To be Canceled

10 acres SW, SW

2.2 acres SE, SW

TL #1700

Received

NOV 19 2024

OWRD