


T. 8S. R. 39E. W.M.

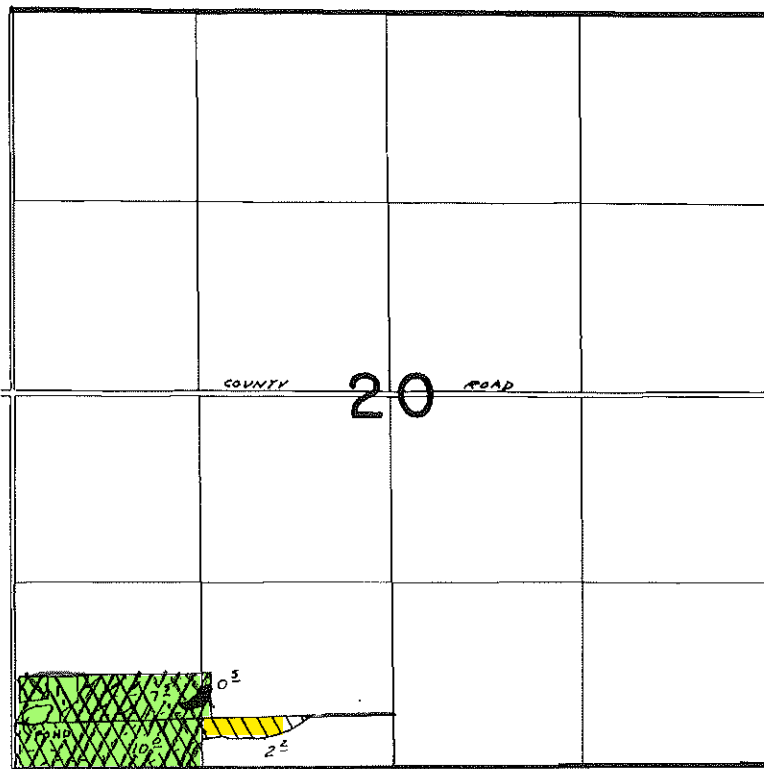

N

1" = 1320'



To be Canceled
2.2 acres SE, SW
Cert # 64315



Remaining Right
under Cert # 64315

Received

NOV 19 2024

OWRD