


TOWNSHIP 9 SOUTH, RANGE 1 WEST, W.M.

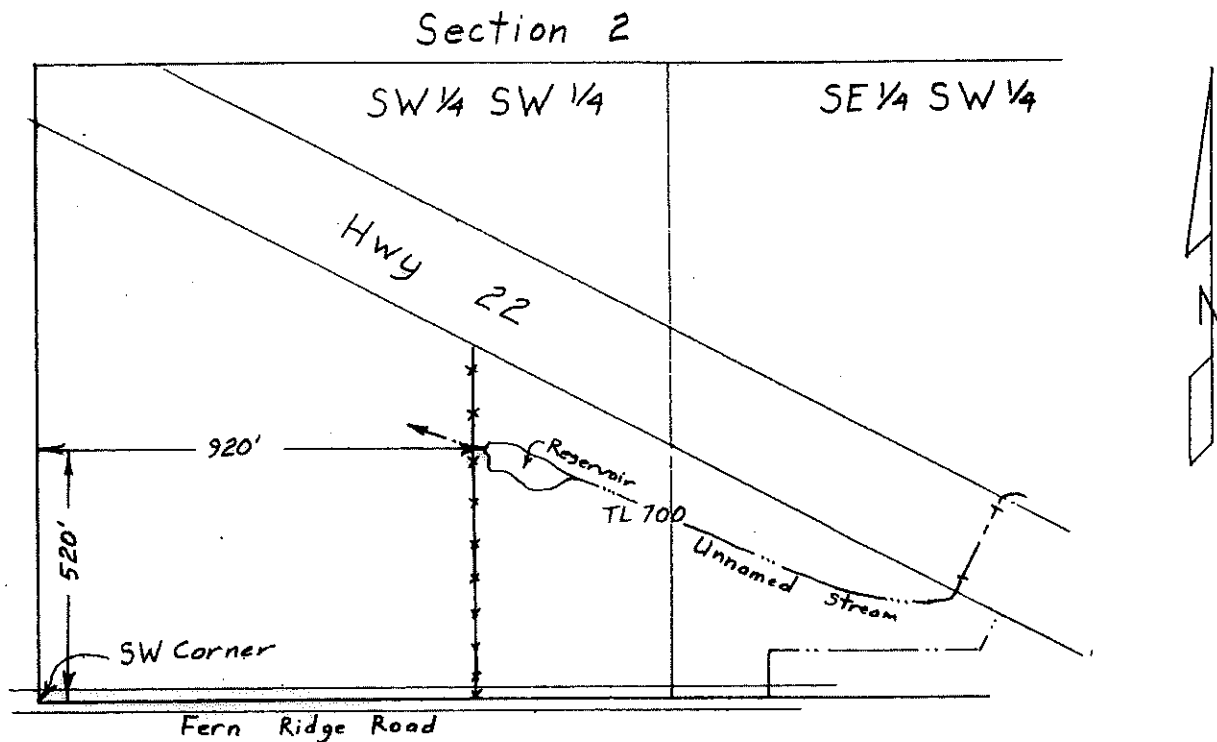

Surveyed Sep 10, 1999

Scale 1" = 400'

Claim of Beneficial Use Map
for


BRUCE PHILIPPI

App R-73255
Per R-11591

RECEIVED

SEP 24 1999

RECEIVED
SALEM, OREGON

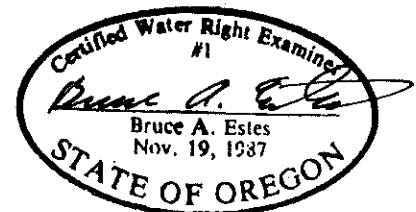

This map is for the purpose of
locating a water right only
and has no intent to provide
legal dimensions or the location
of property lines.

ESTES SURVEYS

6293 Sunnyview Rd. NE 60382 Arnold Rd.
Salem, OR 97305 Bend, OR 97702
(503) 585-7593 (503) 382-7391