


CLAIM of BENEFICIAL USE

FOR: MICHAEL WIGHTON
BY: NATHAN REED, PE, CWRE
T25S, R4W, W.M. SECTION 9, DLC 49
APPLICATION NO. S-88693
PERMIT NO. S-55273

DATE OF SURVEY: SEPTEMBER 27, 2023


SCALE: 1" = 400'

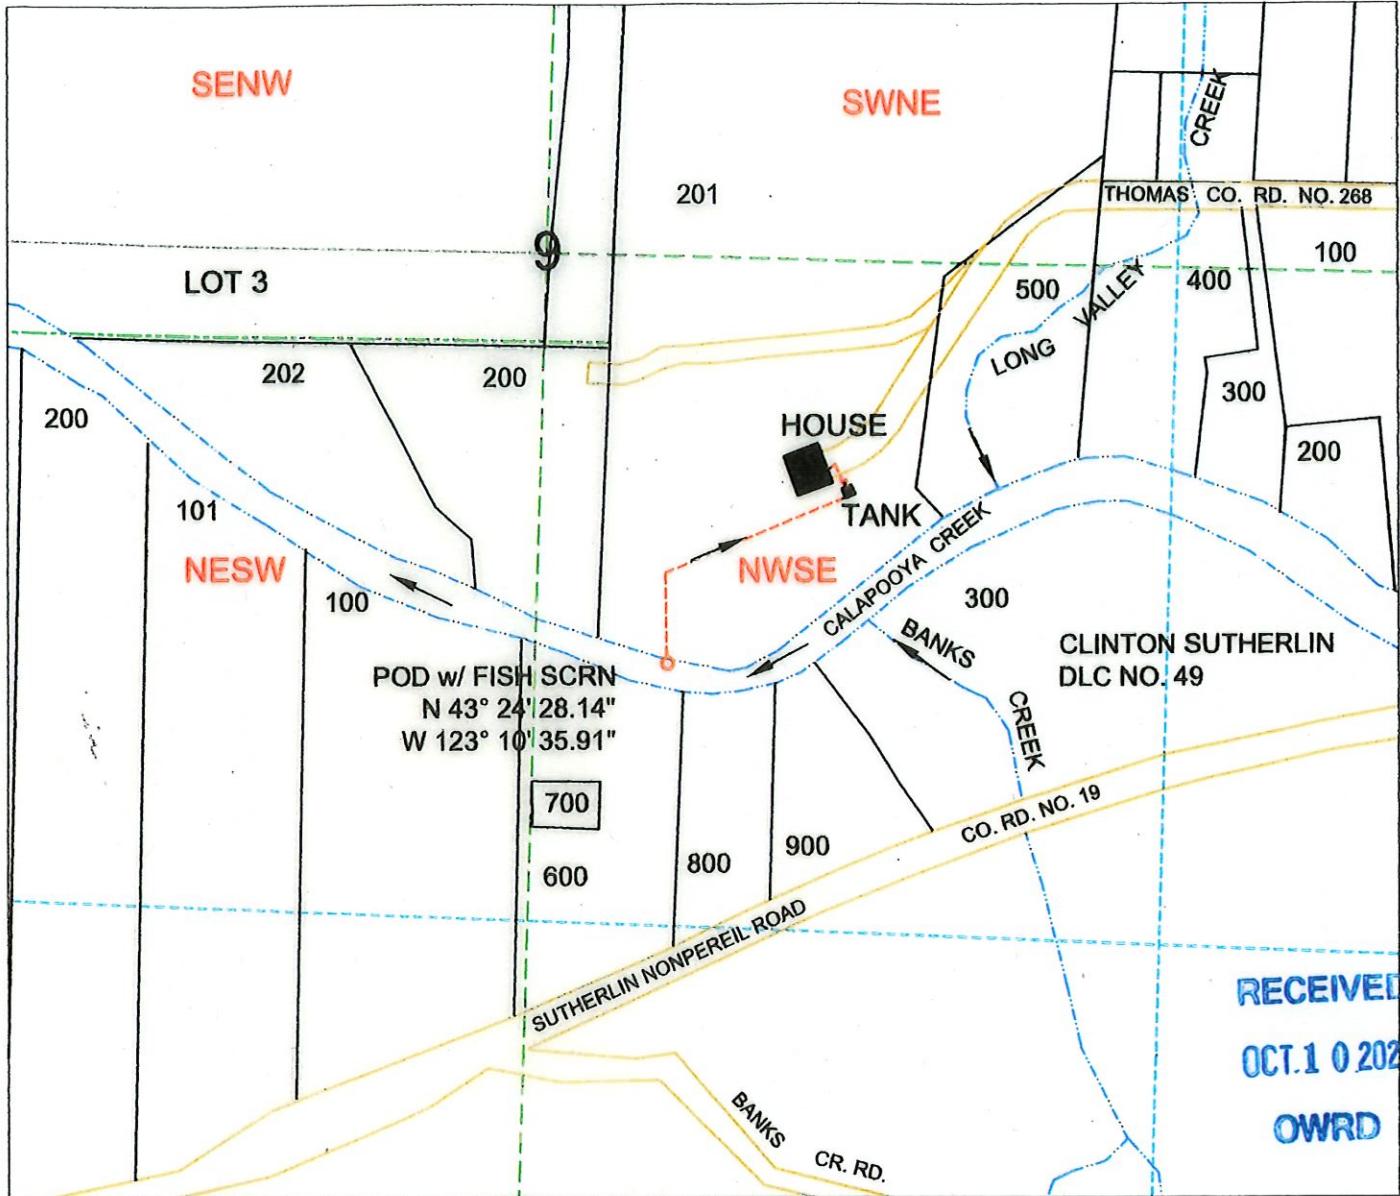

POD IS LOCATED 850 FEET SOUTH & 250 FEET EAST OF C1/4 CORNER OF SECTION 9, WITHIN OF DLC NO. 49.

LEGEND

- | | | | |
|--|---------|--|-----------------|
| | WATER | | SIXTEENTH |
| | POD | | DLC |
| | PIPE | | GLOT |
| | SECTION | | PARCEL |
| | QUARTER | | FLOW RESTRICTOR |
| | TANK | | |

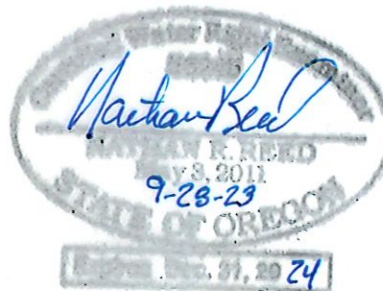

MAP PREPARED FOR:
MICHAEL WIGHTON
700 THOMAS RD
SUTHERLIN, OR 97479

MAP PREPARED BY:
NATHAN REED PE, CWRE
157 WEST BODIE STREET
ROSEBURG, OR 97471

THE PURPOSE OF THIS MAP IS TO IDENTIFY THE LOCATION OF THE WATER RIGHT.
IT IS NOT INTENDED TO PROVIDE INFORMATION RELATIVE TO THE LOCATION OF
PROPERTY OWNERSHIP BOUNDARY LINES.