


# T.2S. R.3E. Section 30, W.M.

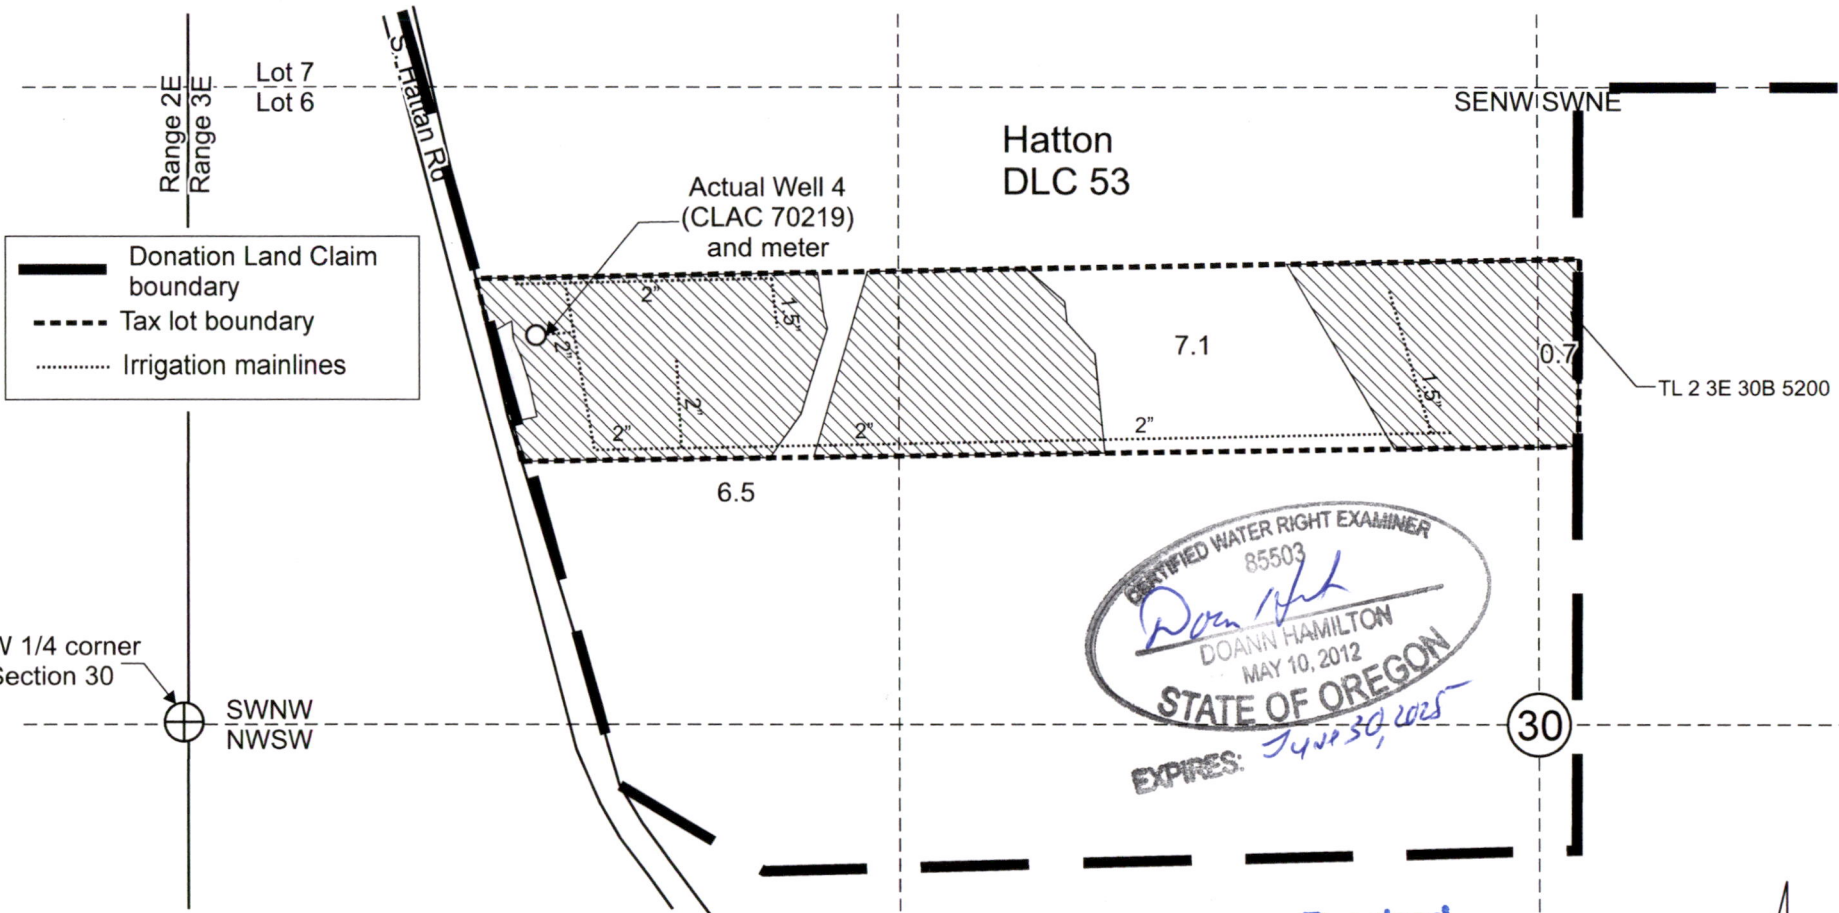

CERTIFIED WATER RIGHT EXAMINER  
85503  
*Doann Hamilton*  
DOANN HAMILTON  
MAY 10, 2012  
STATE OF OREGON  
EXPIRES: *July 30, 2025*


Received  
AUG 29 2024  
OWRD

Received  
SEP 12 2024  
OWRD

Well 4 (CLAC 70219) is located 805 feet north and 730 feet east from the W 1/4 corner, Section 30.

Area (14.3 Acres) of nursery operations under Application G-17221, Permit G-16784.

Scale: 1" = 400'

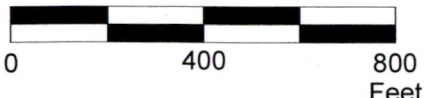

This map was prepared for the purpose of identifying the location of a water right only and is not intended to provide legal dimensions or location of property ownership lines.

Pacific Hydro-Geology Inc.

08/2024

Claim of Beneficial Use Map  
Application G-17221, Permit G-16784

Issa and Ragehda Karam  
T.2S. R.3E. Section 30, W.M.

KaramG-17221COBUMap.cdr