


8-30-2023
EXP 12-31-2024

TRANSFER MAP FROM C#47289 T 38 S, R 8 W, W M, JOSEPHINE COUNTY

Section 22 - N1/2 SW1/4

AUGUST 30, 2023

N
1"=400'

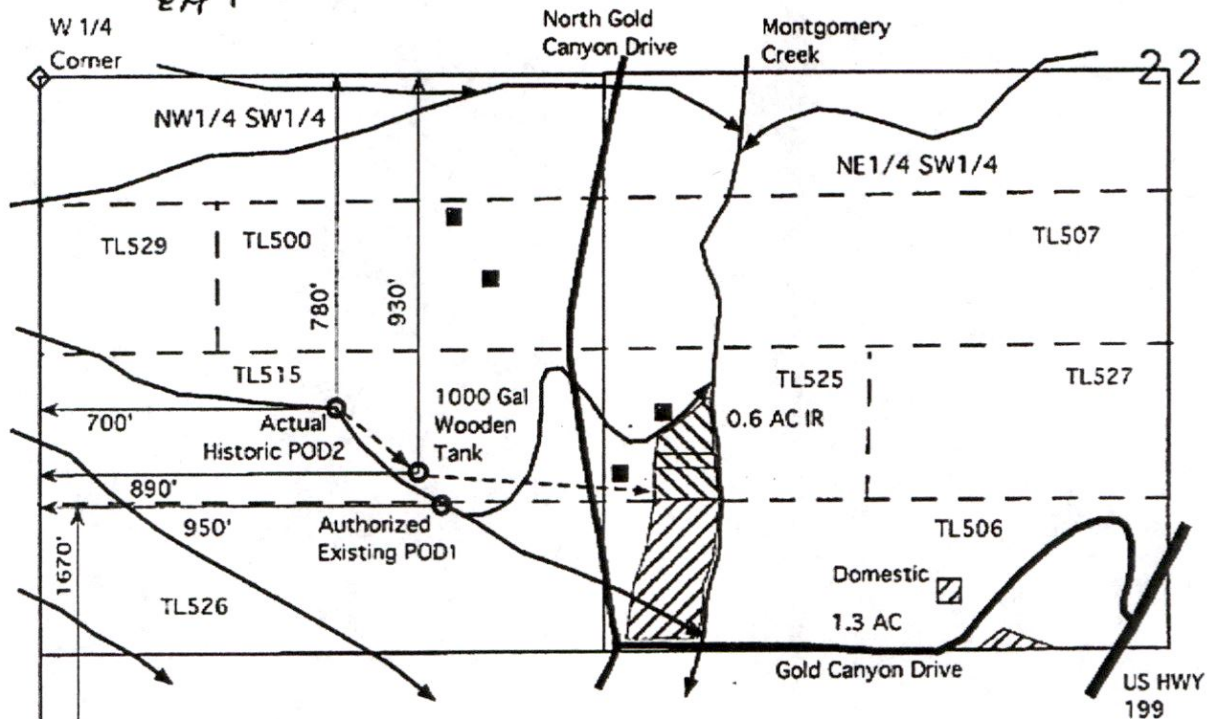

Certificate 47289 has a priority of November 11, 1908 for the irrigation of 2.7 acres with a rate of 0.02 cfs per acre plus domestic use from springs during April 1 through November 1.

- Authorized POD, historic POD, and a water tank - - - 1.25" poly hose and 2.0" PVC pipe
- 0.6 acres of existing irrigation to have the authorized POD1 changed to the historic POD2.
- 1.3 acres of remaining irrigation rights including domestic use for one family.
- Roads Unnamed streams Tax lot boundaries Buildings

21 22
28 27

RECEIVED
SEP 22 2023
OWRD

This map was drawn by Gordon R. Lyford for Ken and Amy Montgomery to support their water right transfer application from certificate 47289 to change the authorized POD1 to the historic POD2. Ken and Amy Montgomery own tax lots 500, 525, and 527.

This map was prepared for the purpose of identifying the location of water rights only and is not intended to provide legal dimensions or the location of property ownership lines.

14329