


RECEIVED

JUL 06 2022

OWRL

Claim of Beneficial Use Application R-87815, Permit R-15003 Leschen, Ann

Township 13S, Range 1E, W.M.

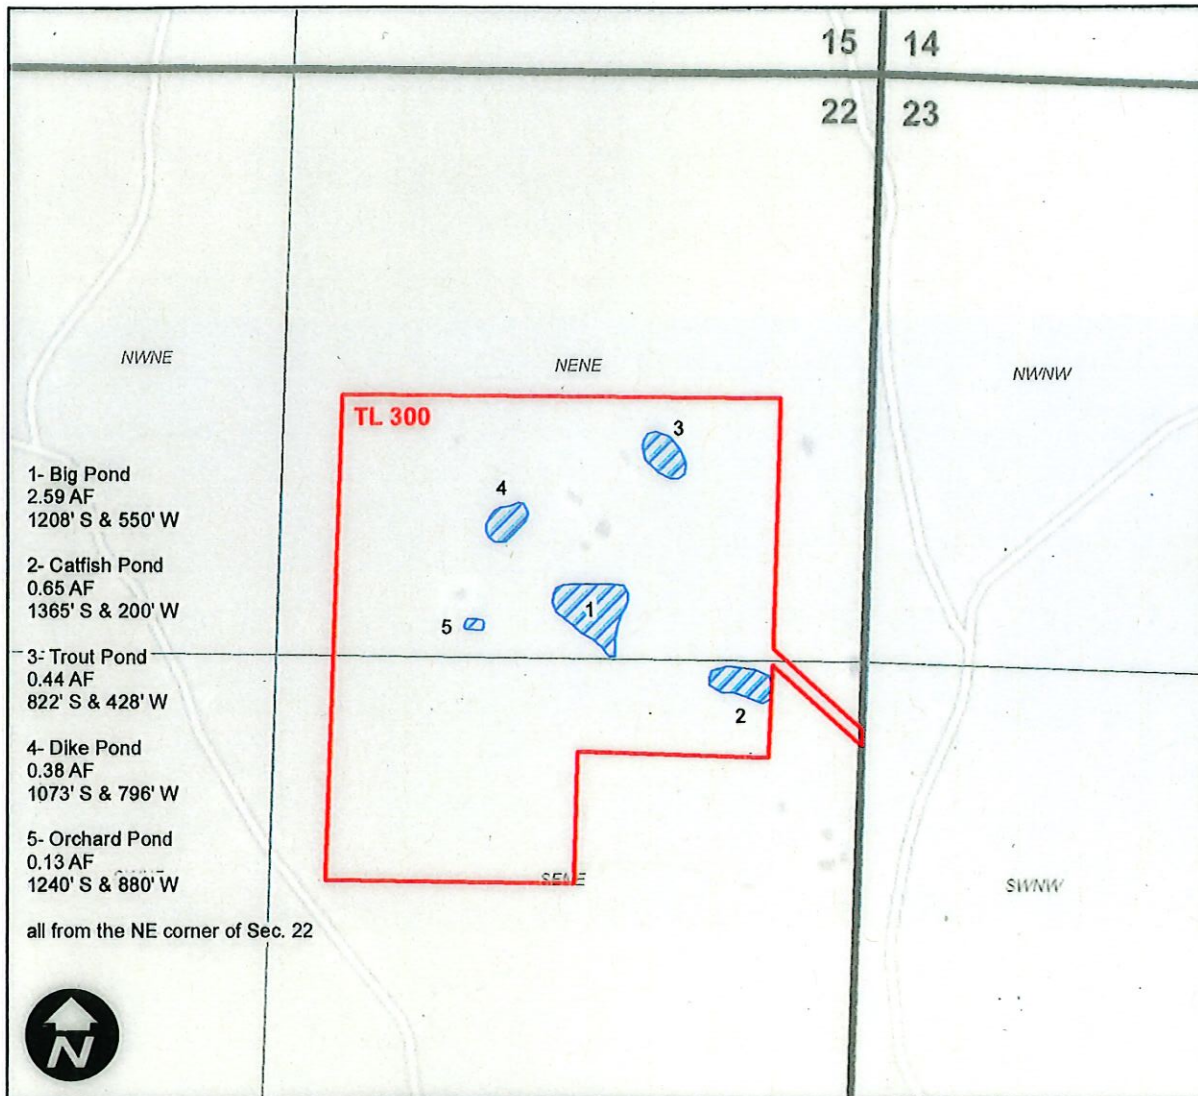

0 200 400 800 Feet

Legend

- POU
- Tax Lot

This map is not intended to provide legal dimensions or locations of property ownership lines.

