


FINAL PROOF SURVEY MAP

T 2 N R 1 W, Section 6

Prepared for: Island Springs Hatchery
Andrew & Michelle Hansen
Application G-15830 Permit G-15439
T-9797 & T-10428 (permit amendments)

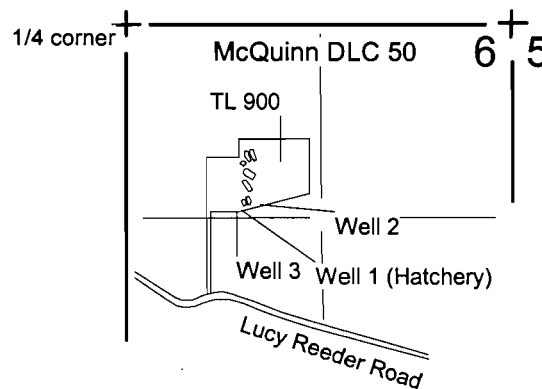

RECEIVED
JUN 2 1987
SALEM, OREGON

Well 1 (Hatchery): 1265' S & 1870' W
Well 2: 1150' S & 1780' W
Well 3: 1270' S & 1970' W
All from the NE corner Section 6
All wells have measuring devices at well site.

1" = 1320'



This map is for water
right purposes only.

