

KNEE DEEP CATTLE COMPANY

TRANSFER APPLICATION MAP EXISTING PLACE OF USE

JUNE 3, 2021


TAXLOTS 100, 101, & 700 MAP 160328

LOCATED IN
SECTION 28, TOWNSHIP 16 SOUTH, RANGE 3 WEST, W.M.
LANE COUNTY, OREGON



RENEWS:

RECEIVED
JUL 29 2021
OWRD

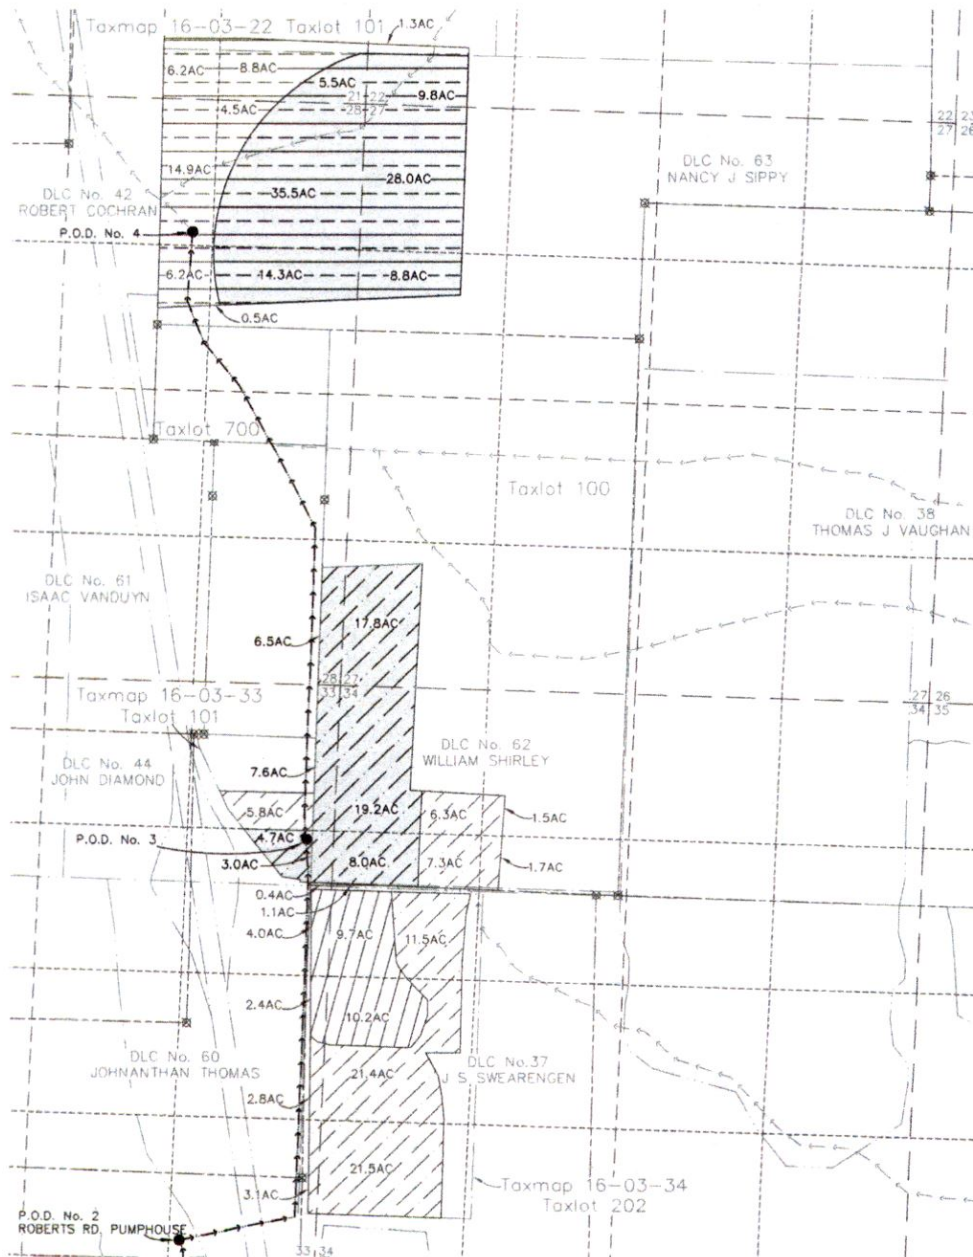

LEGEND

- TAXLOT BOUNDARY
- SECTION BOUNDARY
- 1/4 SECTION BOUNDARY
- 1/4 1/4 SECTION BOUNDARY
- ROADS
- EXISTING DITCH WITH FLOW DIRECTION
- MIKE STEVENSON IRRIGATION CANAL
- DLC BOUNDARY
- ⊗ DLC CORNER MONUMENT
- POINT OF DIVERSION (PUMP)
- 0.00 AC AREA TO BE TRANSFERRED
- 0.00 AC AREA TO REMAIN AS IS

MAP DEVELOPED USING LANE COUNTY GIS AND TAXMAPS. NO FIELD SURVEY WAS CONDUCTED. THIS IS NOT INTENDED TO PROVIDE LEGAL DIMENSIONS OR LOCATION OF PROPERTY OWNERSHIP LINES.

SCALE 1" = 1320'

HATCH	CERT#	AREA	REPRESENTING AREA
---	91761	42.4	TO BE TRANSFERRED
---	91761	101.9	TO REMAIN AS IS
---	80835	82.9	TO BE TRANSFERRED
---	80835	66.8	TO REMAIN AS IS
---	86338	27.8	TO BE TRANSFERRED

JDMcGee, Inc.

Engineering & Surveying 1215 Main Street
Land Use Planning PO Box 1472
Wastewater Design Philomath, OR 97370
"Solving Problems for You" (541) 929-4226
(541) 929-4227 Fax

DRAWN BY: CRM
JDM PROJECT #: 21-34

CHECKED BY: JDM 13782


KNEE DEEP CATTLE COMPANY

TRANSFER APPLICATION MAP PROPOSED PLACE OF USE

JUNE 3, 2021

TAXLOTS 100, 101, & 700 MAP 160328

LOCATED IN
SECTION 28, TOWNSHIP 16 SOUTH, RANGE 3 WEST, W.M.
LANE COUNTY, OREGON

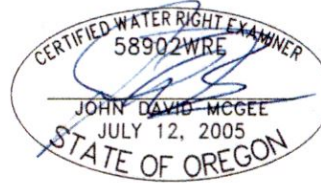


RENEWS:

RECEIVED

JUL 29 2021

OWRD

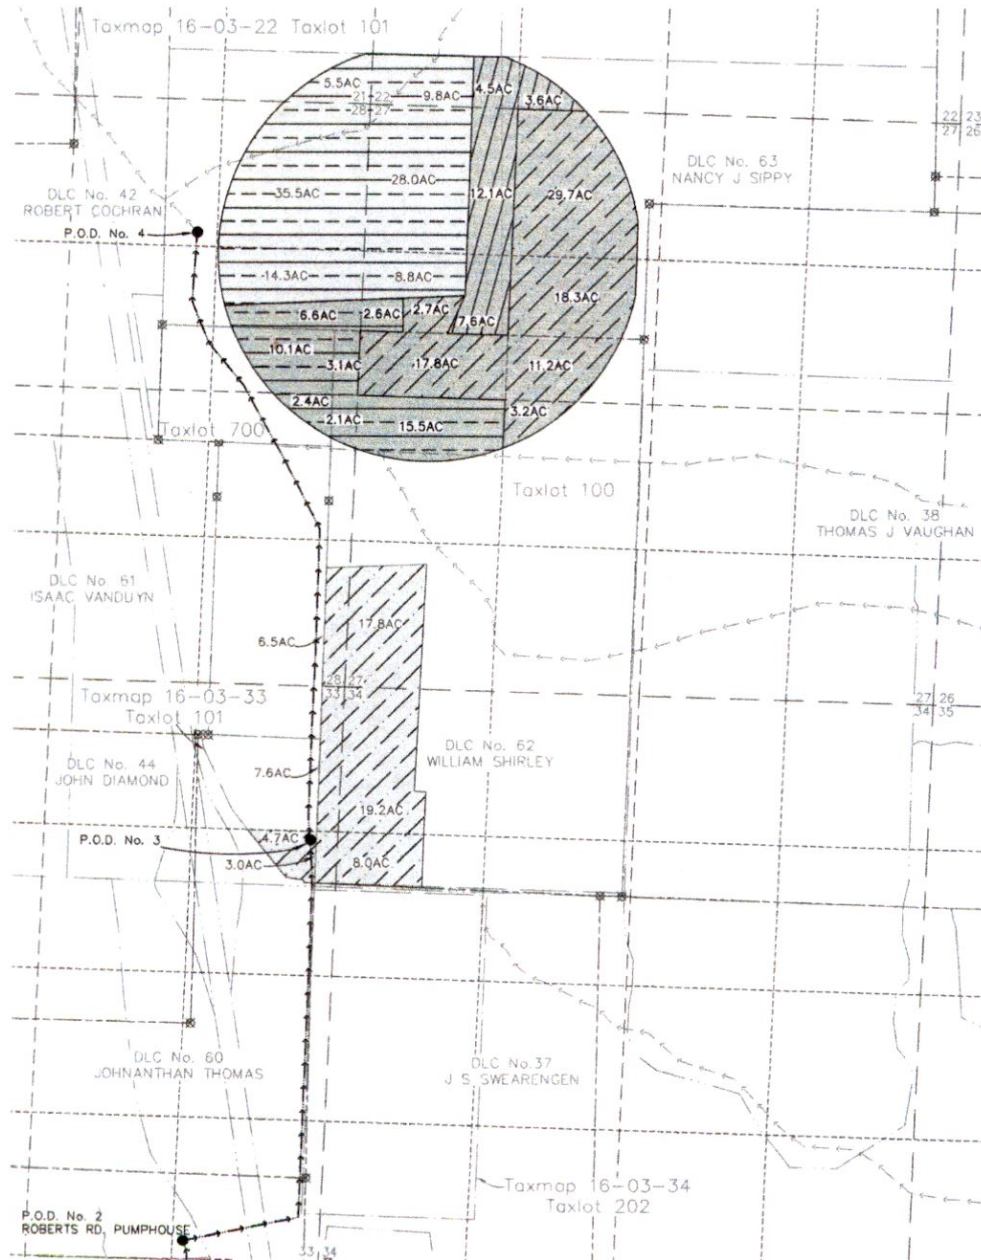

LEGEND

- TAXLOT BOUNDARY
- SECTION BOUNDARY
- 1/4 SECTION BOUNDARY
- 1/4 1/4 SECTION BOUNDARY
- ROADS
- EXISTING DITCH WITH FLOW DIRECTION
- MIKE STEVENSON IRRIGATION CANAL
- DLC BOUNDARY
- DLC CORNER MONUMENT
- PUMP
- 0.00 AC AREA TO BE TRANSFERRED
- 0.00 AC AREA TO REMAIN AS IS

MAP DEVELOPED USING LANE COUNTY GIS AND TAXMAPS. NO FIELD SURVEY WAS CONDUCTED. THIS IS NOT INTENDED TO PROVIDE LEGAL DIMENSIONS OR LOCATION OF PROPERTY OWNERSHIP LINES.

HATCH	CERT#	AREA	REPRESENTING AREA
---	91761	101.9	TO REMAIN AS IS
---	91761	42.4	PROPOSED
---	80835	66.8	TO REMAIN AS IS
---	80835	82.9	PROPOSED
---	86338	27.8	PROPOSED

JDMcGee, Inc.

Engineering & Surveying 1215 Main Street
"Solving Problems for You" (541) 929-4227
(541) 929-4227 fax

DRAWN BY: CRM
JDM PROJECT #: 21-34

CHECKED BY: JDM

SCALE 1" = 1320'

Twp. 14 S., Rng. 3 W., WM.



LEGEND


[Symbol]	Permit 50021
[Symbol]	Permit 50027
[Symbol]	Permit 4259
[Symbol]	Permit 43710
[Symbol]	Permit 45980
[Symbol]	Certificate 51599
[Symbol]	Certificate 62148
[Symbol]	Certificate 62281



SCALE 1" = 1320'

FINAL PROOF SURVEY		
UNDER		
Application	49527	Permit 37877
	55400	42759
	57947	43710
	58932	45980
	68824	50921
IN NAME OF		
MUDDY CREEKS IRRIGATION PROJECT		
Surveyed 1993 By R.W.Klassen		

Twp. 14 S., Rng. 4 W., WM.

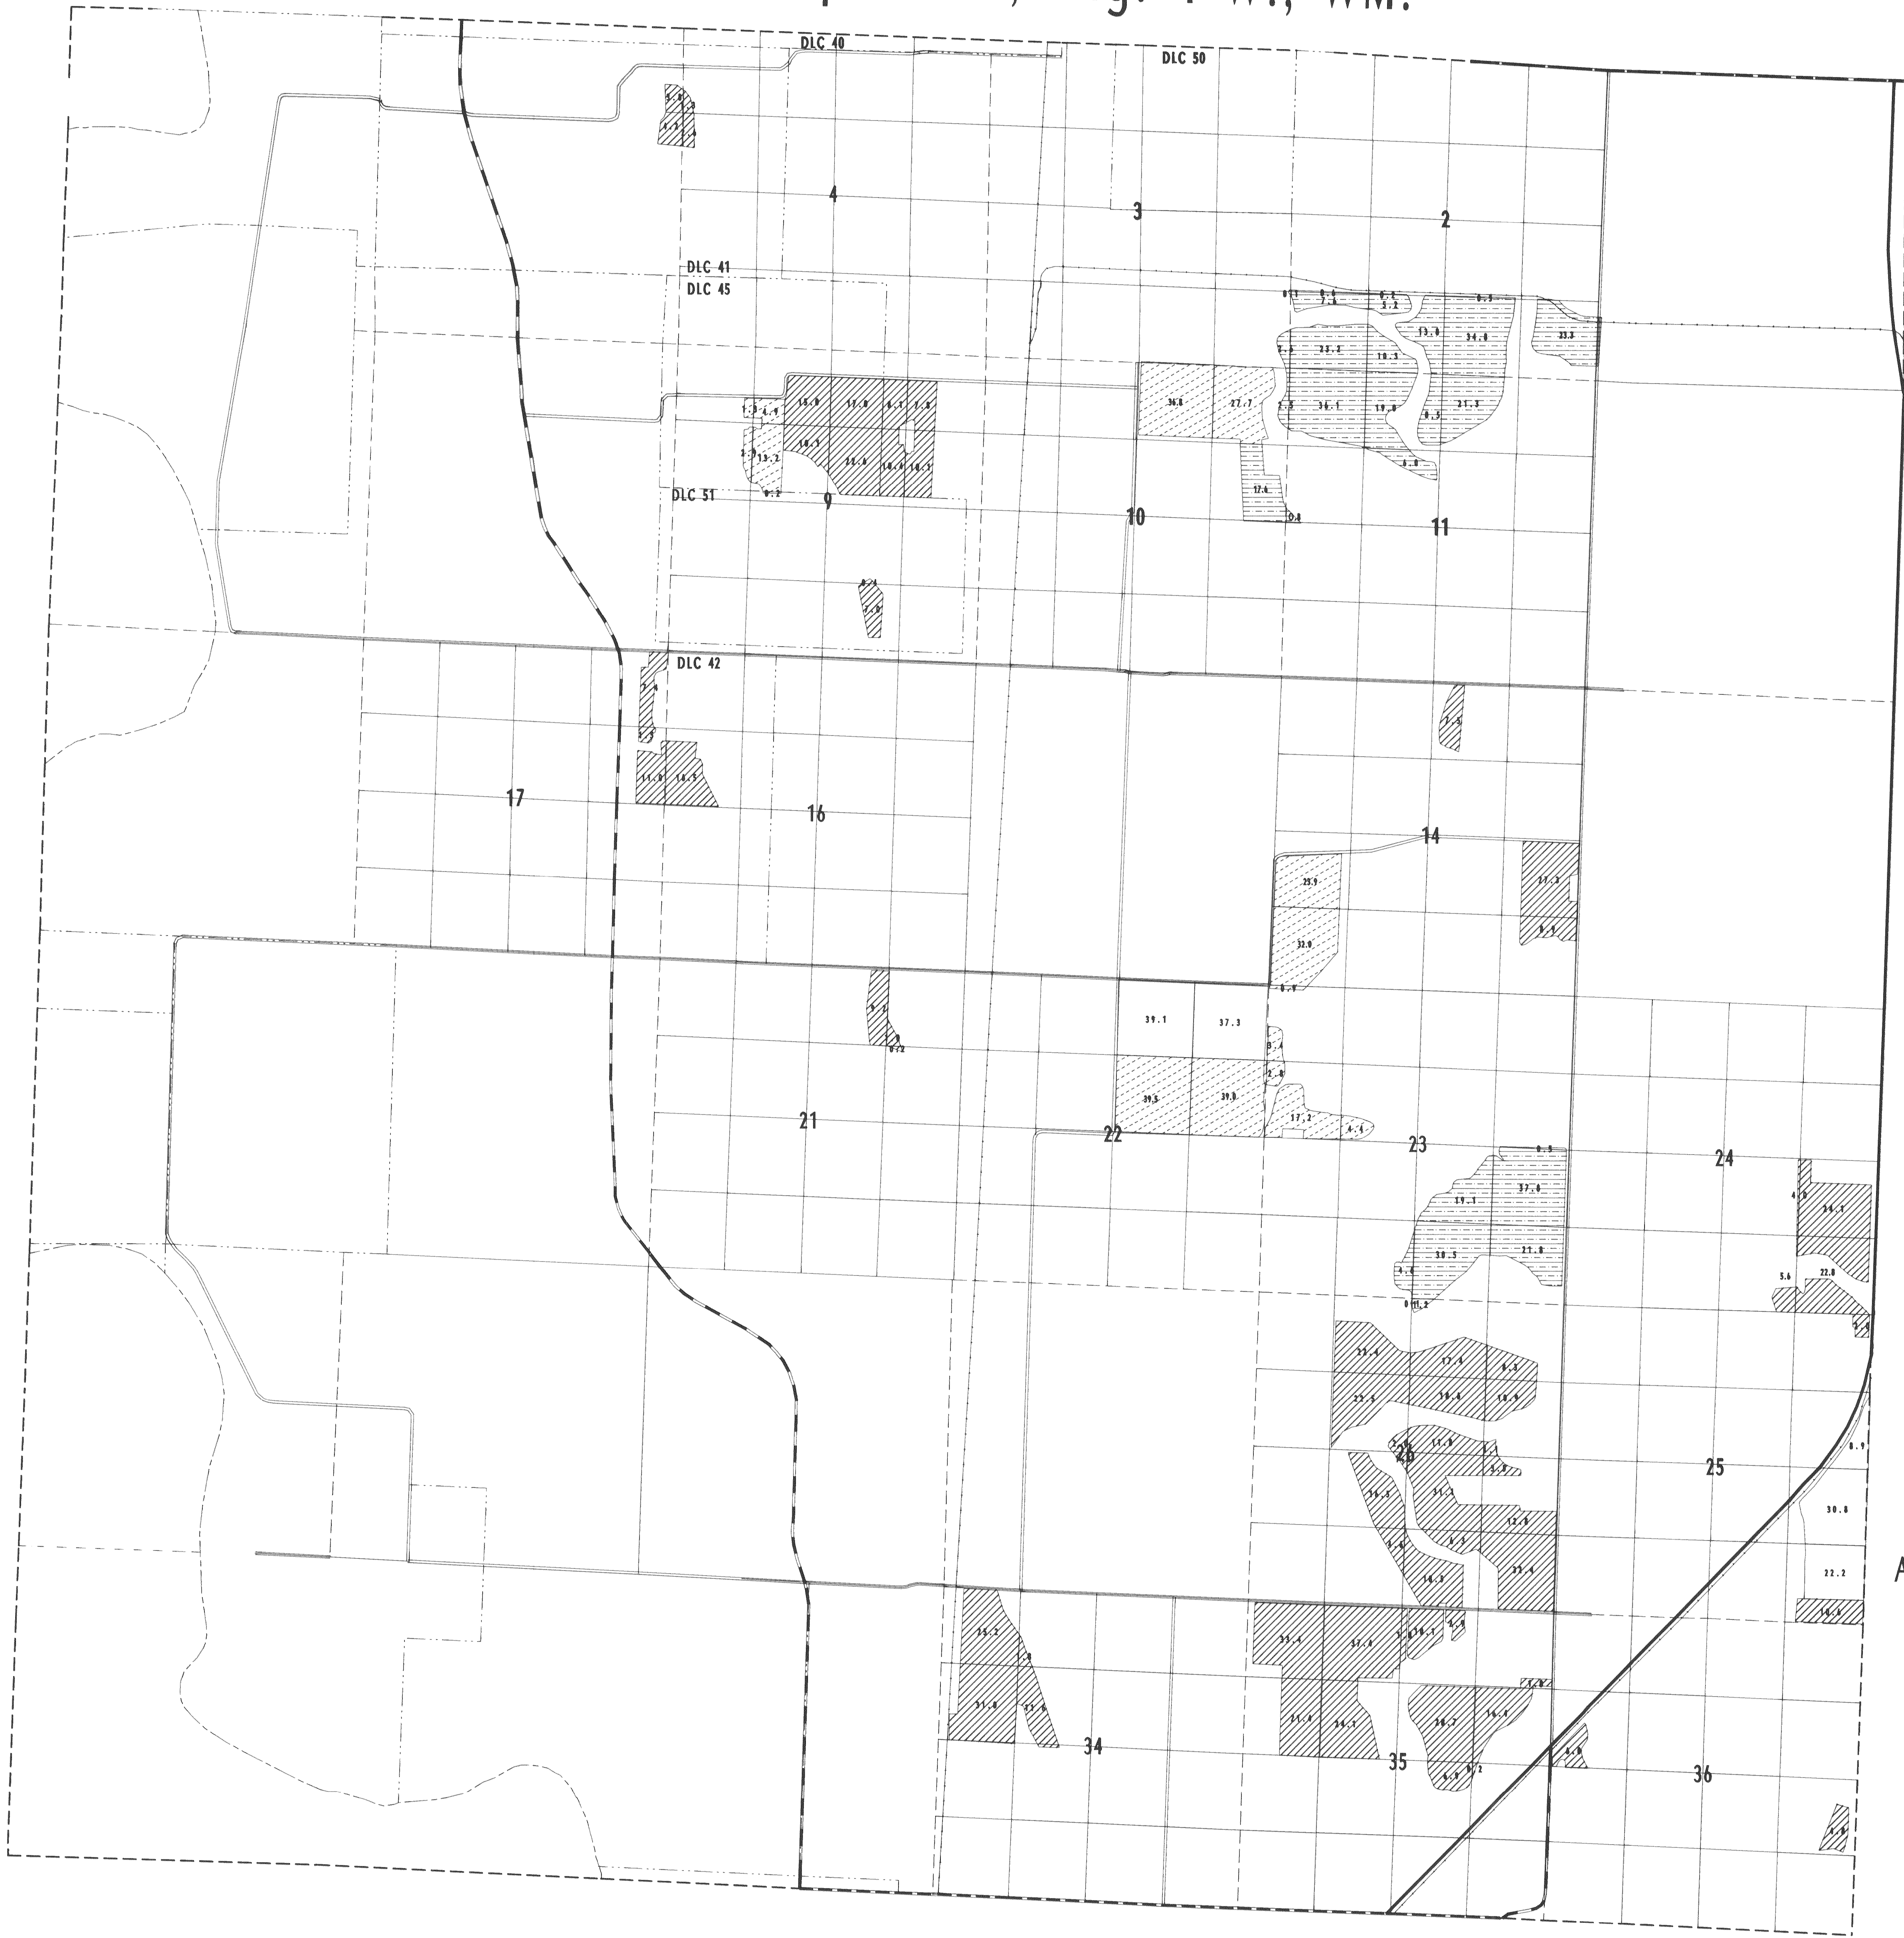

LEGEND

- Permit 50921
- Permit 37877
- Permit 42759
- Permit 43710
- Permit 45980
- Certificate 51599
- Certificate 62148
- Certificate 62781



SCALE 1" = 1320'

FINAL PROOF SURVEY
UNDER

Application	49527	Permit	37877
	55400		42759
	57947		43710
	58932		45980
	68824		50921


IN NAME OF
MUDDY CREEKS IRRIGATION PROJECT

Surveyed 1993 By R.W.Klassen

Twp. 15 S., Rng. 3 W., WM.

LEGEND

- Permit 50921
- Permit 37877
- Permit 42759
- Permit 43710
- Permit 45980
- Certificate 51599
- Certificate 62148
- Certificate 62281

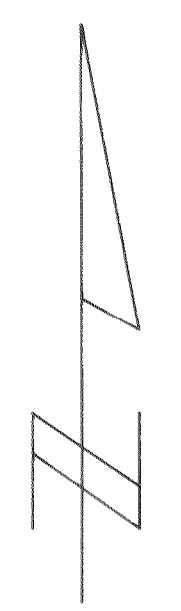

SCALE 1"= 1320'

FINAL PROOF SURVEY

UNDER

Application 49527	Permit 37877
55400	42759
57947	43710
58932	45980
68824	50921

IN NAME OF

MUDDY CREEKS IRRIGATION PROJECT

Surveyed 1993 By R.W.Klassen

\\servername\public\1994_1\05 PM
Platfiles\arcdata\work\ar\lens\m153w-fp

Twp. 15 S., Rng. 4 W., WM.



- LEGEND
- PERMIT 50921
 - PERMIT 50927
 - PERMIT 42759
 - PERMIT 42758
 - PERMIT 42710
 - PERMIT 43880




SCALE 1" = 1320'

FINAL PROOF SURVEY
UNDER

Application 49527 Permit 37877
55400 42759
57947 43710
58932 45980
68824 50921

IN NAME OF
MUDDY CREEKS IRRIGATION PROJECT
Surveyed 1993 By R.W.Klassen

Twp. 16 S., Rng. 3 W., WM.

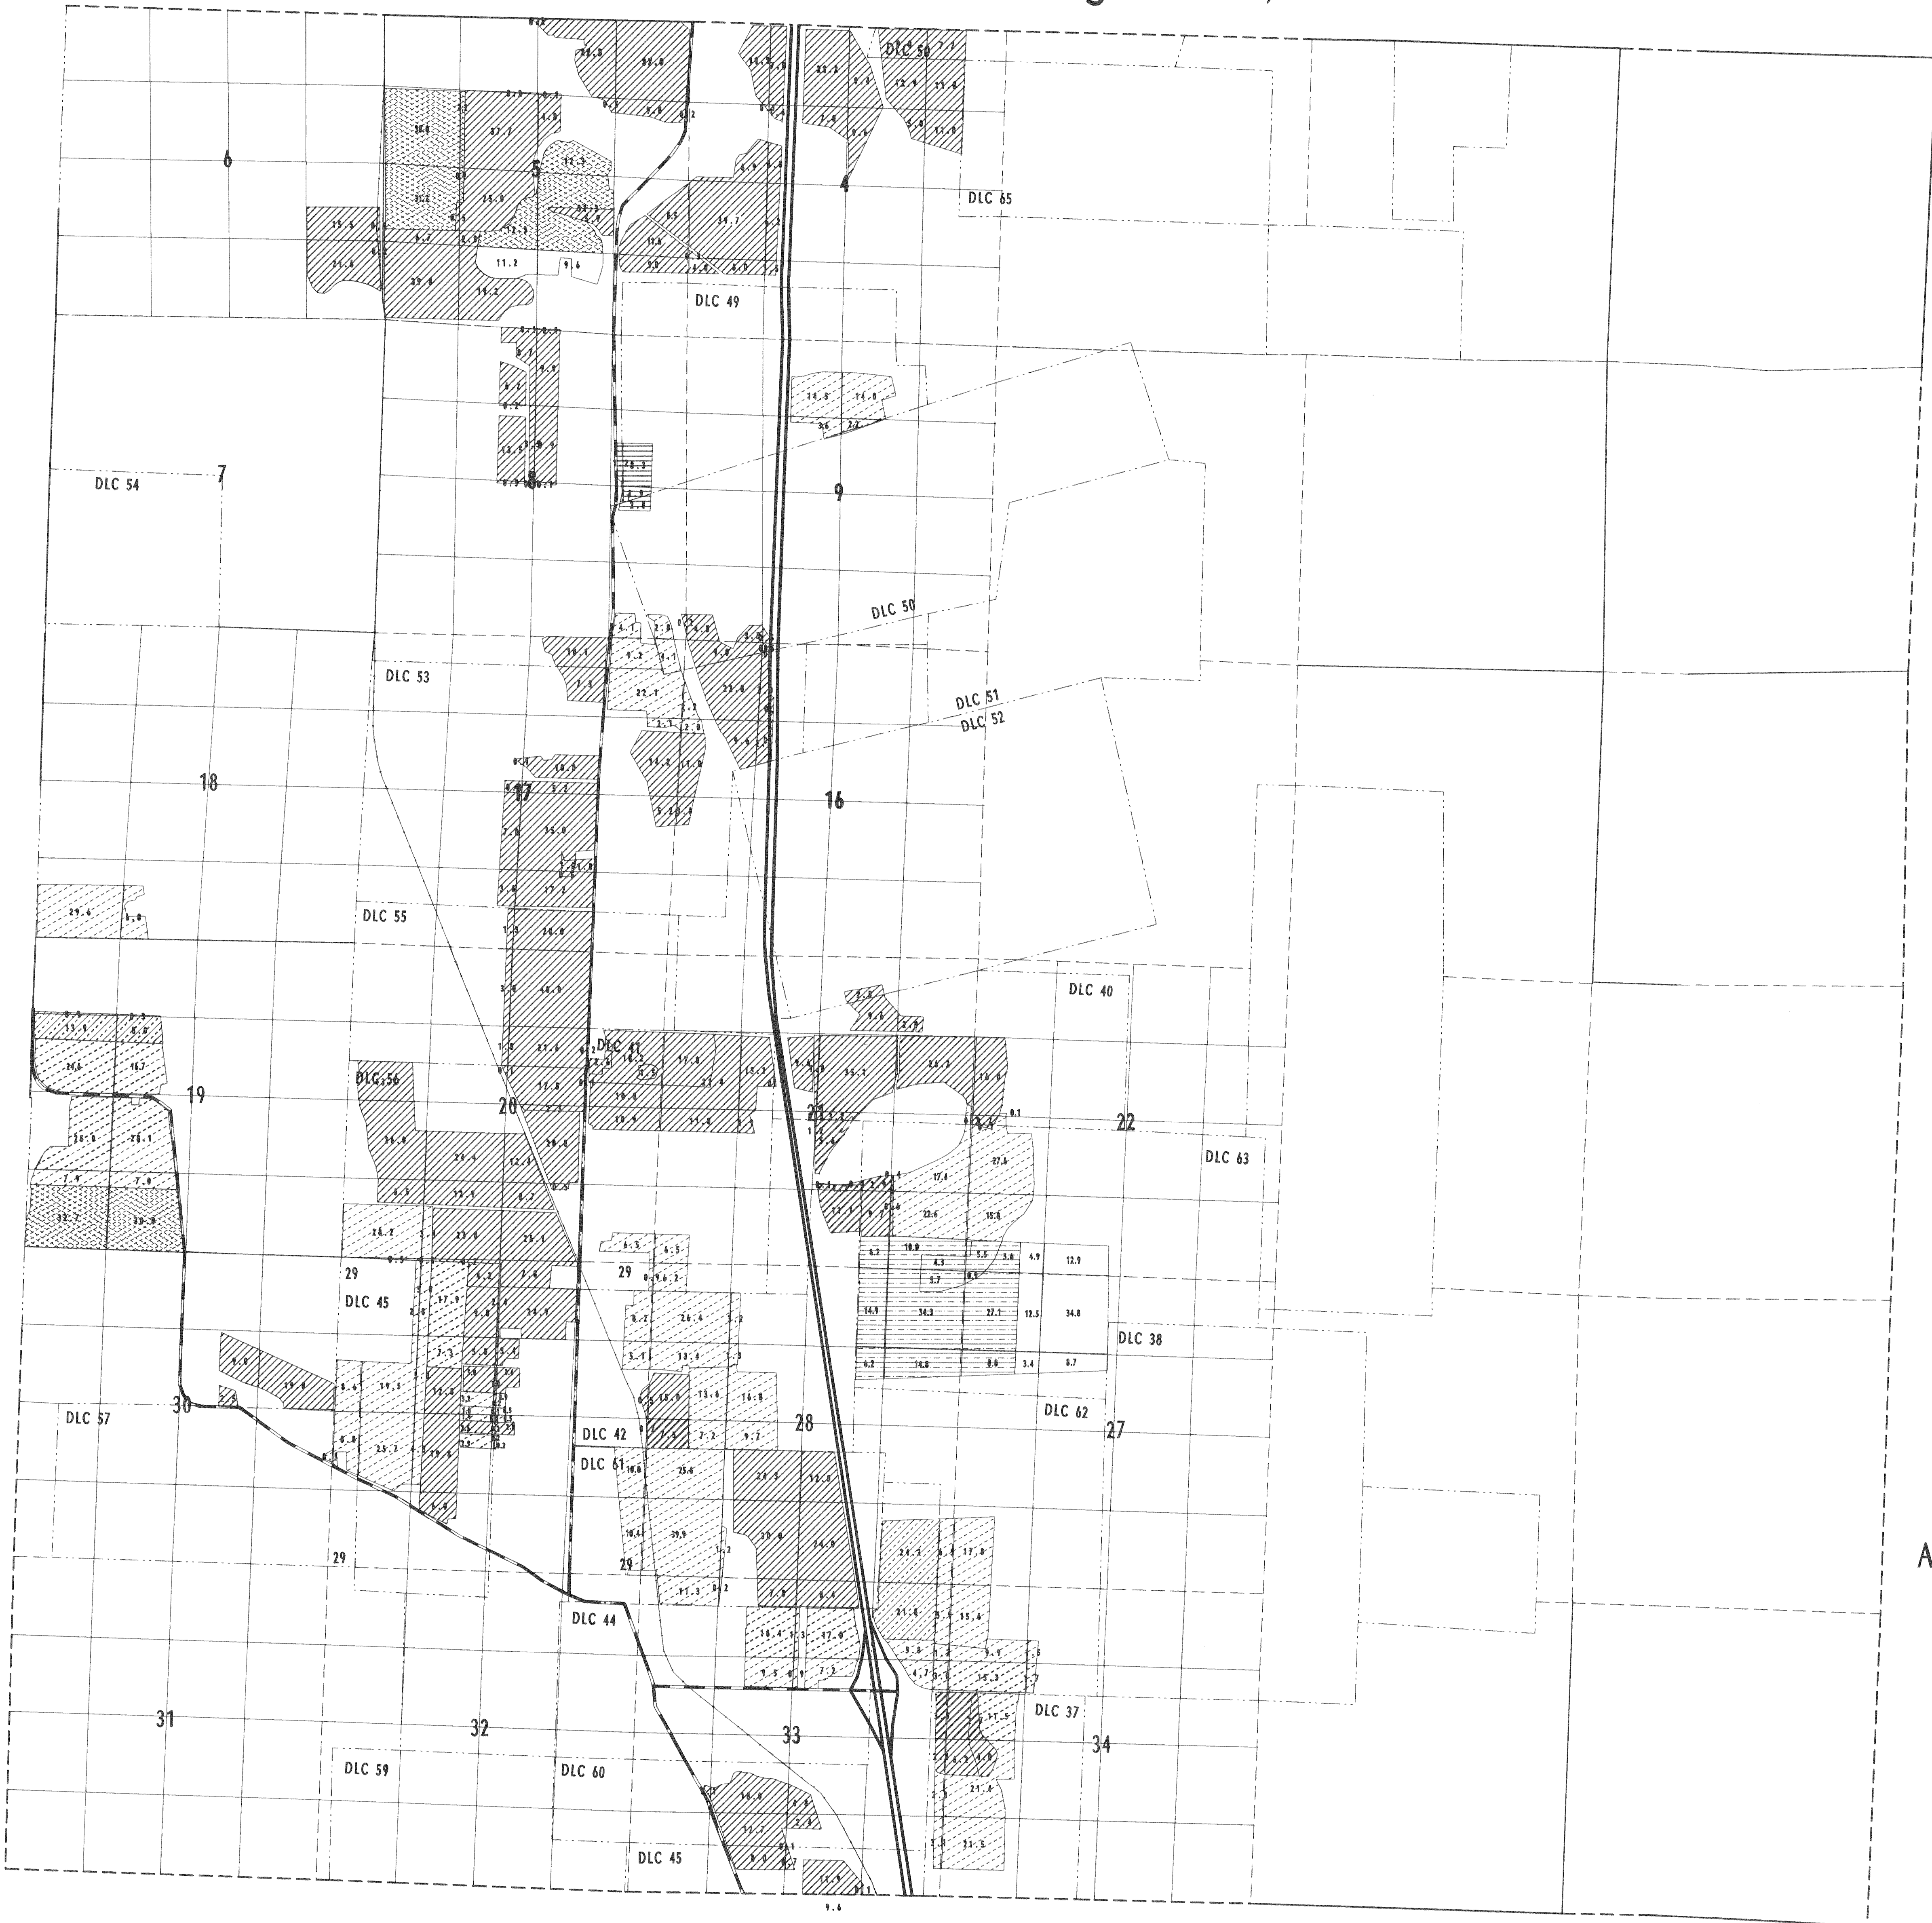

LEGEND

	Permit 50921
	Permit 37877
	Permit 42759
	Permit 43710
	Permit 45980
	Certificate 51599
	Certificate 62148
	Certificate 62281



SCALE 1" = 1320'

FINAL PROOF SURVEY

UNDER

Application	49527	Permit	37877
	55400		42759
	57947		43710
	58932		45980
	68824		50921

IN NAME OF
MUDDY CREEKS IRRIGATION PROJECT


Surveyed 1993 By R.W.Klassen

```

Username: seuterik
Date/Time: 4/11/1994 4:05 PM
Plotfile: /srcdata/iswork/wr/lane/ml6s3w-fg

```


Twp. 16 S., Rng. 4 W., WM.

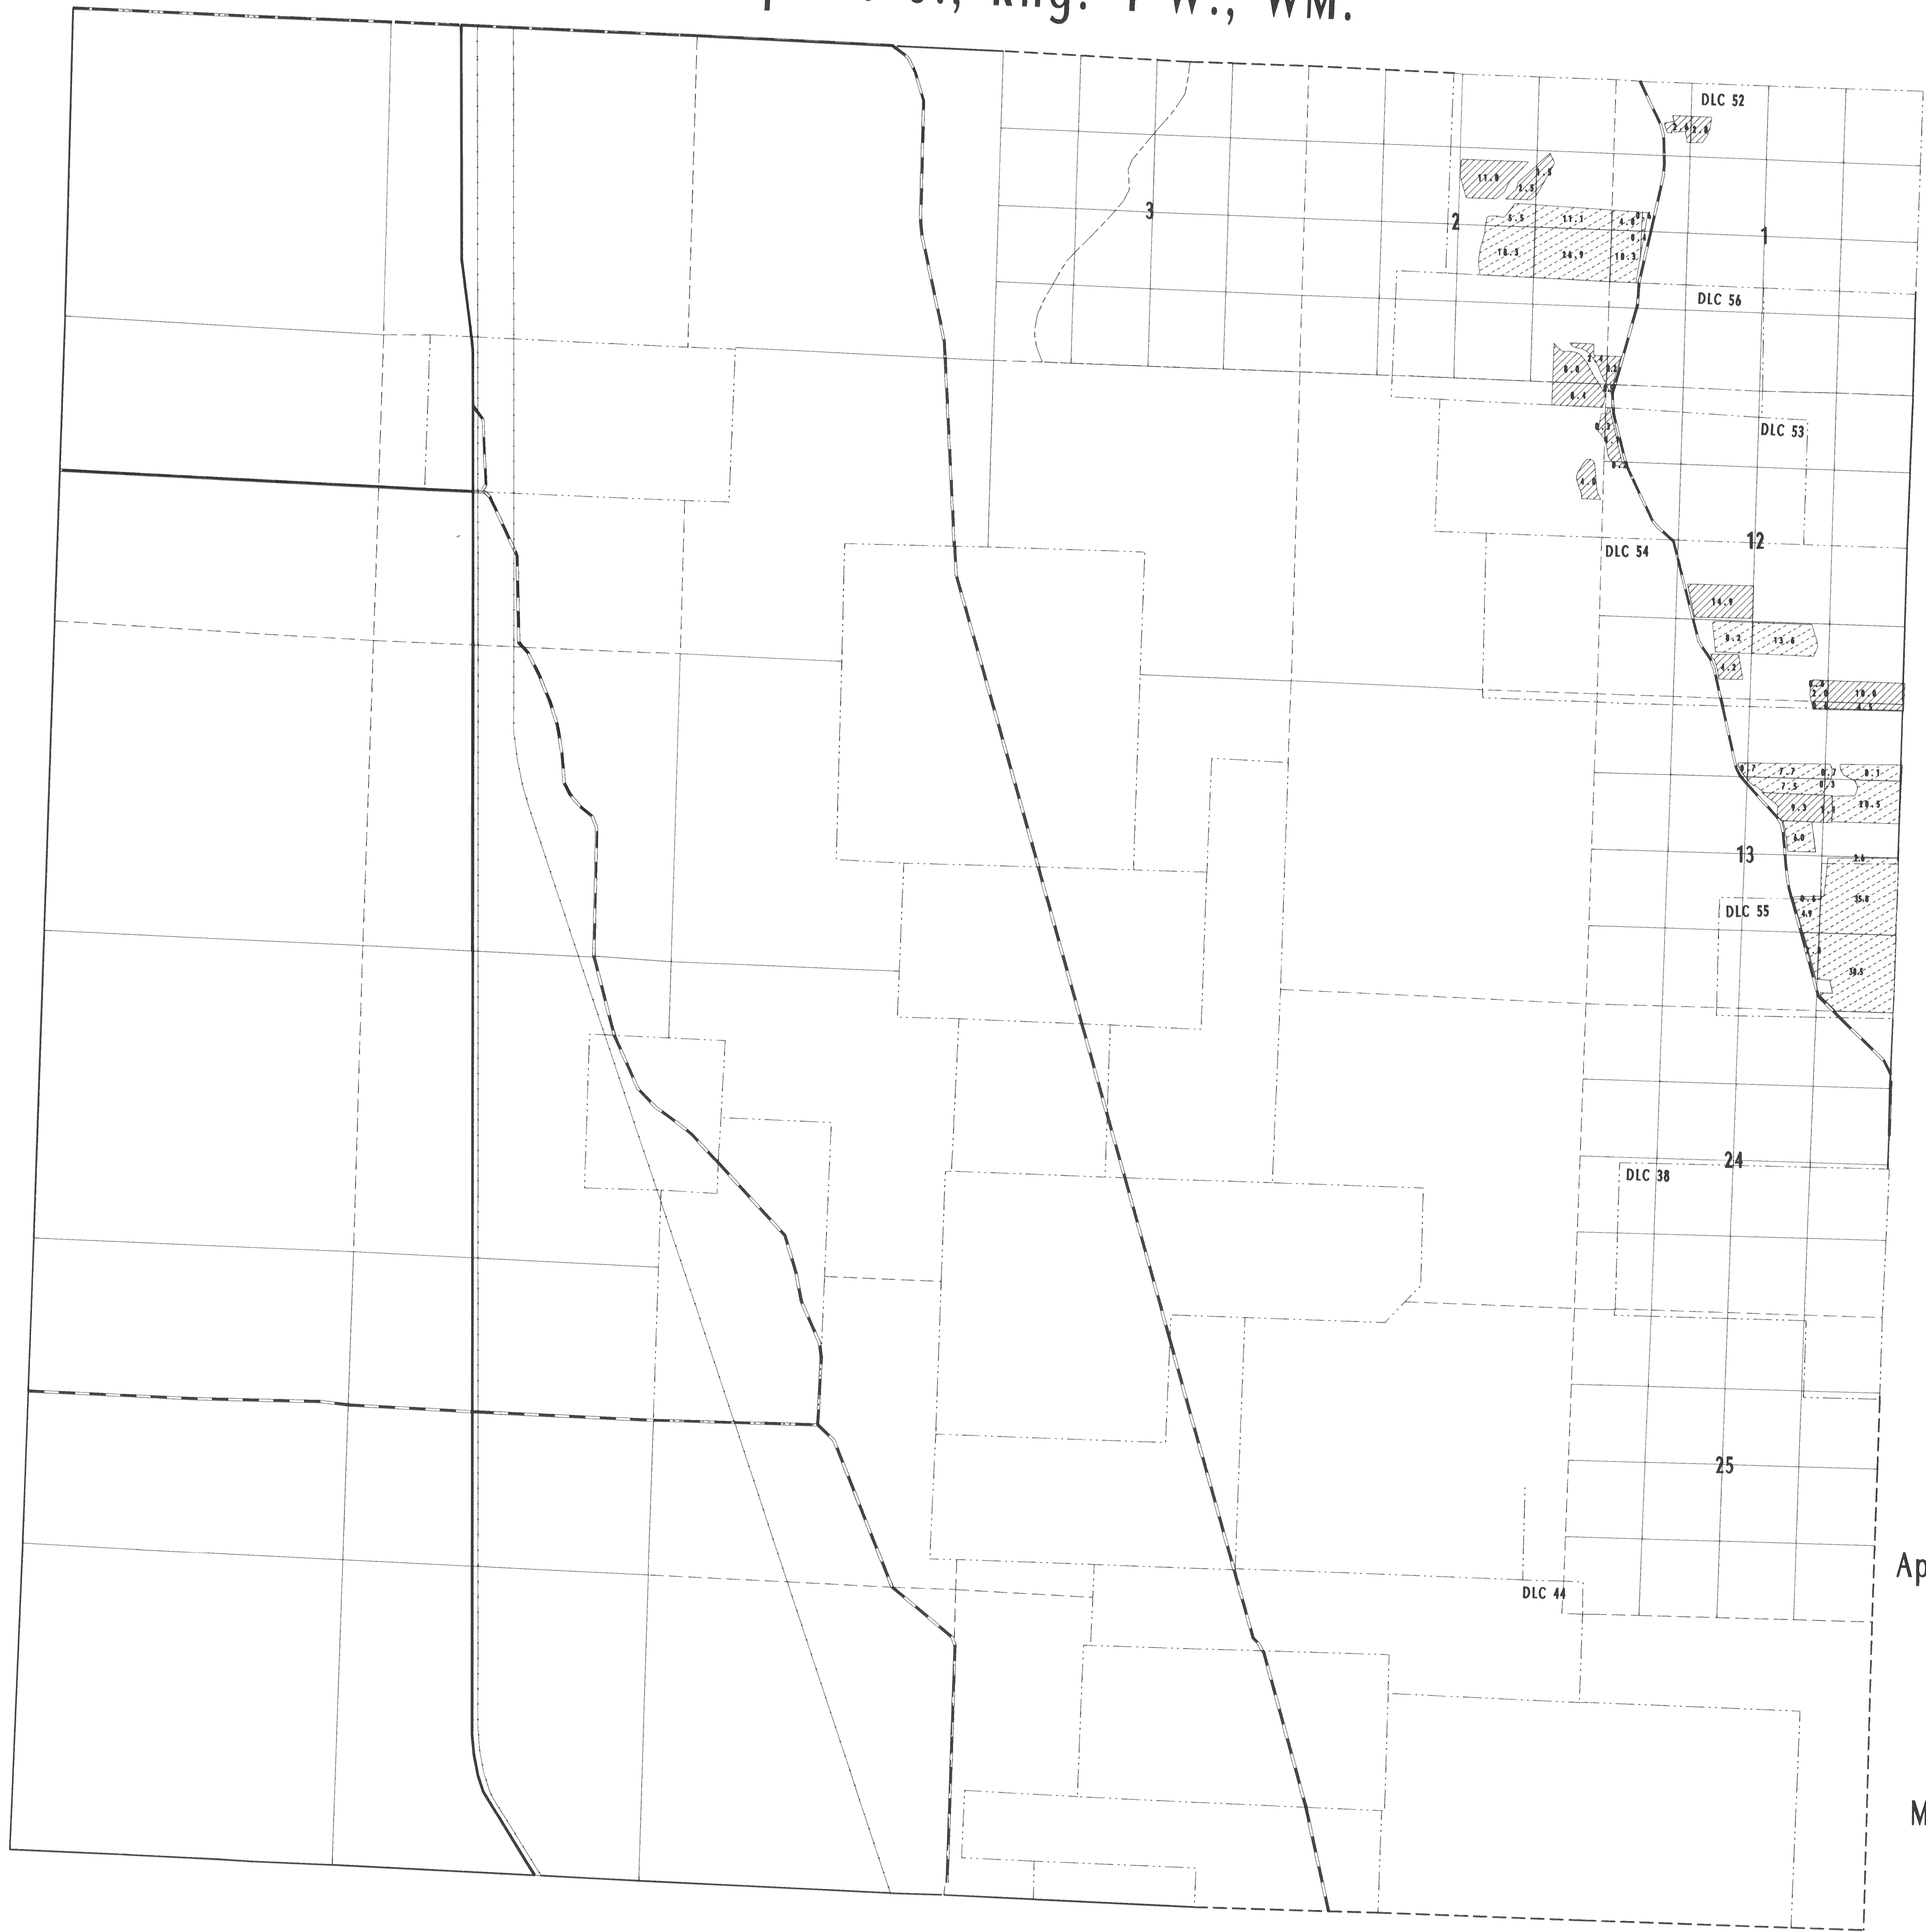

LEGEND

- Permit 50921
- Permit 37877
- Permit 42759
- Permit 43710
- Permit 45980
- Certificate 51598
- Certificate 62148
- Certificate 63281



SCALE 1"= 1320'

FINAL PROOF SURVEY


UNDER

Application 49527	Permit 37877
55400	42759
57947	43710
58932	45980
68824	50921


IN NAME OF
MUDDY CREEKS IRRIGATION PROJECT

Surveyed 1993 By R.W.Klassen

Twp. 17 S., Rng. 3 W., WM.

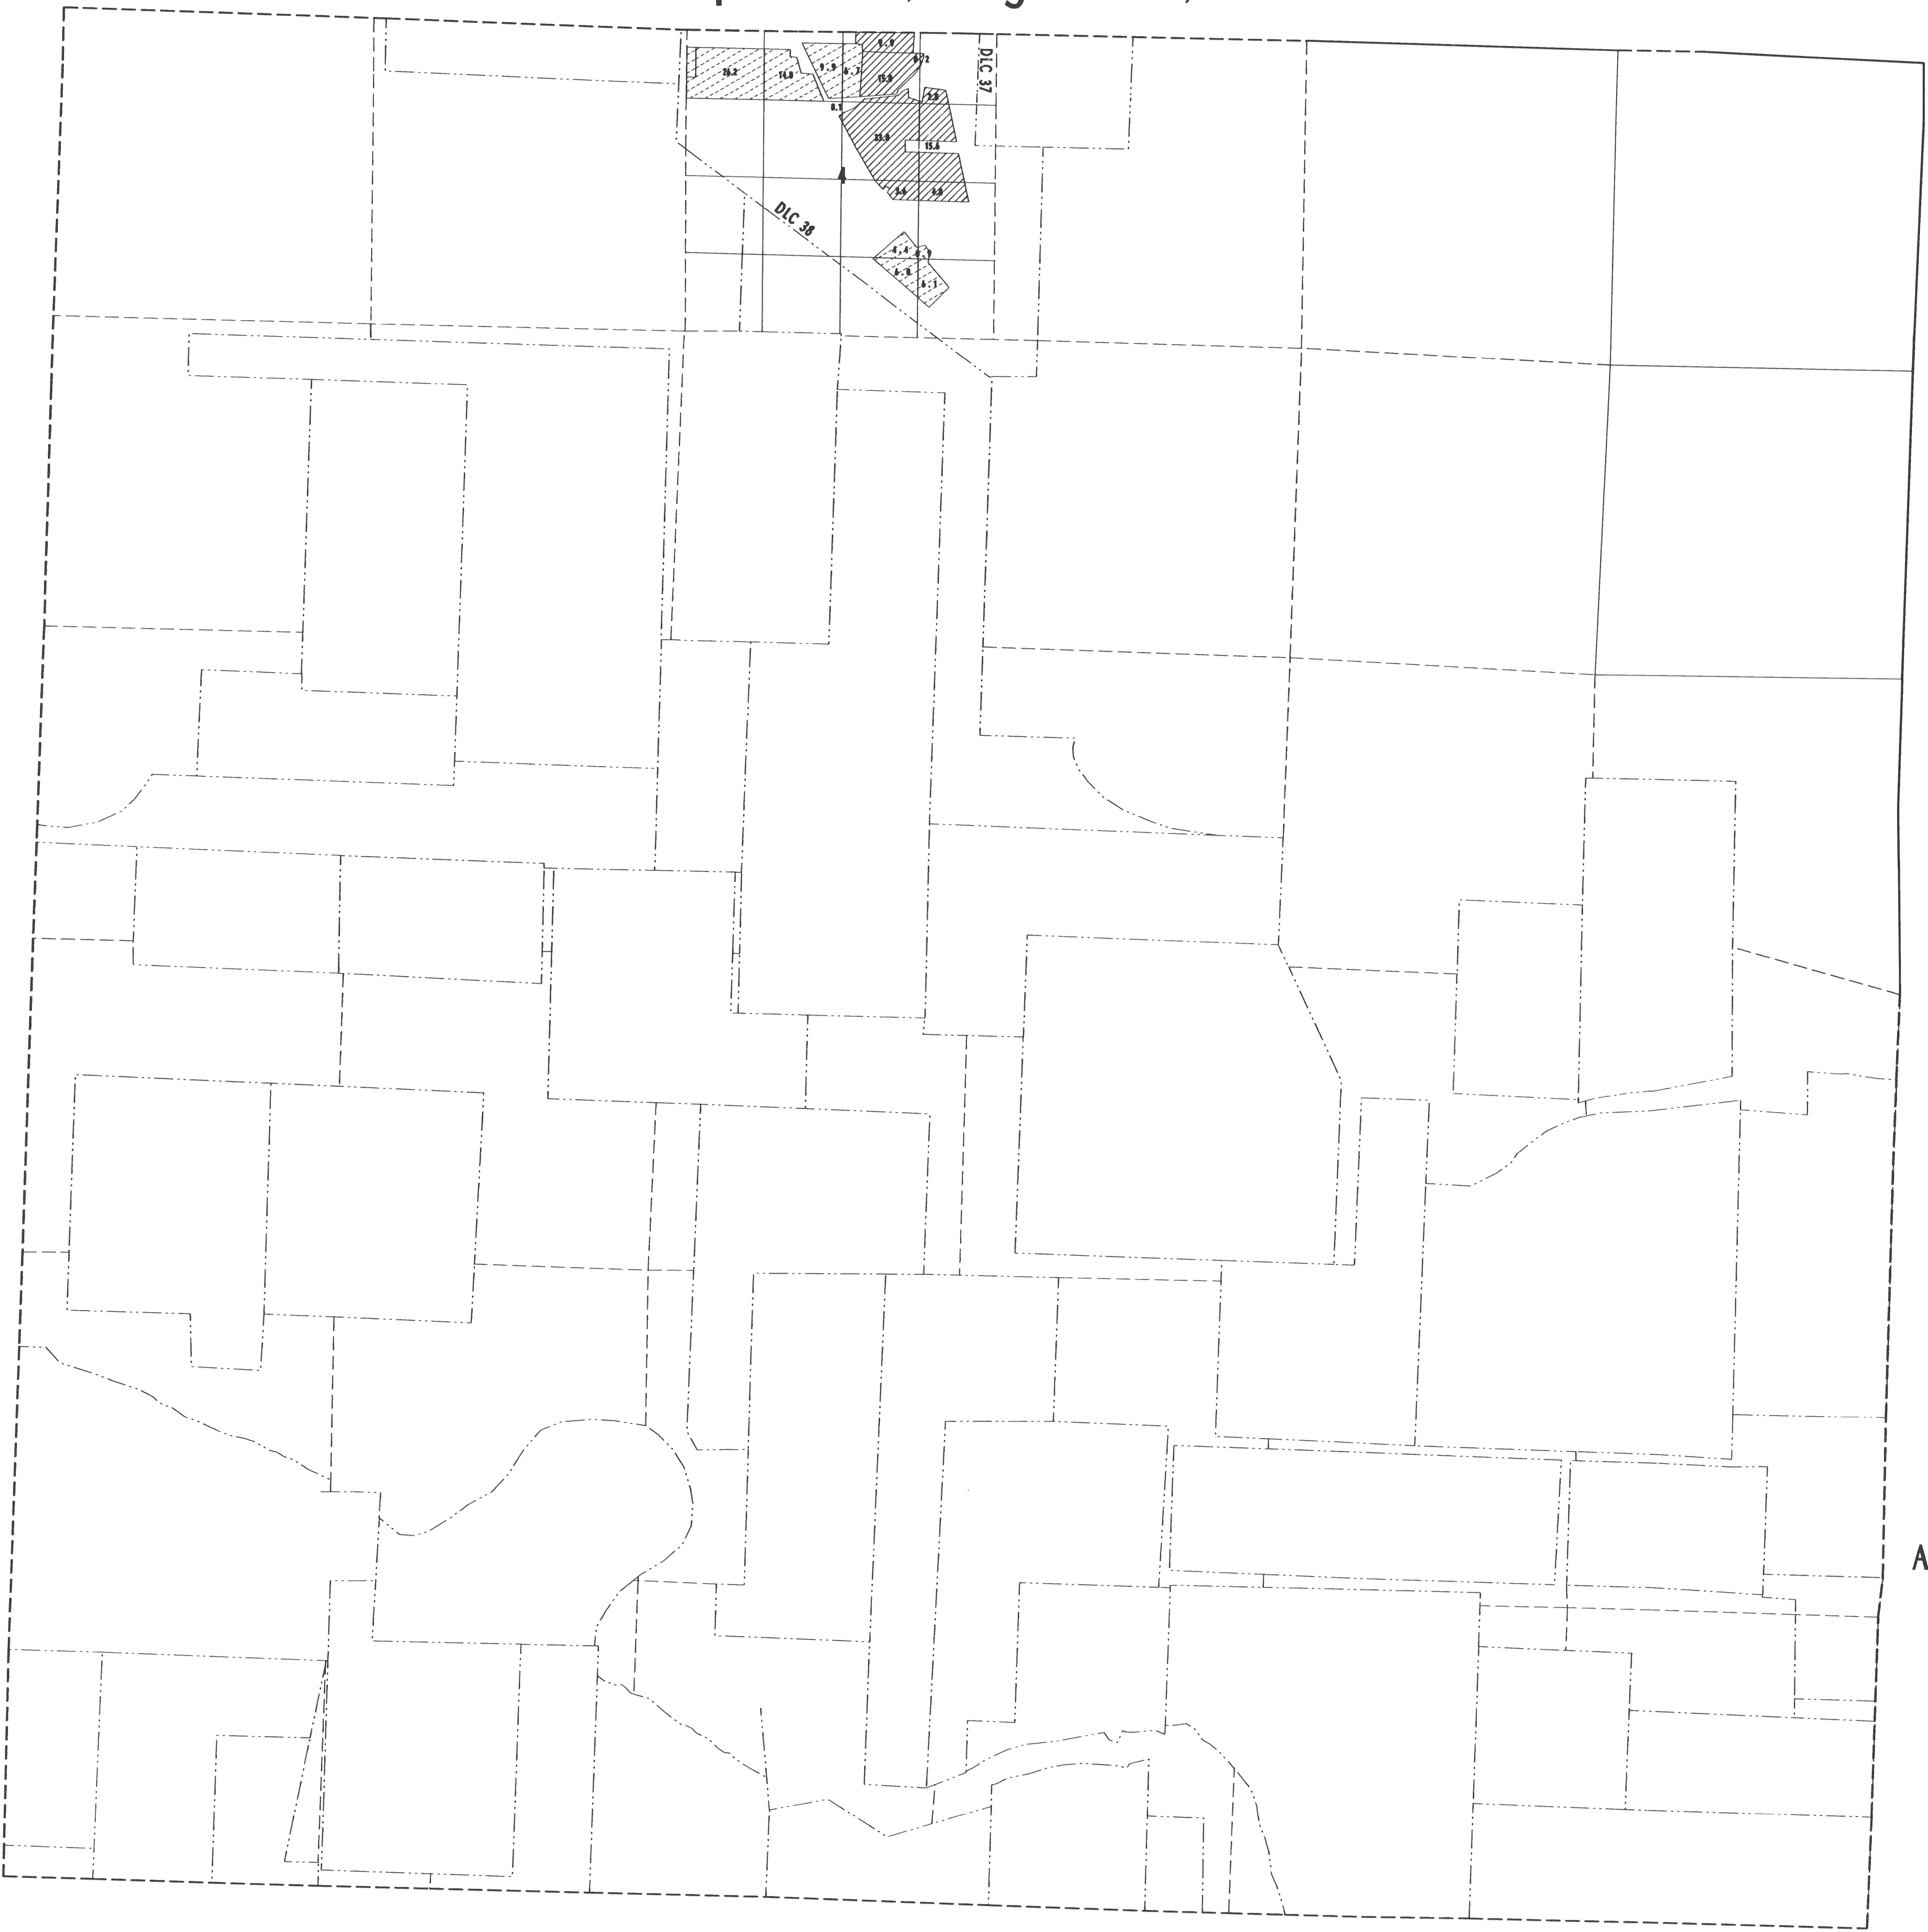

- LEGEND
- Permit 50921
 - Permit 37877
 - Permit 42759
 - Permit 43710
 - Permit 45980
 - Certificate 51599
 - Certificate 62148
 - Certificate 62281

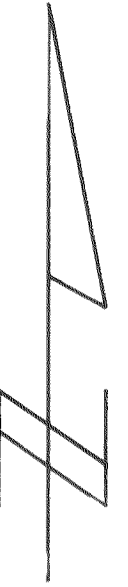

SCALE 1"= 1320'

FINAL PROOF SURVEY

UNDER

Application 49527	Permit 37877
55400	42759
57947	43710
58932	45980
68824	50921

IN NAME OF
MUDDY CREEKS IRRIGATION PROJECT

Surveyed 1993 By R.W.Klassen