

KNEE DEEP CATTLE COMPANY

TRANSFER APPLICATION MAP EXISTING PLACE OF USE

JUNE 3, 2021


TAXLOTS 100, 101, & 700 MAP 160328

LOCATED IN
SECTION 28, TOWNSHIP 16 SOUTH, RANGE 3 WEST, W.M.
LANE COUNTY, OREGON



RENEWS:

RECEIVED
JUL 29 2021
OWRD

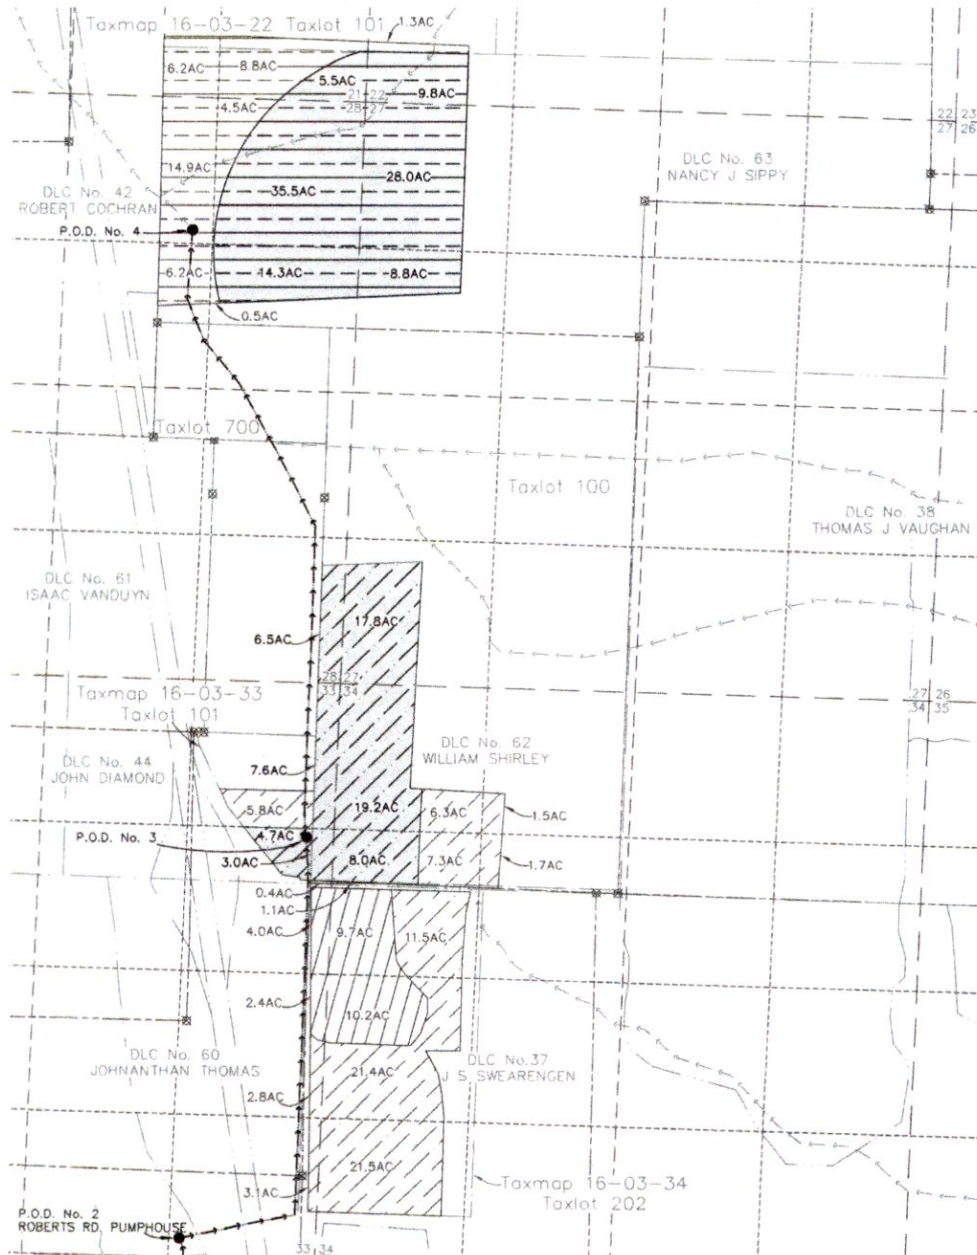

LEGEND

- TAXLOT BOUNDARY
- SECTION BOUNDARY
- 1/4 SECTION BOUNDARY
- 1/4 1/4 SECTION BOUNDARY
- ROADS
- EXISTING DITCH WITH FLOW DIRECTION
- MIKE STEVENSON IRRIGATION CANAL
- DLC BOUNDARY
- ⊗ DLC CORNER MONUMENT
- POINT OF DIVERSION (PUMP)
- 0.00 AC AREA TO BE TRANSFERRED
- 0.00 AC AREA TO REMAIN AS IS

MAP DEVELOPED USING LANE COUNTY GIS AND TAXMAPS. NO FIELD SURVEY WAS CONDUCTED. THIS IS NOT INTENDED TO PROVIDE LEGAL DIMENSIONS OR LOCATION OF PROPERTY OWNERSHIP LINES.

SCALE 1" = 1320'

HATCH	CERT#	AREA	REPRESENTING AREA
---	91761	42.4	TO BE TRANSFERRED
---	91761	101.9	TO REMAIN AS IS
---	80835	82.9	TO BE TRANSFERRED
---	80835	66.8	TO REMAIN AS IS
---	86338	27.8	TO BE TRANSFERRED

JDMcGee, Inc.

Engineering & Surveying 1215 Main Street
Land Use Planning PO Box 1472
Wastewater Design Philomath, OR 97370
"Solving Problems for You" (541) 929-4226
(541) 929-4227 Fax

DRAWN BY: CRM
JDM PROJECT #: 21-34

CHECKED BY: JDM

13782


KNEE DEEP CATTLE COMPANY

TRANSFER APPLICATION MAP PROPOSED PLACE OF USE

JUNE 3, 2021

TAXLOTS 100, 101, & 700 MAP 160328

LOCATED IN
SECTION 28, TOWNSHIP 16 SOUTH, RANGE 3 WEST, W.M.
LANE COUNTY, OREGON

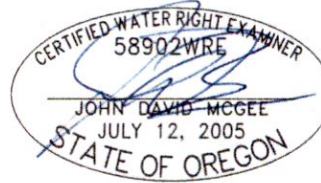


RENEWS:

RECEIVED

JUL 29 2021

OWRD

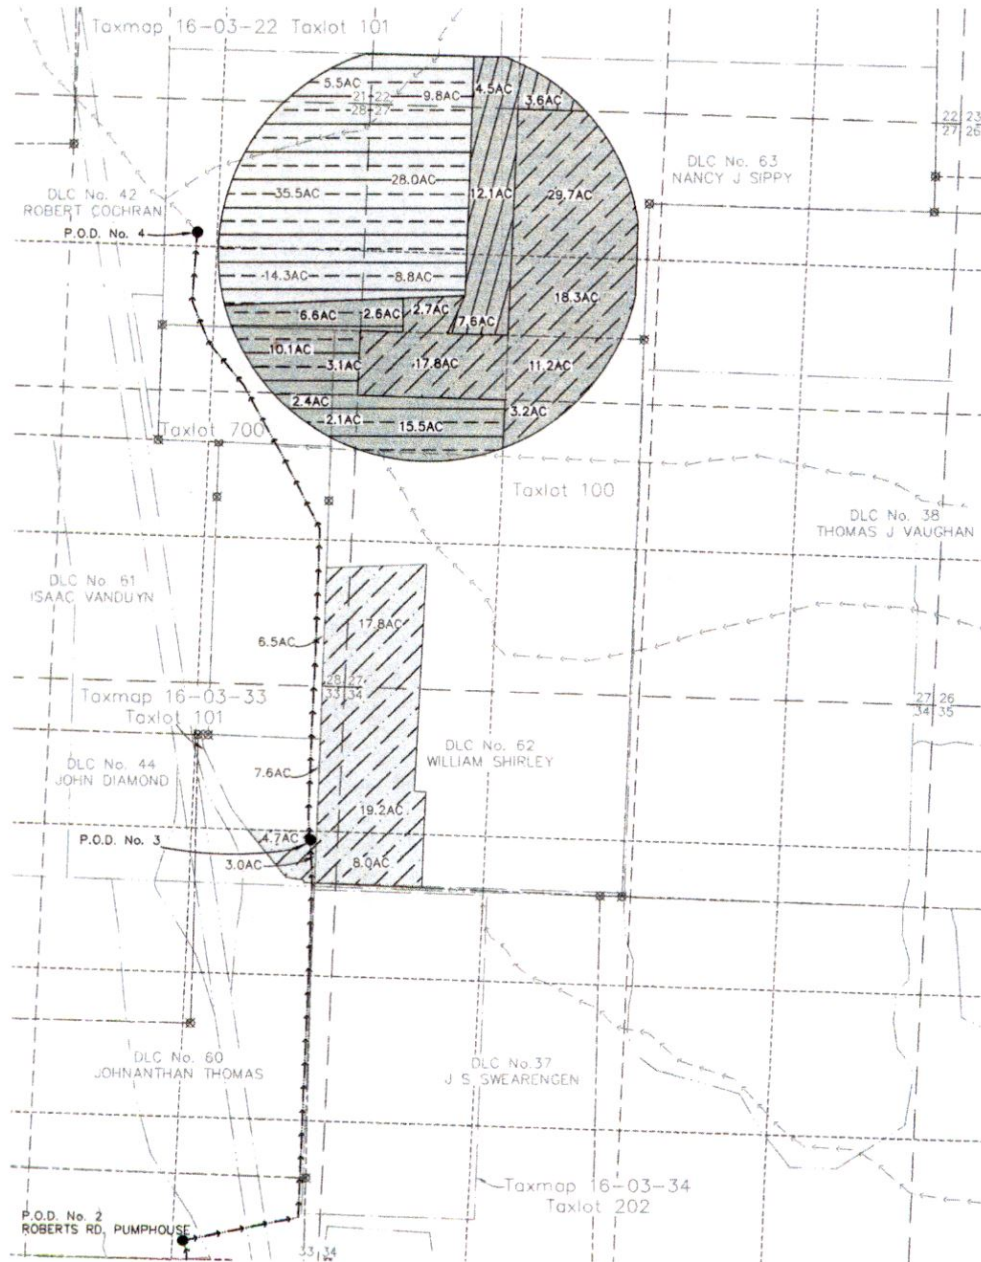

LEGEND

- TAXLOT BOUNDARY
- SECTION BOUNDARY
- 1/4 SECTION BOUNDARY
- 1/4 1/4 SECTION BOUNDARY
- ROADS
- EXISTING DITCH WITH FLOW DIRECTION
- MIKE STEVENSON IRRIGATION CANAL
- DLC BOUNDARY
- DLC CORNER MONUMENT
- PUMP
- 0.00 AC AREA TO BE TRANSFERRED
- 0.00 AC AREA TO REMAIN AS IS

MAP DEVELOPED USING LANE COUNTY GIS AND TAXMAPS. NO FIELD SURVEY WAS CONDUCTED. THIS IS NOT INTENDED TO PROVIDE LEGAL DIMENSIONS OR LOCATION OF PROPERTY OWNERSHIP LINES.

HATCH	CERT#	AREA	REPRESENTING AREA
	91761	101.9	TO REMAIN AS IS
	91761	42.4	PROPOSED
	80835	66.8	TO REMAIN AS IS
	80835	82.9	PROPOSED
	86338	27.8	PROPOSED

JDMcGee, Inc.


Engineering & Surveying 1215 Main Street
"Solving Problems for You" (541) 929-4227
(541) 929-4227 Fax

DRAWN BY: CRM
JDM PROJECT #: 21-34

CHECKED BY: JDM

SCALE 1" = 1320'

T. 12 & 13 S. R. 4 W. W.M.

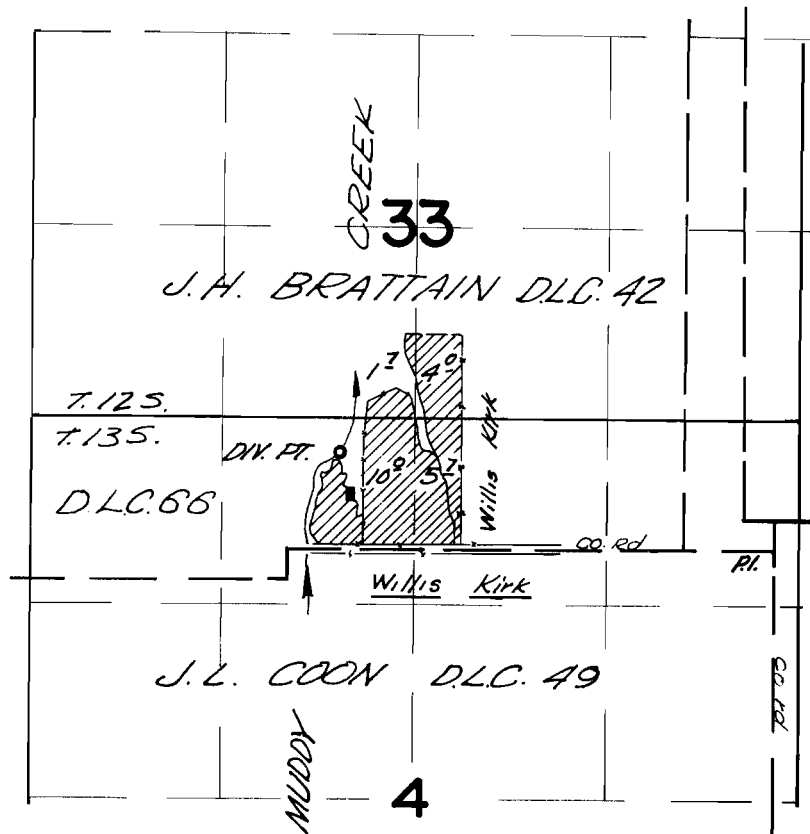

DIV. Pt. located 670 ft. N. & 2990 ft. W. from
the N. E. corner of J.L. COON D.L.C. 49


FINAL PROOF SURVEY
UNDER

Application No. 17802 Permit No. 17510
IN NAME OF

MUDDY CREEK'S IRRIGATION PROJECT

Surveyed July 26 1966, by V. GARNER

T.13S.R.4W.W.M.

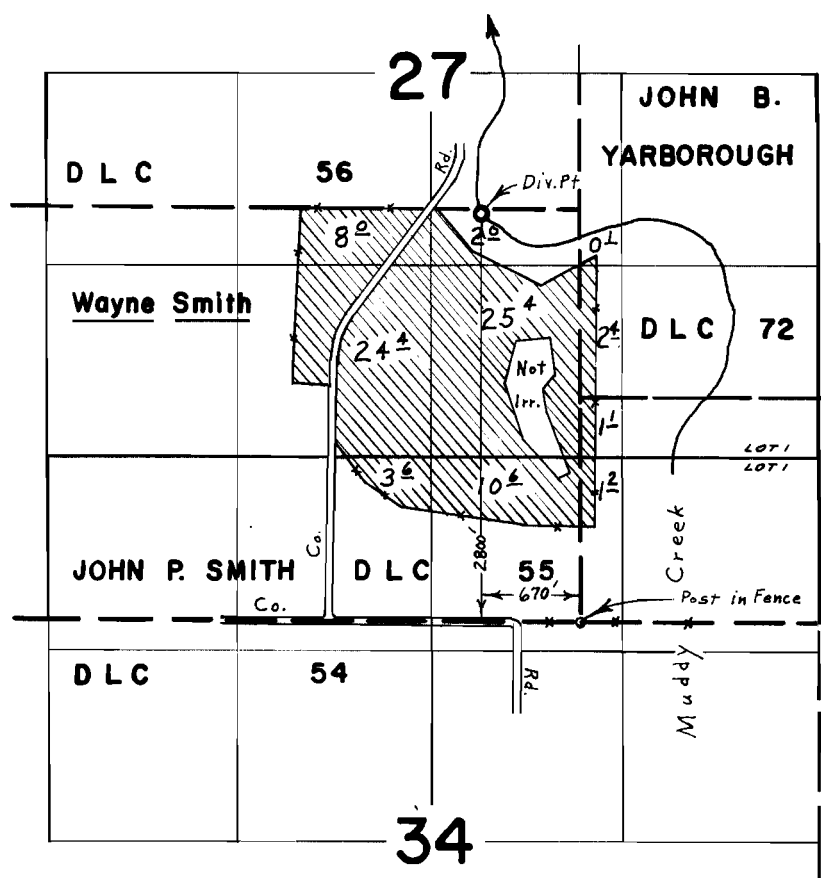


FINAL PROOF SURVEY
UNDER

Application No. 17802 Permit No. 17510
IN NAME OF
MUDDY CREEKS IRRIGATION PROJECT

Surveyed Aug. 16, 1966, by L. E. Gould

T.13 S. R.4 W. W.M.

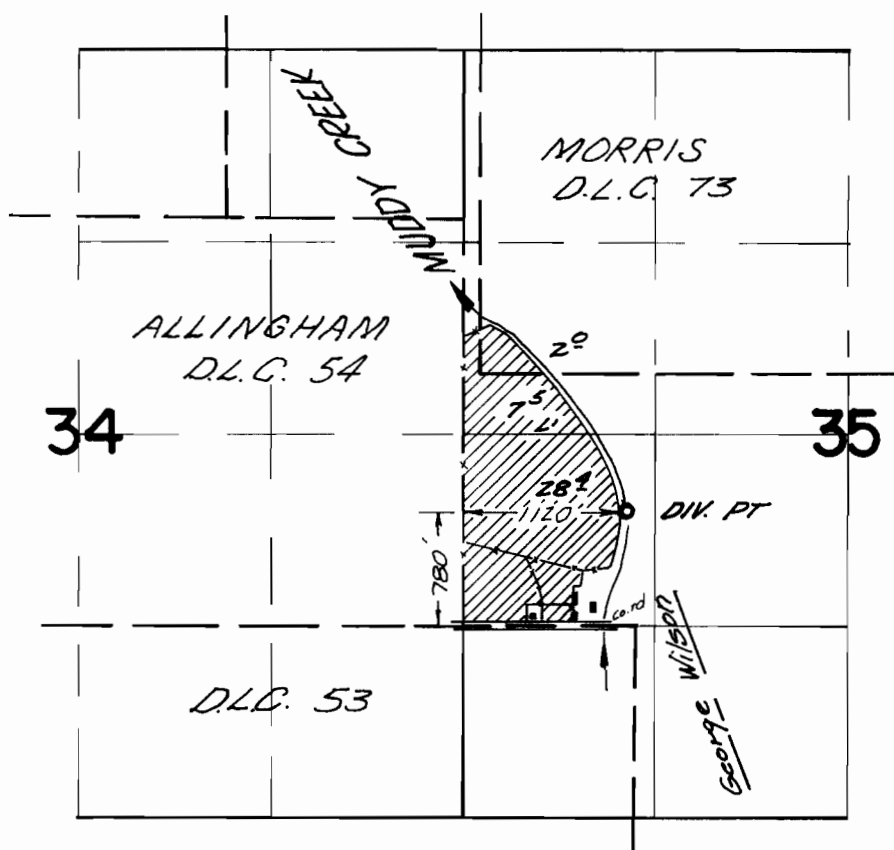


FINAL PROOF SURVEY
UNDER

Application No. 17802.. Permit No. 17510..
IN NAME OF

Muddy Creek's Irrigation Project

Surveyed May 27, 1966, by V. GARNER.

T.14 S. R.38 & 4 W. W.M.

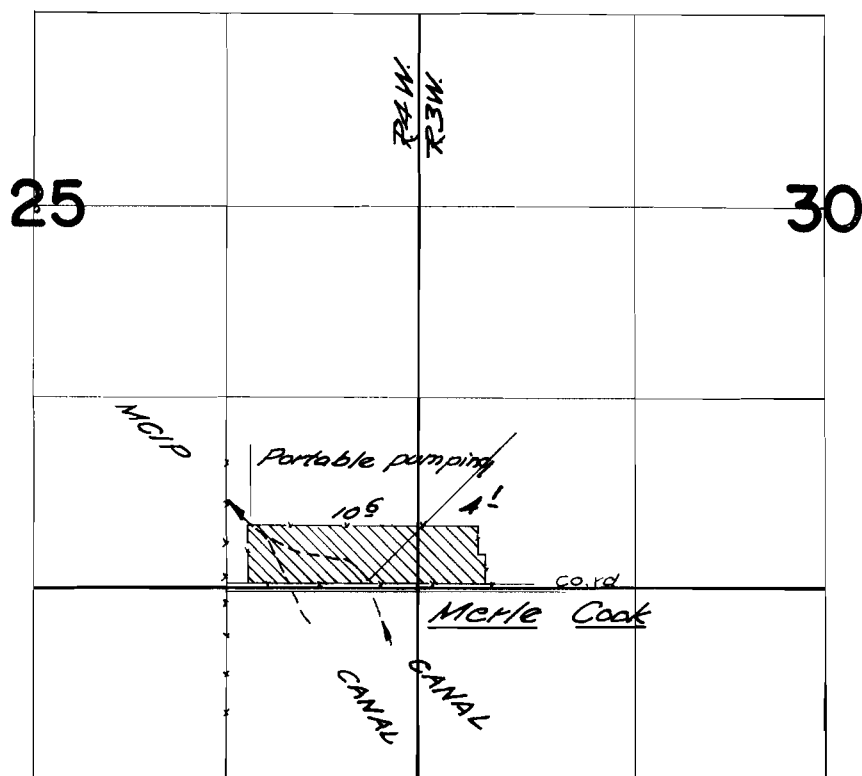


FINAL PROOF SURVEY
UNDER

Application No. 17802 Permit No. 17510
IN NAME OF

MUDDY CREEK IRRIGATION PROJECT

Surveyed June 15 1966 by V. GARNER

T.14 S. R.3 W. W.M.

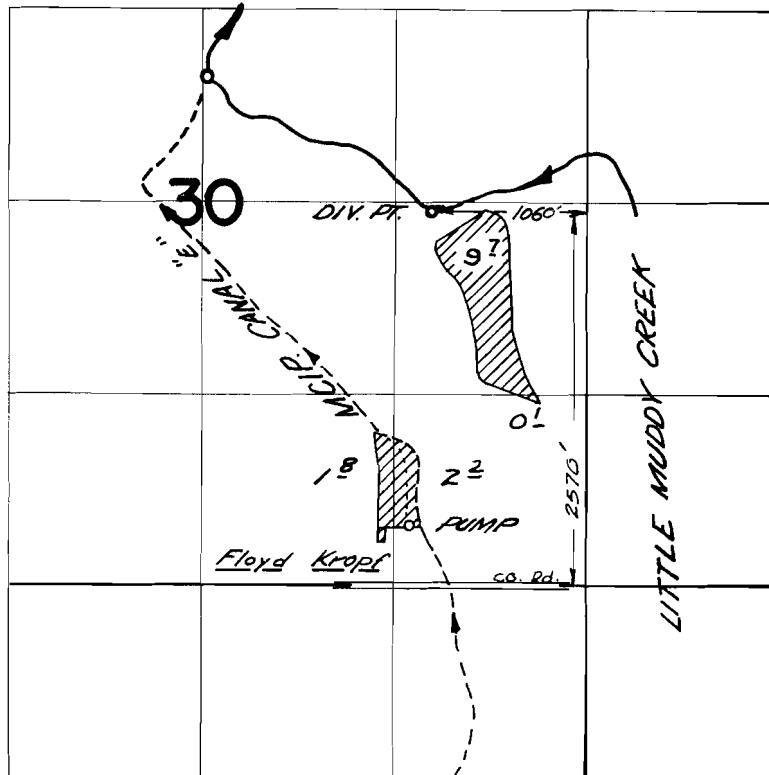


FINAL PROOF SURVEY
UNDER

Application No. 17002 Permit No. 17510
IN NAME OF

MUDY CREEK^S IRRIGATION PROJECT

Surveyed June 17, 1966, by V. GARNER

T.13 & 14 S. R.4 W. W.M.

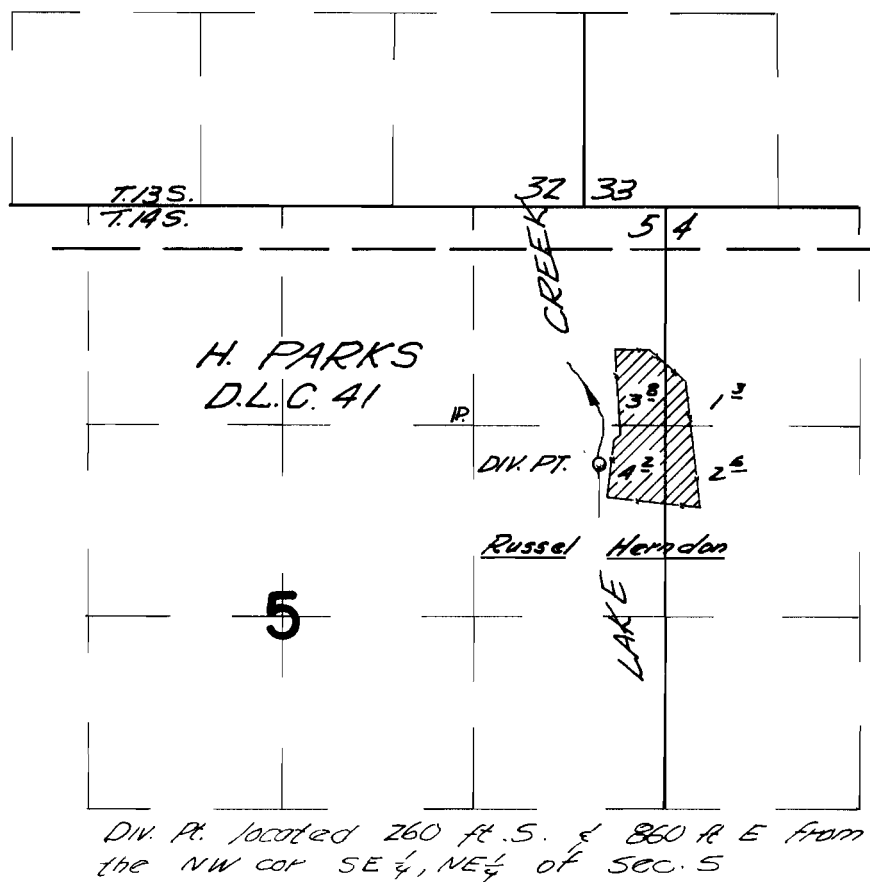


FINAL PROOF SURVEY UNDER

Application No. 17802 Permit No. 17510
IN NAME OF

MUDDY CREEK'S IRRIGATION PROJECT

Surveyed May 26 1966, by V. GARNER

T.14S.R.4W.W.M.

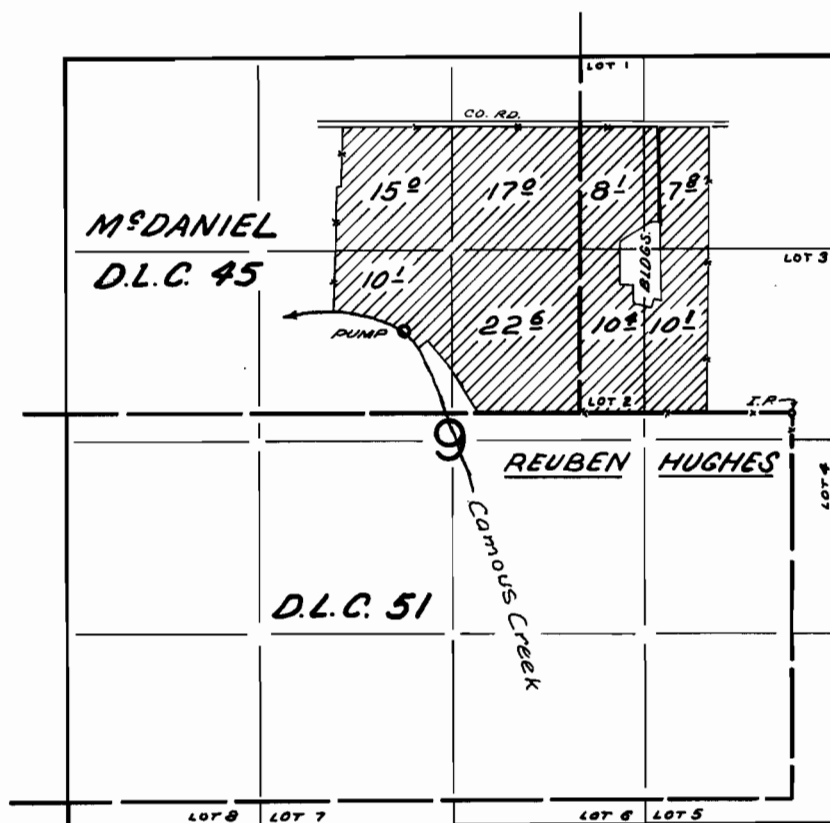


FINAL PROOF SURVEY
UNDER

Application No. 17802 Permit No. 17510
IN NAME OF

MUDDY CREEKS IRRIGATION PROJECT

Surveyed JUN. 14, 1966, by V. GARNER

T.14S. R. 4 W. W.M.

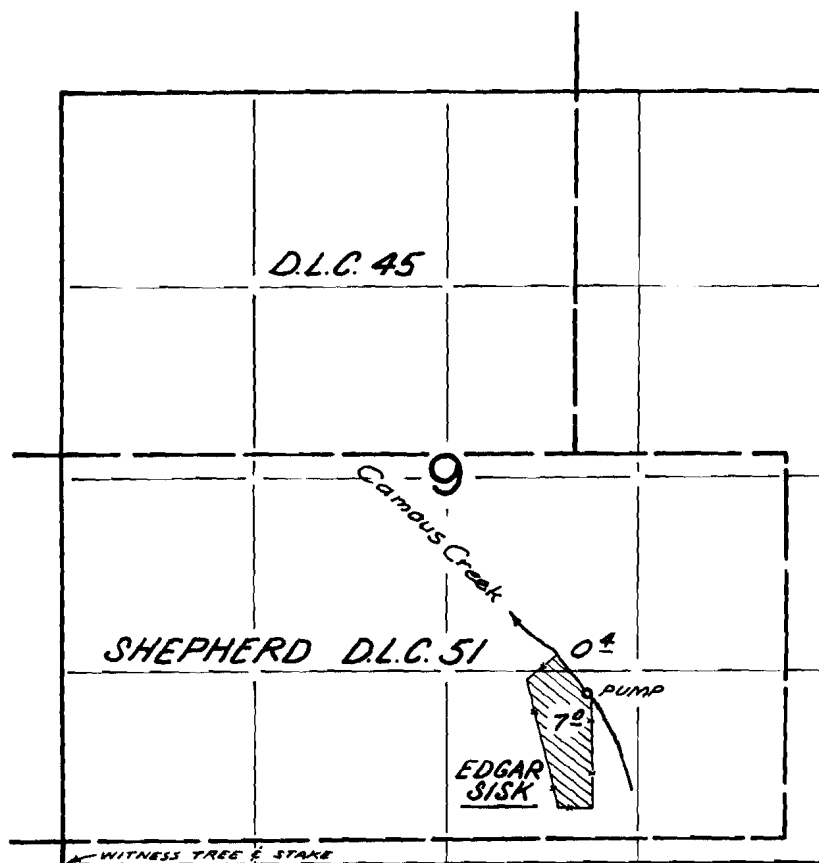


FINAL PROOF SURVEY
UNDER

Application No. 17802 Permit No. 17510
IN NAME OF

MUDDY CREEKS IRRIGATION PROJECT

Surveyed JUN. 14, 1966, by V. GARNER

T.14S. R.4 W. W.M.

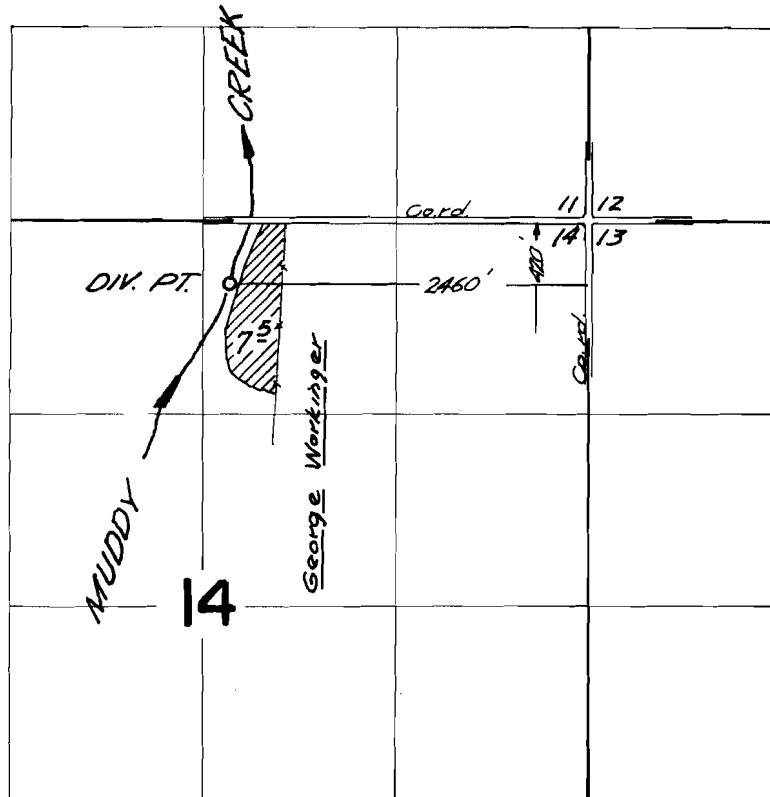


FINAL PROOF SURVEY
UNDER

Application No. 17802 Permit No. 17510
IN NAME OF

MUDDY CREEK^S IRRIGATION PROJECT

Surveyed May 26, 1966, by V. GARNER

T. 14 S. R. 4 W. W.M.

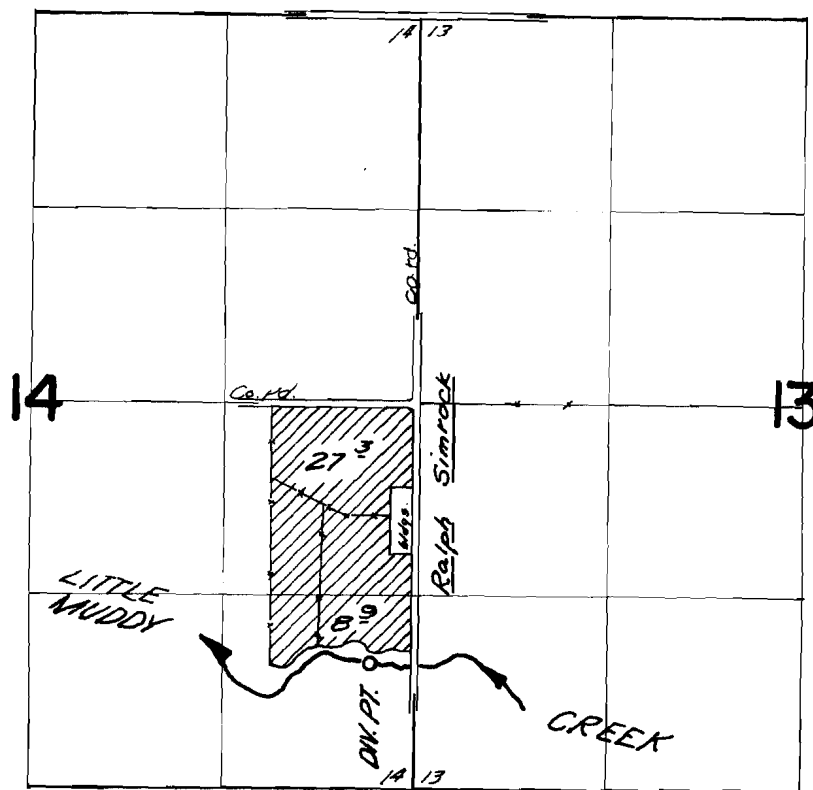

Div. Pt. located 1770 ft. S. & 300 ft. W.
from the E $\frac{1}{2}$ corner of Section 14

FINAL PROOF SURVEY UNDER

Application No. 17802 Permit No. 17510
IN NAME OF

MUDDY CREEK^S IRRIGATION PROJECT


Surveyed May 26, 1966, by V. GARNER

T14 S.R. 4 W.W.M.
SECTION 14
TRANSFER MAP
MUDDY CREEK IRRIGATION PROJECT
LINN COUNTY, OREGON

1994

1994

POINT OF DIVERSION IS
IN NE 1/4 - NE 1/4, SEC. 9,
T17S.R.3W.W.M. 4440
FEET SOUTH AND 5250
FEET EAST FROM THE
S.E. COR. OF THE
MAULSFIELD D.L.C.
NO. 79

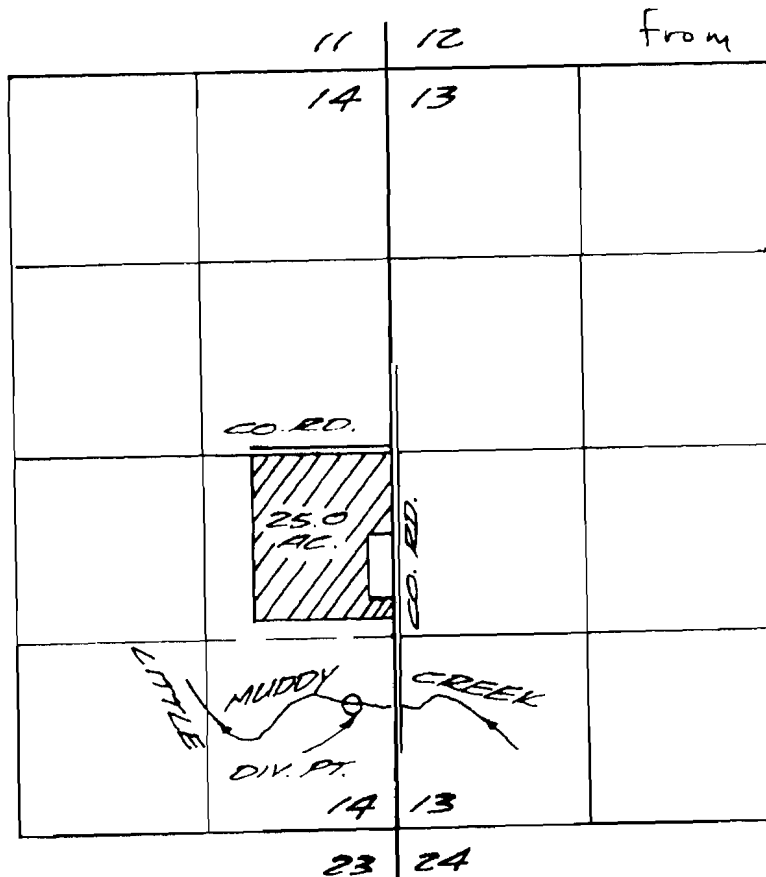

DIV. PT. LOCATED 1770 FT. SOUTH &
300 FT. WEST FROM THE E. 1/4 COR.
OF SEC. 14


SCALE 1"=132' APRIL 25, 1994

OUT OF APPLICATION NO.
17802 PERMIT NO. 17510

T-7161


THIS MAP IS FOR WATER
RIGHT PURPOSES ONLY AND
IS NOT INTENDED TO PROVIDE
DIMENSIONS FOR LOCATING
PROPERTY BOUNDARIES

CHARLES W. GUILLE
& ASSOCIATES, CO.
Land Surveying
52 Centennial Loop
Eugene, OR 97401

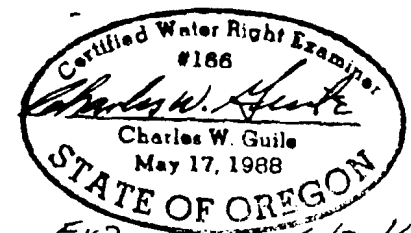

EXP. DATE - 6/30/1994

T.14 S. R.4 W. W.M.

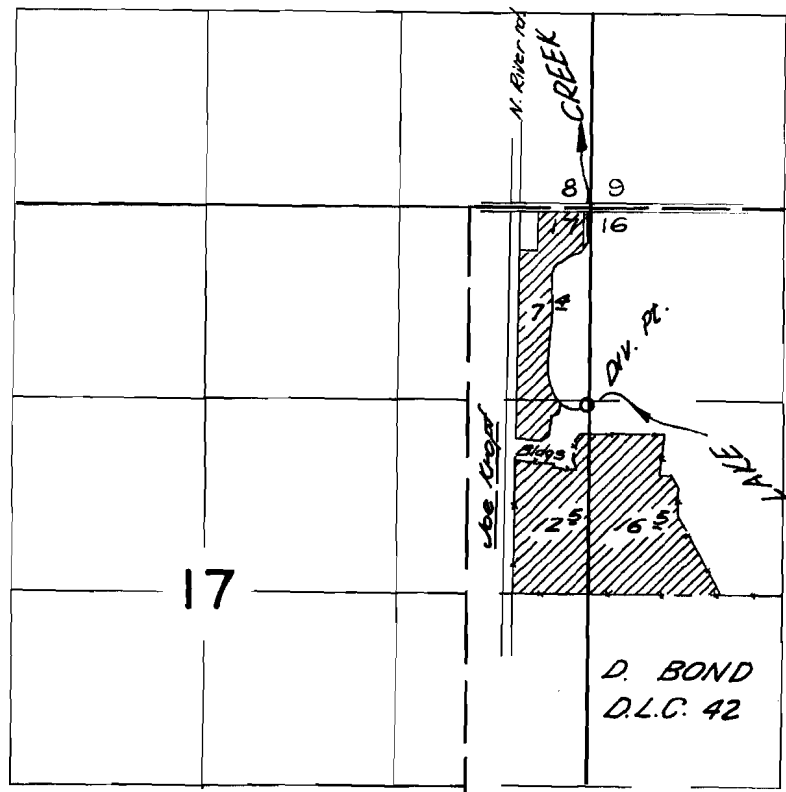

Div Pt located 1350 R. S. & 20 R. W.
from the N.E. corner of Section 17


FINAL PROOF SURVEY
UNDER

Application No. 17802 Permit No. 17510
IN NAME OF

MUDDY CREEK'S IRRIGATION PROJECT

Surveyed July 8 1966, by V. GARNER

T.14 S. R.4 W. W.M.

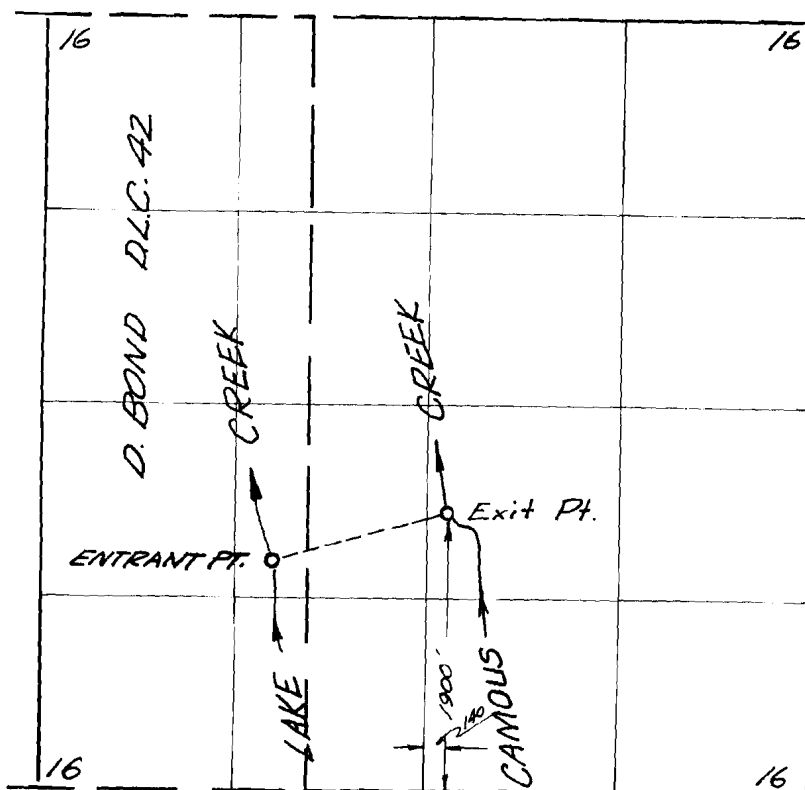


FINAL PROOF SURVEY
UNDER

Application No. 17802 Permit No. 17510
IN NAME OF

MUDDY CREEK'S IRRIGATION PROJECT

Surveyed July 28, 1966, by V. GARNER

T.14S. R.4W. W.M.

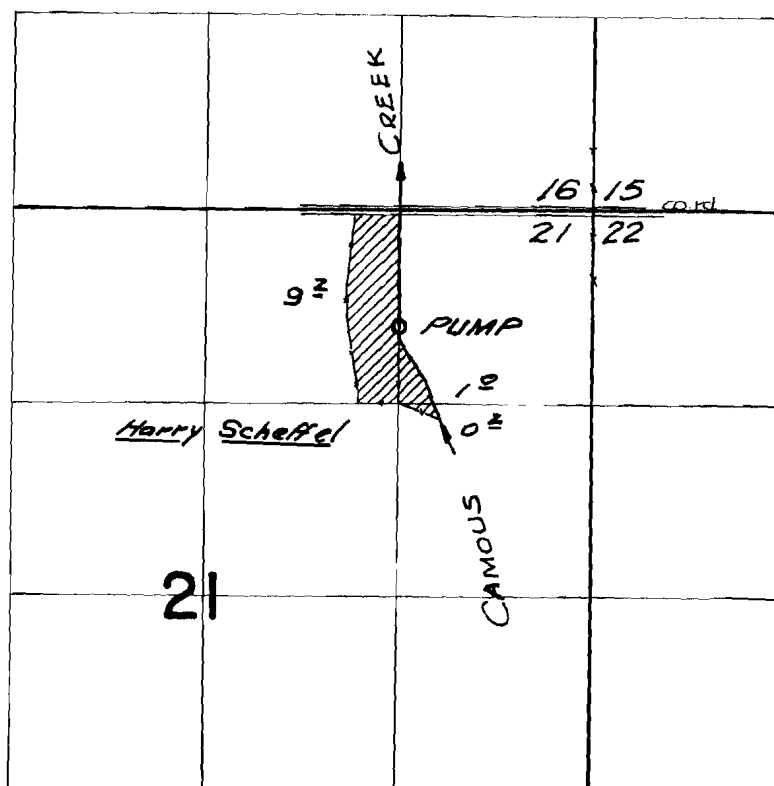


FINAL PROOF SURVEY
UNDER

Application No. 17802 Permit No. 17510
IN NAME OF

MUDDY CREEK'S IRRIGATION PROJECT

Surveyed July 7, 1966, by V. GARNER

T.14 S. R.4 W. W.M.

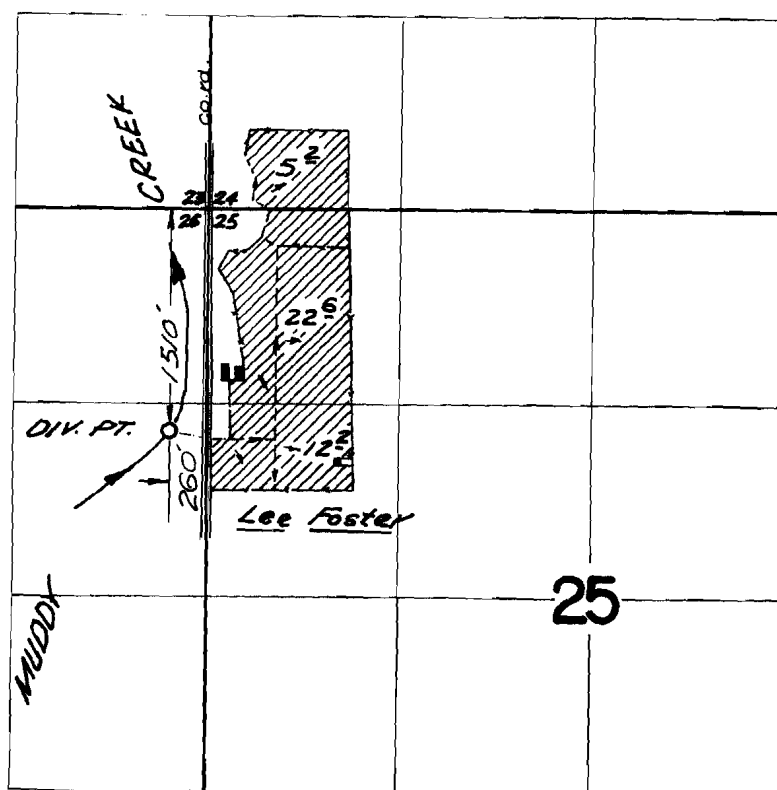


FINAL PROOF SURVEY
UNDER

Application No. 17802 Permit No. 17510
IN NAME OF

MUDDY CREEK IRRIGATION PROJECT

Surveyed June 16, 1966, by V. GARNER

T.14 S. R.38 & 4 W. W.M.

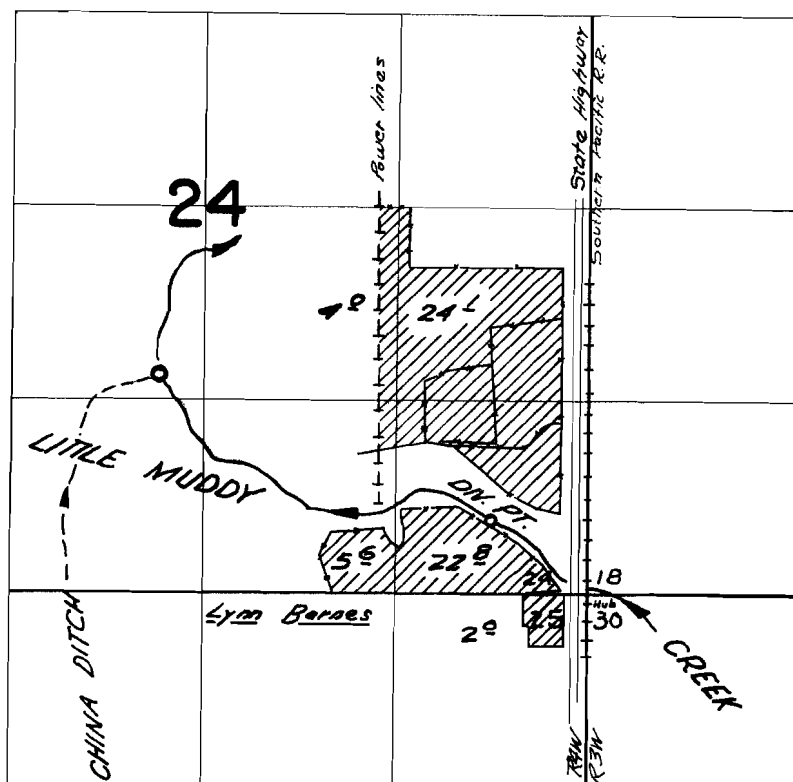

Div. Pt. located 500 ft. N. & 670 ft. W. from
the SE cor. of Sec. 24


FINAL PROOF SURVEY UNDER

Application No. 17802 Permit No. 17510
IN NAME OF

MUDDY CREEK IRRIGATION PROJECT

Surveyed June 15, 1966, by V. GARNER

T14S R.4W. W.M.

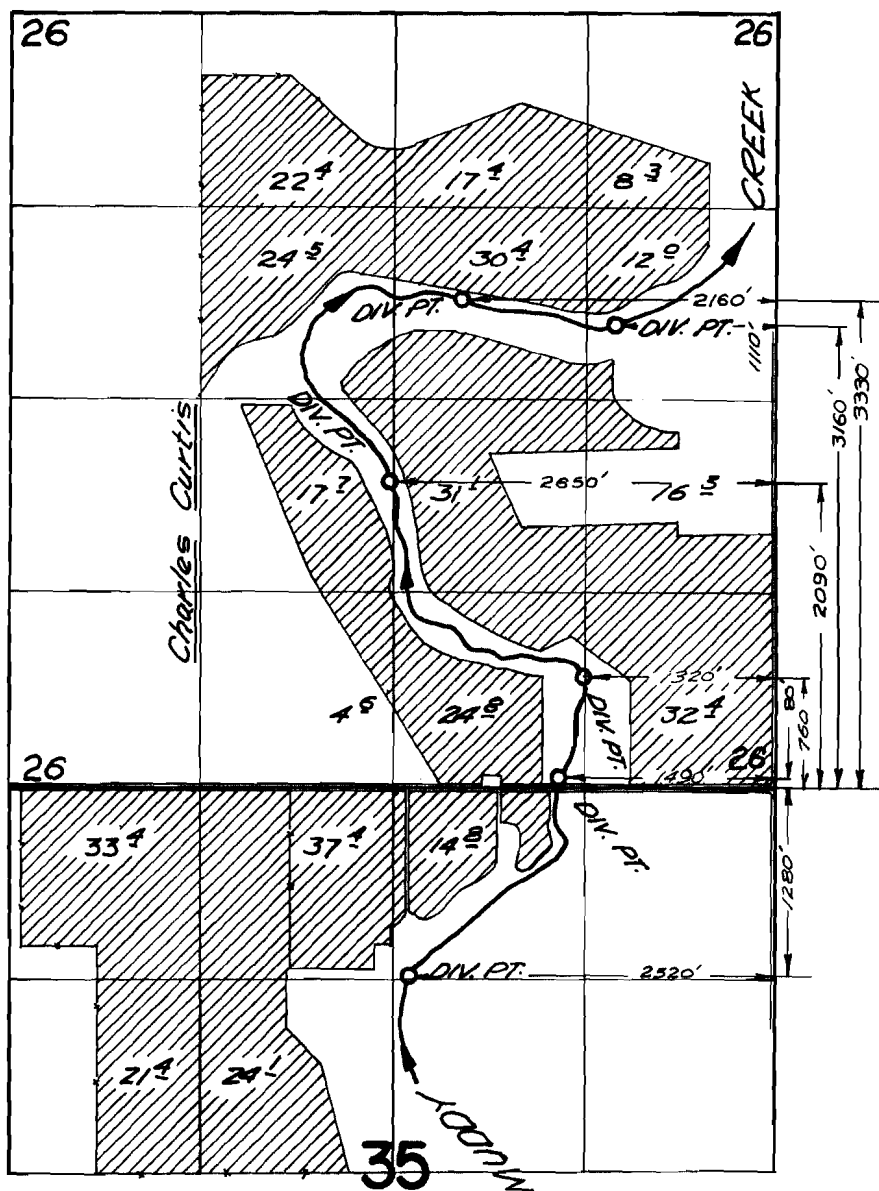


FINAL PROOF SURVEY UNDER

Application No. 17802 Permit No. 17510
IN NAME OF

MUDDY CREEKS IRRIGATION PROJECT

Surveyed June 26, 1966, by V. GARNER

T.14S. R.4 W. W.M.

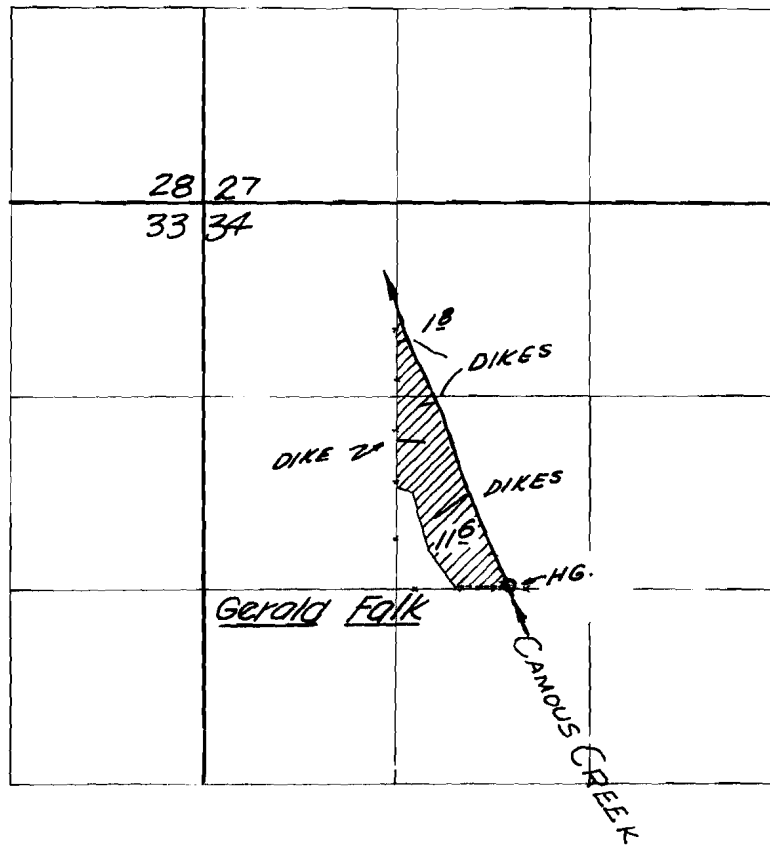


FINAL PROOF SURVEY
UNDER

Application No. 17802... Permit No. 17510..
IN NAME OF

MUDDY CREEKS IRRIGATION PROJECT

Surveyed May 25, 1966, by V. GARNER...

T.14S.R.4W.W.M.

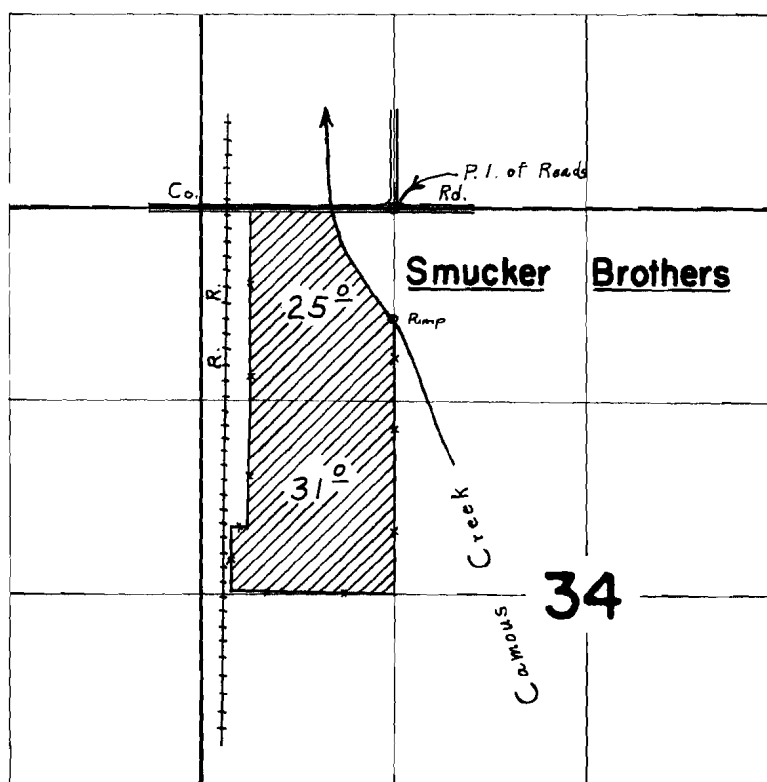


FINAL PROOF SURVEY
UNDER

Application No. 17802 Permit No. 17510
IN NAME OF
MUDDY CREEKS IRRIGATION PROJECT

Surveyed July 28 1966, by L. E. Gould

T. 14 S. R. 4 W. W.M.

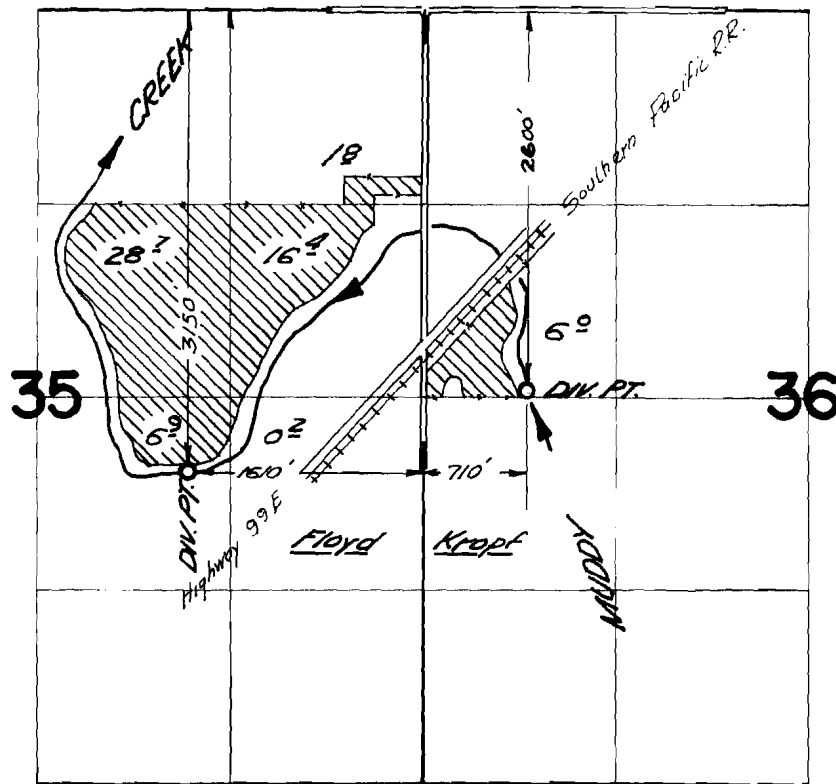


FINAL PROOF SURVEY
UNDER

Application No. 17802 Permit No. 17510
IN NAME OF

MUDDY CREEK'S IRRIGATION PROJECT

Surveyed June 17, 1966, by V. GARNER

T.14S. R.3&4W. W.M.

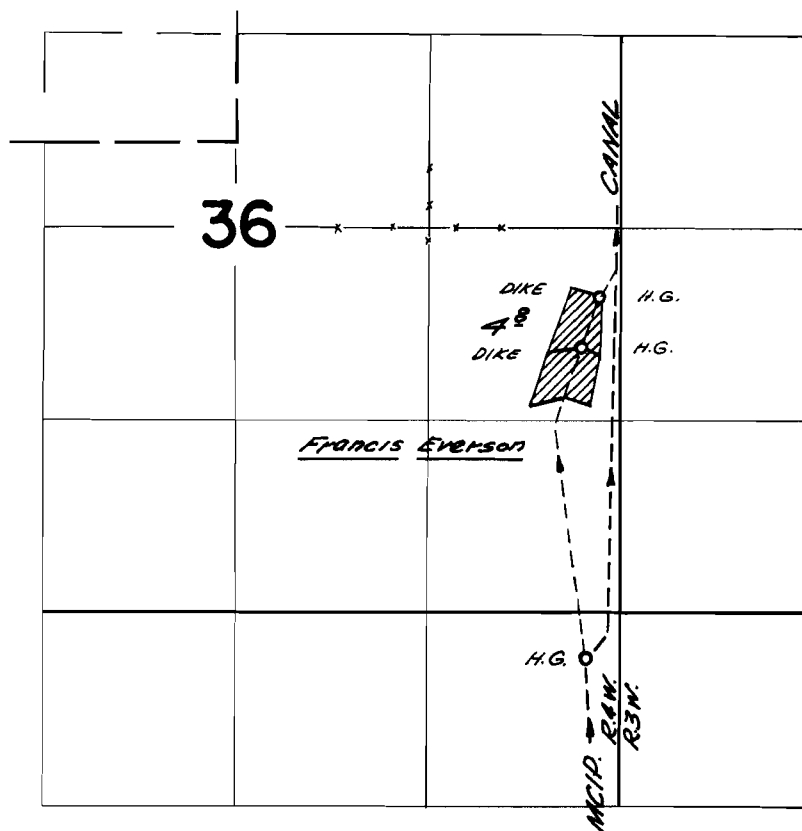


FINAL PROOF SURVEY
UNDER

Application No. 17802 Permit No. 17510
IN NAME OF

MUDDY CREEK'S IRRIGATION PROJECT

Surveyed July 26 1966, by V. GARNER

T. 15 S. R. 3 W. W. M.

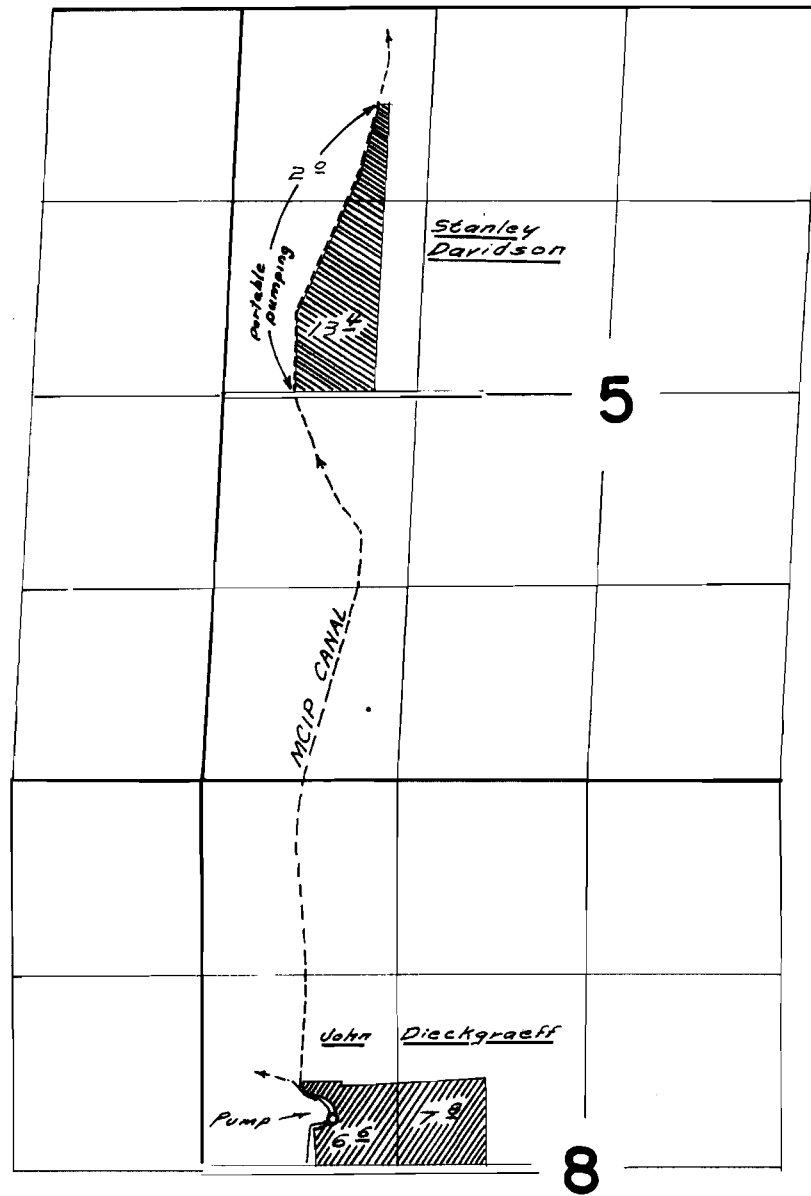


FINAL PROOF SURVEY UNDER

Application No. 17802 Permit No. 17510
IN NAME OF

MUDDY CREEKS IRRIGATION PROJECT

Surveyed March 26 1967, by W. J. Ruppert

T. 15 S. R. 3 & 4 W. W.M

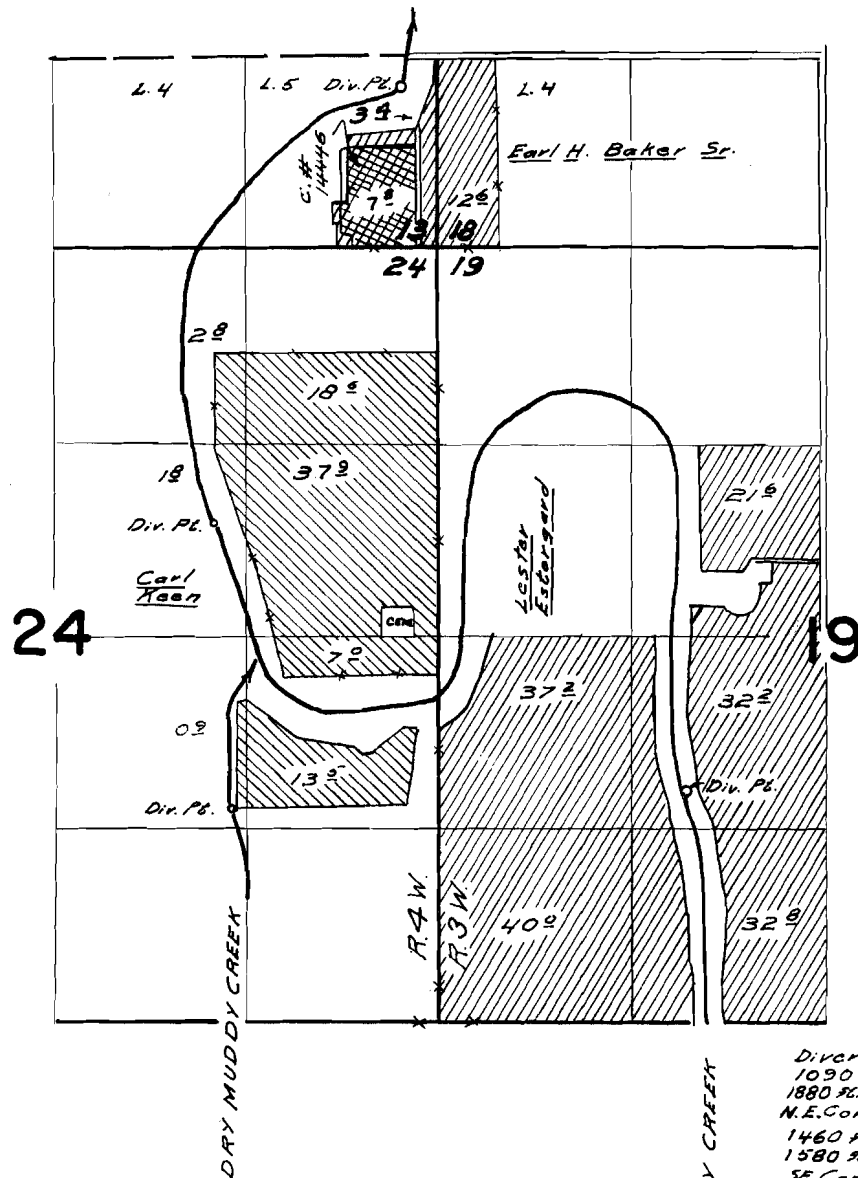

Diversion points located
 1090 ft. N. E 250 ft. W.; E
 1880 ft. S. & 1530 ft. W. from
 N.E. Cor. Sec. 24. And
 1460 ft. N. & 1410 ft. W.; E
 1580 ft. N & 1690 ft. E From
 SE. Cor. Sec. 24.

FINAL PROOF SURVEY


UNDER

Application No. 17802 Permit No. 17510
 IN NAME OF

MUDDY CREEKS IRRIGATION PROJECT

Surveyed May 27 1966, by W. J. Ruppert
June 15
July 6 & 25

T.15S. R.3W. W.M.

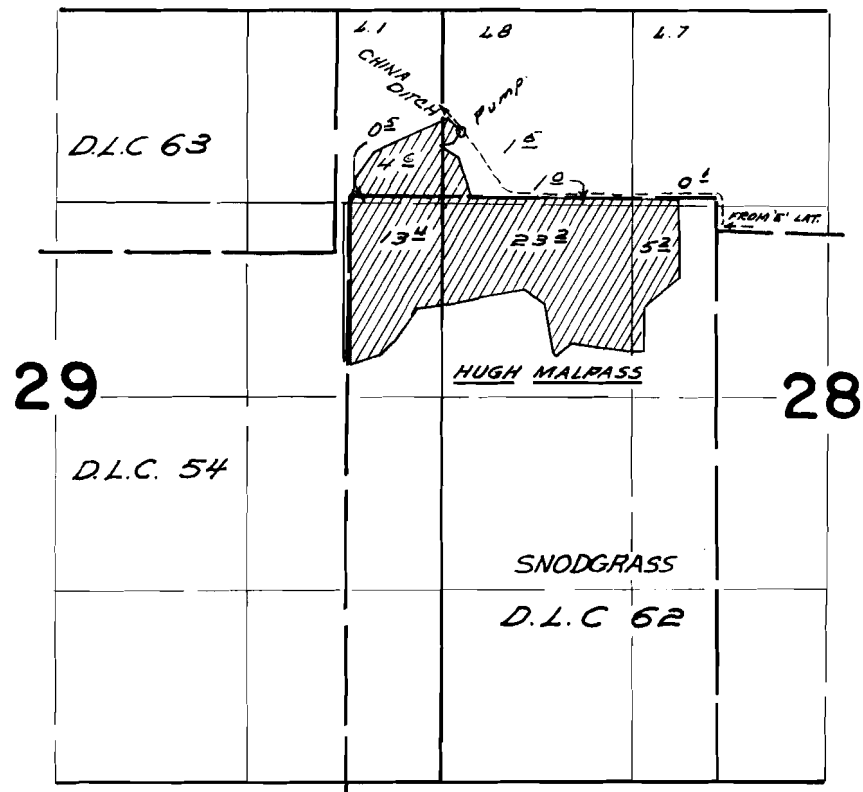


FINAL PROOF SURVEY
UNDER

Application No. 17802 Permit No. 17510
IN NAME OF

MUDDY CREEKS IRRIGATION PROJECT

Surveyed June 17 19.66, by W.J. Ruppert

T.15S. R.3W. W.M.

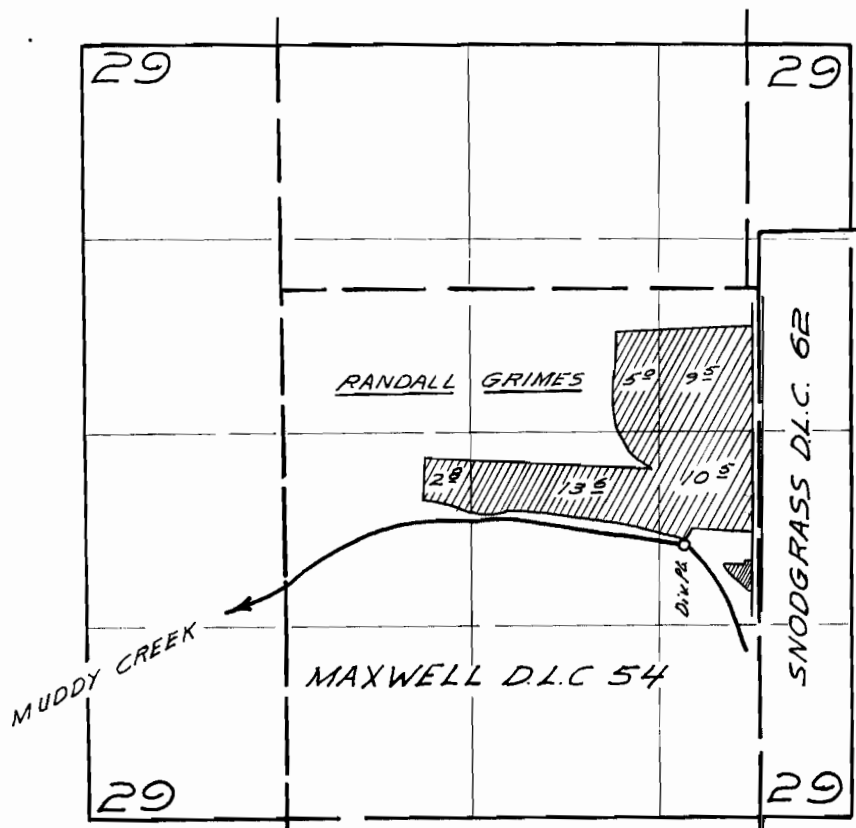

Div. P6 located 2130 N.E. & 520 P.W. from N.W. Cor.
Snodgrass D.L.C. 62.


FINAL PROOF SURVEY UNDER

Application No. 17802 Permit No. 17510
IN NAME OF

MUDDY CREEKS IRRIGATION PROJECT

Surveyed June 16 1966, by W.J. Ruppert

T.15S.R.3W.W.M.

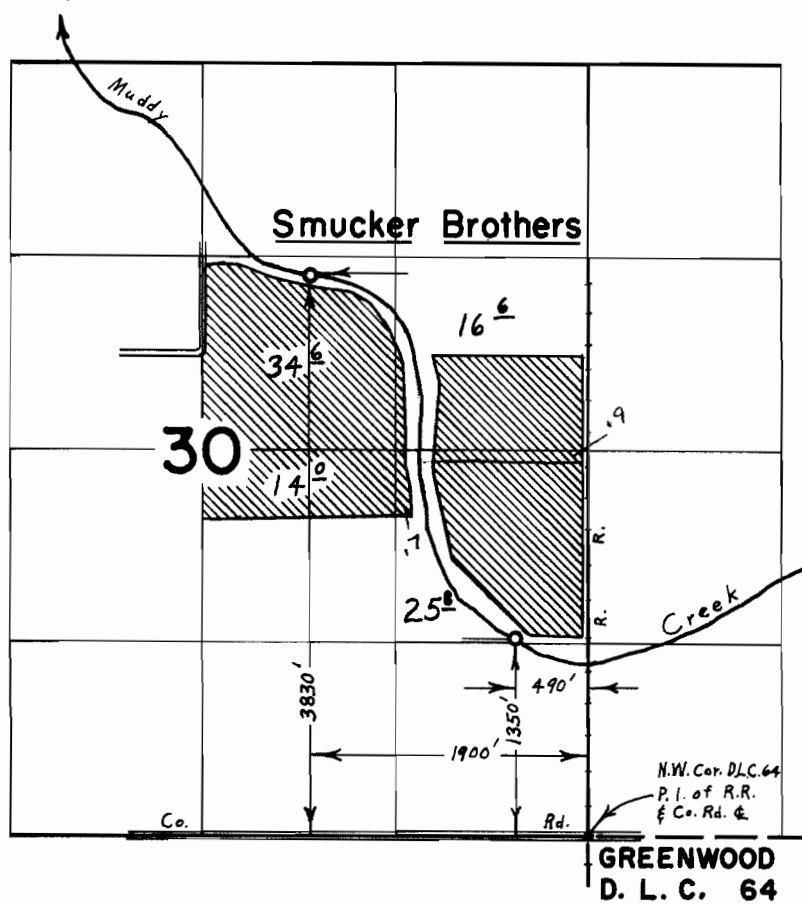


FINAL PROOF SURVEY UNDER

Application No. 17802 Permit No. 17510
IN NAME OF
MUDDY CREEKS IRRIGATION PROJECT

Surveyed July 28, 1966, by L. E. Gould

T.15 S. R.3 W. W.M.

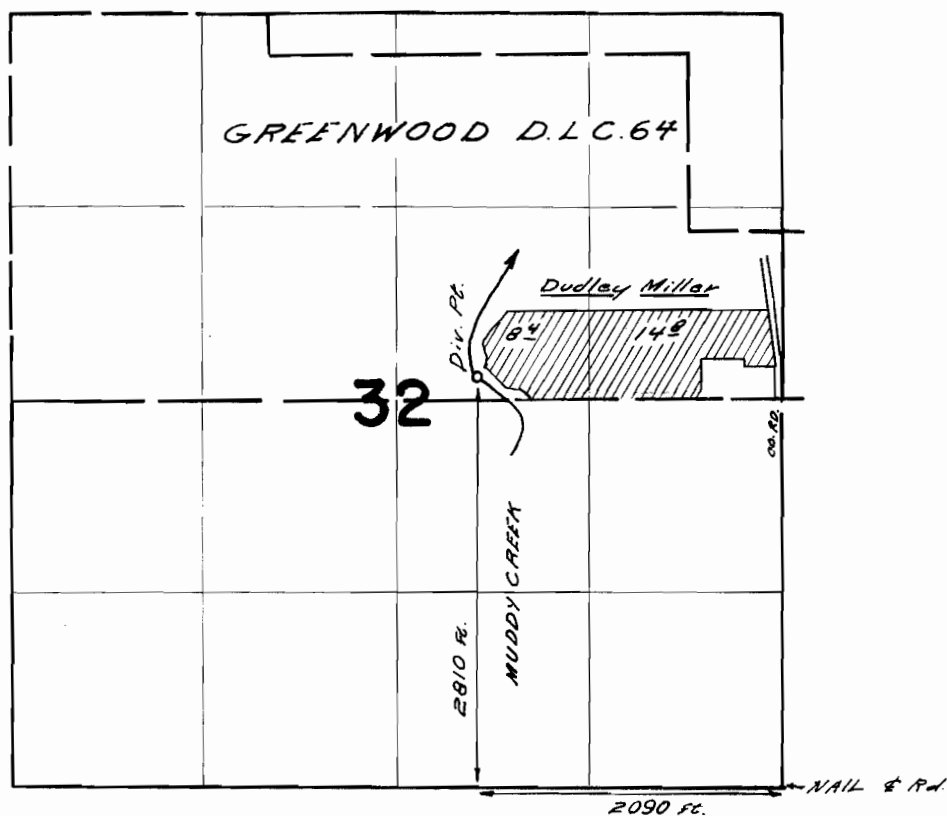


FINAL PROOF SURVEY
UNDER

Application No. 17802 Permit No. 17510
IN NAME OF

MUDDY CREEKS IRRIGATION PROJECT

Surveyed JUNE 17 1966, by W. J. Huppert

T.15S. R.4W. W.M.

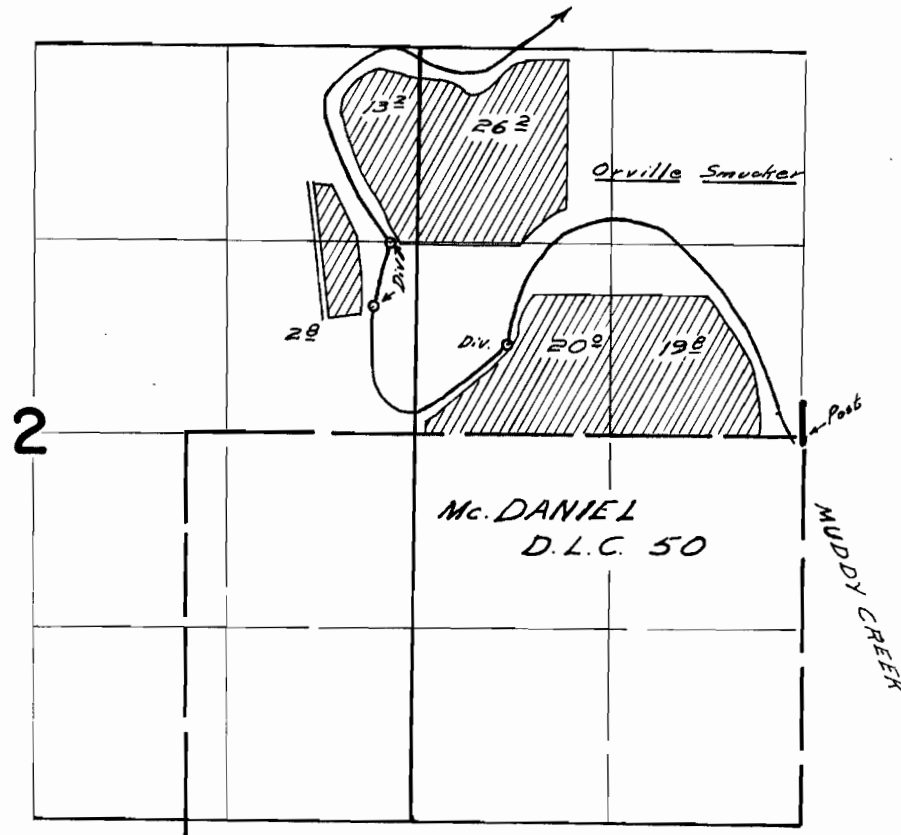

Div. Pts. located 620 ft. N. & 2030 ft. W.; 860 ft. N. & 2950 ft. W.; & 1310 ft. N. & 2850 ft. W., All from N.E. Corner McDaniel D.L.C. 50


FINAL PROOF SURVEY UNDER

Application No. 17802 Permit No. 17510
IN NAME OF

Muddy Creek Irrigation Project

Surveyed May 26 1966, by W. J. Ruppert

T.15S. R.4W. W.M.

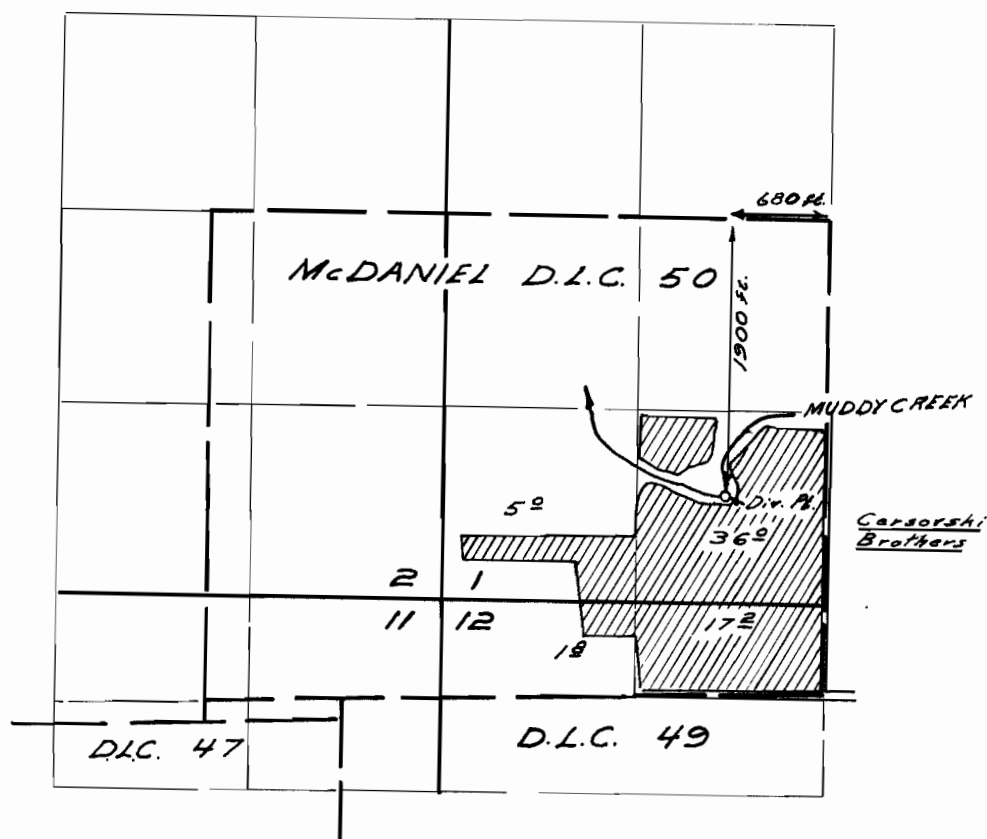


FINAL PROOF SURVEY
UNDER

Application No. 17802 Permit No. 17510
IN NAME OF

MUDDY CREEKS IRRIGATION PROJECT

Surveyed May 26 1966, by W.J. Ruppert

T.15S. R.4W.W.M.

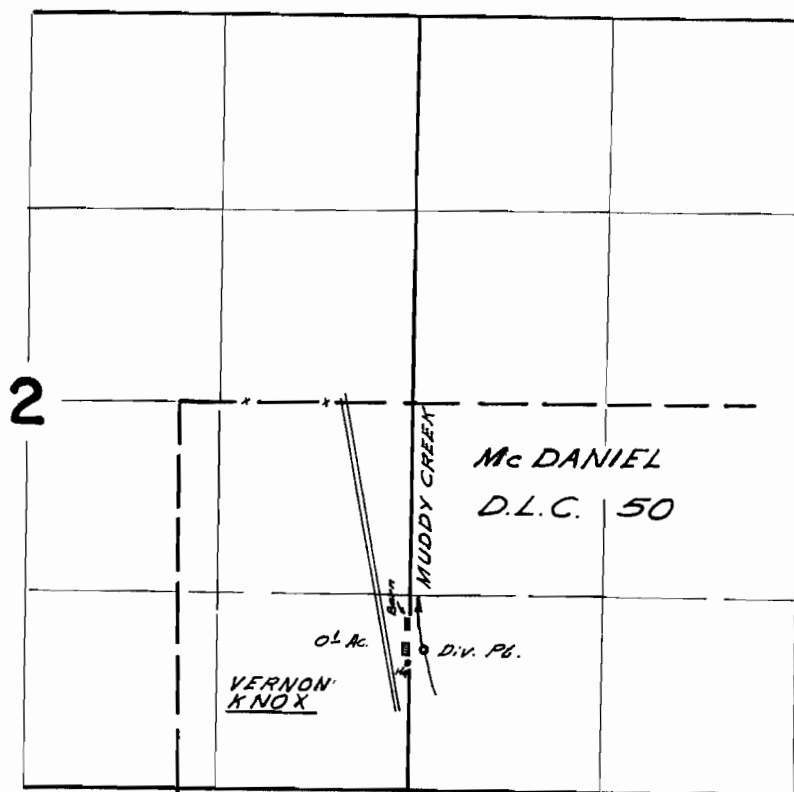

Div. P6. located 1680 ft. E & 1670 ft. S. From N.W. Corner. McDaniel D.L.C. 50


FINAL PROOF SURVEY
UNDER

Application No. 17802 Permit No. 17510
IN NAME OF

MUDDY CREEKS IRRIGATION PROJECT

Surveyed May 26 1966, by W. J. Ruppert

T.15S. R.4W.W.M.

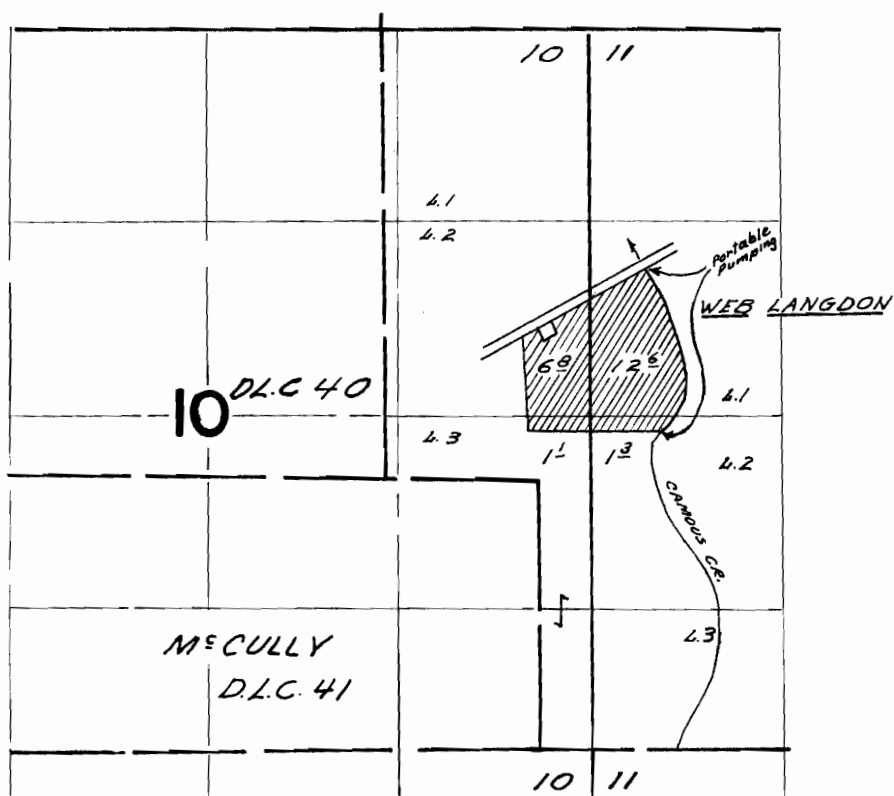

PORTABLE PUMPING BETWEEN POINTS 740 FT. E. & 3280 FT. N.; & 840 FT. E. & 8170 FT. N.; BOTH FROM SE COR. MCCULLY D.L.C. 41


FINAL PROOF SURVEY UNDER

Application No. 17802 Permit No. 17510
IN NAME OF

MUDDY CREEKS IRRIGATION PROJECT

Surveyed May 25 1966, by W.J. Ruppert

T. 15 S. R. 4 W. W.M.

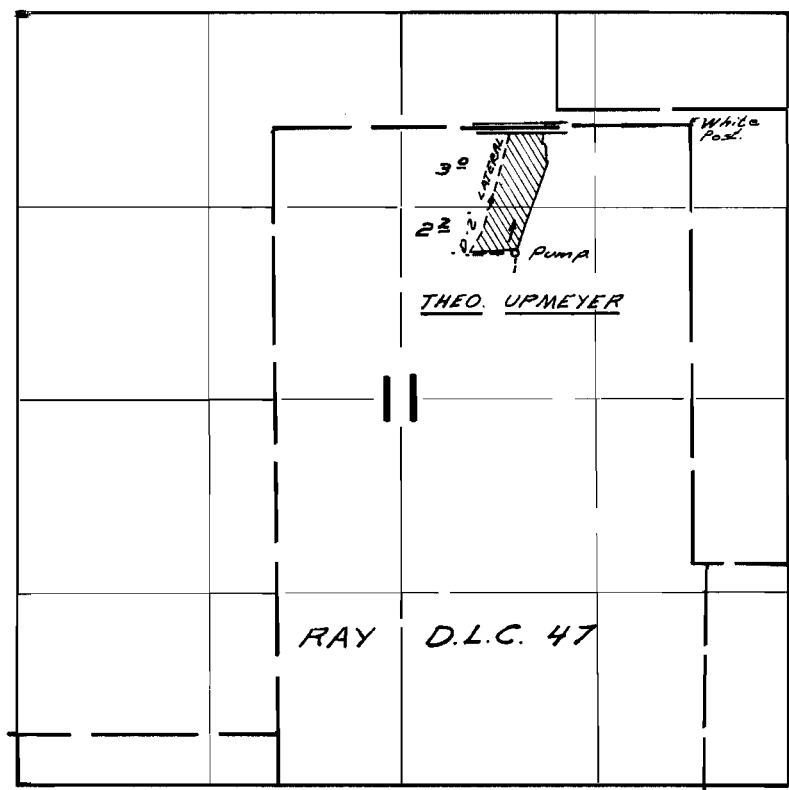

FINAL PROOF SURVEY
UNDER

Application No. 17802 Permit No. 17510
IN NAME OF

MUDDY CREEKS IRRIGATION PROJECT

Surveyed MAY 27 1966, by W.D. Ruppert


[FROM MAP]

T. 16 S. R. 3 W. W. M.
SECTION 4
FOR

MUDDY CREEK IRRIGATION PROJECT

TRANSFER MAP
REFERENCE NO. 7005

LANE COUNTY, OREGON

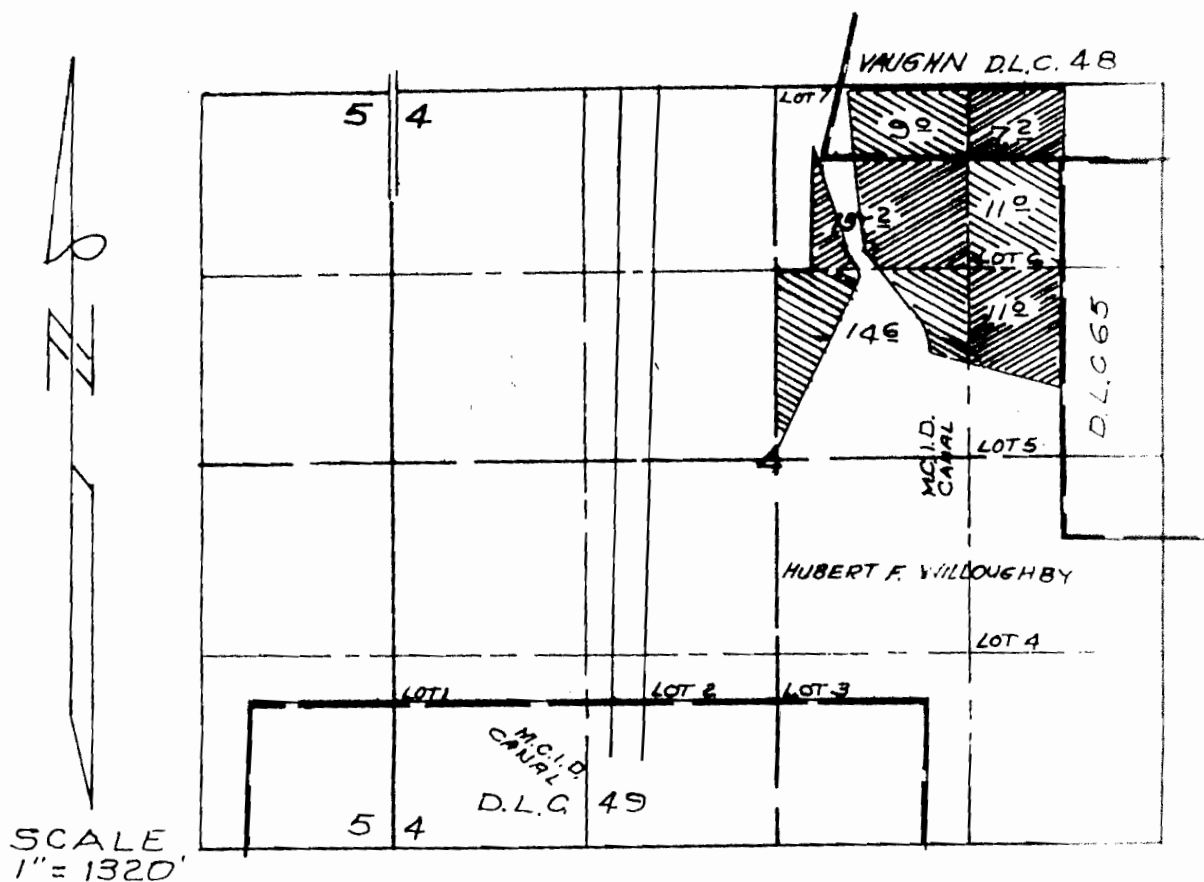


AUG. 2, 1993

OUT OF
APPLICATION 17802 PERMIT NO. 1

THIS MAP IS FOR WATER
RIGHT PURPOSES ONLY
AND IS NOT INTENDED TO
PROVIDE DIMENSIONS
FOR LOCATING PROPERTY
BOUNDARIES

CHARLES W. GUILLE
& ASSOCIATES, CO.
Land Surveying
52 Centennial Loop
Eugene, OR 97401

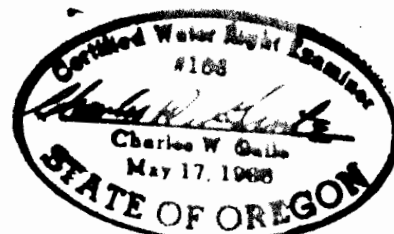


EXPIRE DATE 12/31/93

PREPARED FROM RECORDS

92-4

T.15S. R. 4W.W.M.

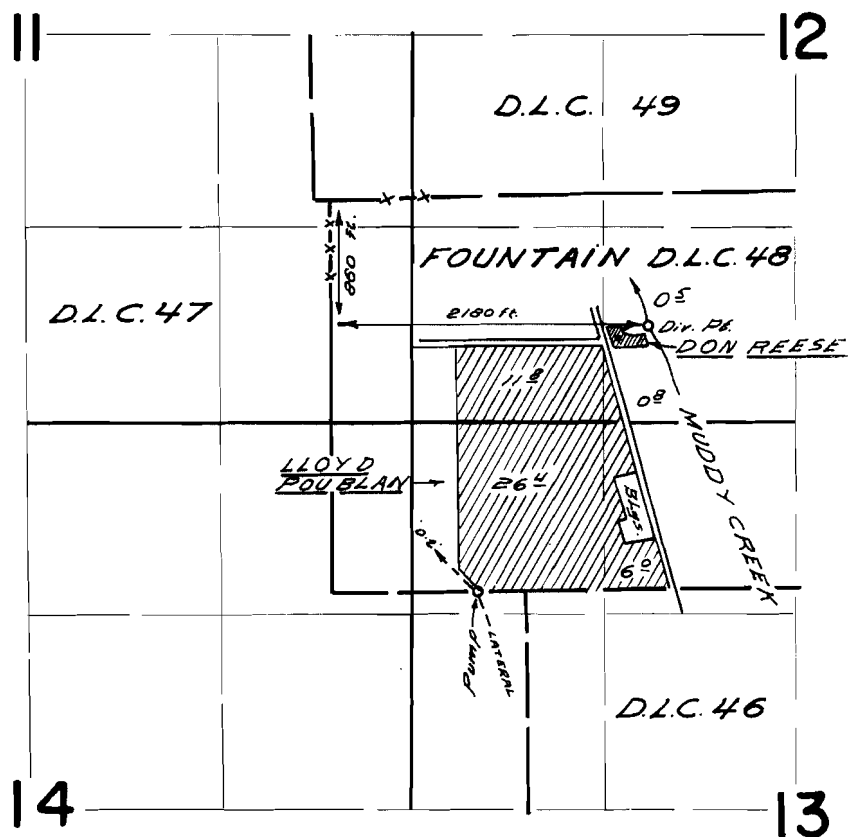


FINAL PROOF SURVEY
UNDER

Application No. 17802 Permit No. 17510
IN NAME OF

MUDY CREEKS IRRIGATION PROJECT

Surveyed May 20 1966, by W. J. HARRIS

T.15S.R.4W.W.M.

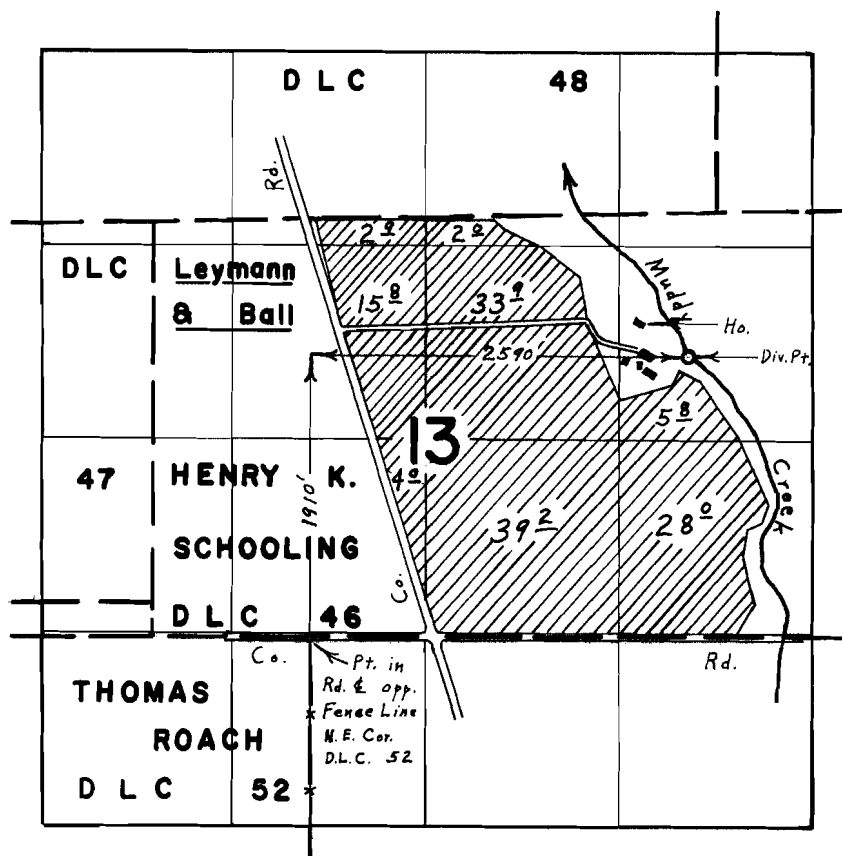


FINAL PROOF SURVEY
UNDER

Application No. 17802 Permit No. 17502
IN NAME OF
MUDDY CREEKS IRRIGATION PROJECT

Surveyed July 26 1966, by L. E. Gould

T.15 S.R.4 W.W.M.

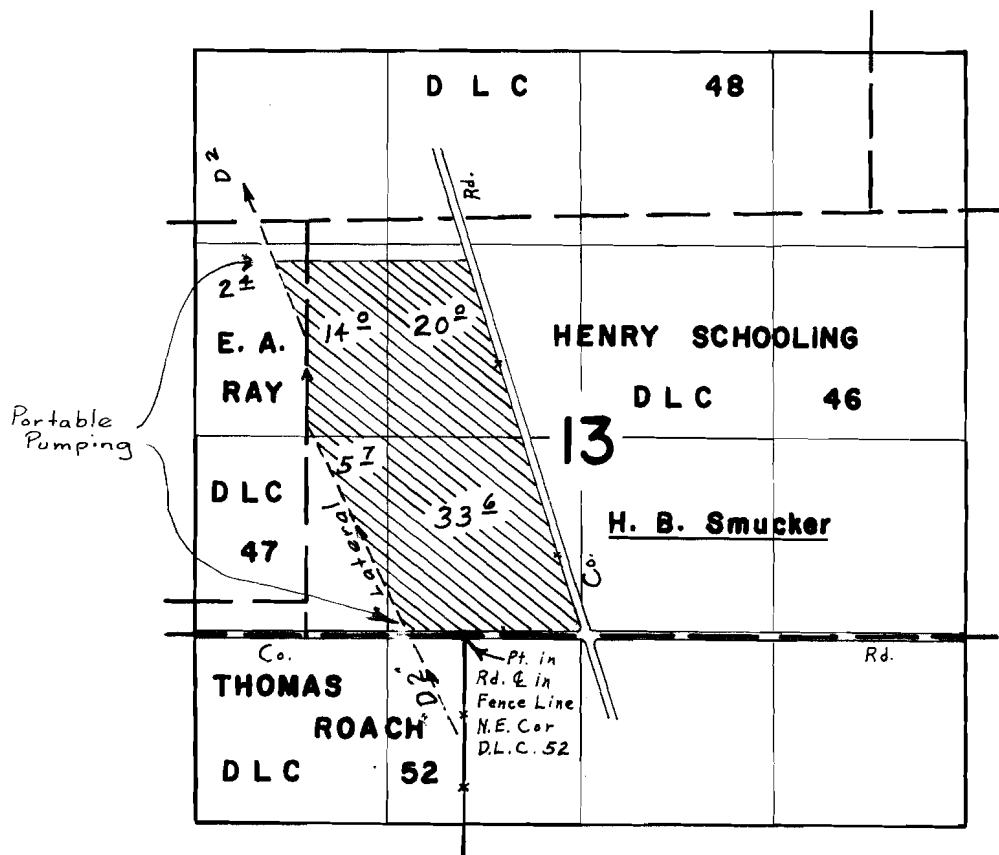


FINAL PROOF SURVEY UNDER

Application No. 17802 Permit No. 17510
IN NAME OF

MUDDY CREEKS IRRIGATION PROJECT

Surveyed July 28, 1966, by L. E. Gould

T.15S. R.4W. W.M.

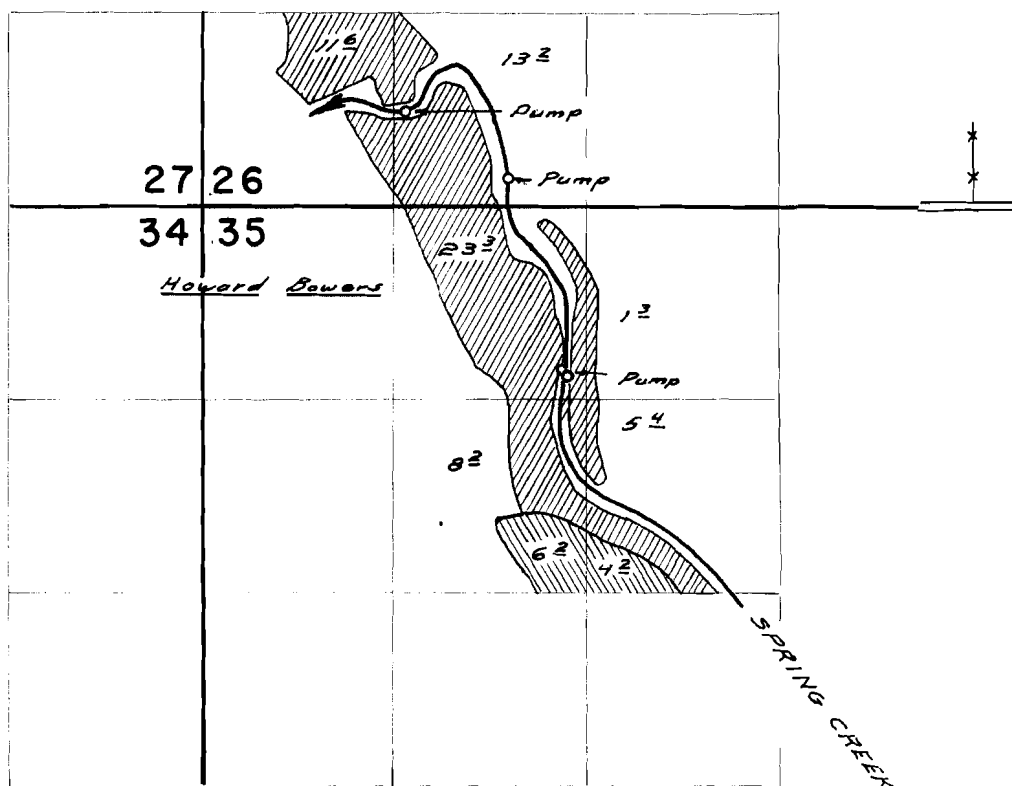


FINAL PROOF SURVEY
UNDER

Application No. 17802 Permit No. 17510
IN NAME OF

MUDDY CREEK IRRIGATION PROJECT

Surveyed June 14, 1966, by W.J. Ruppert

T.16S. R.3W. W.M.

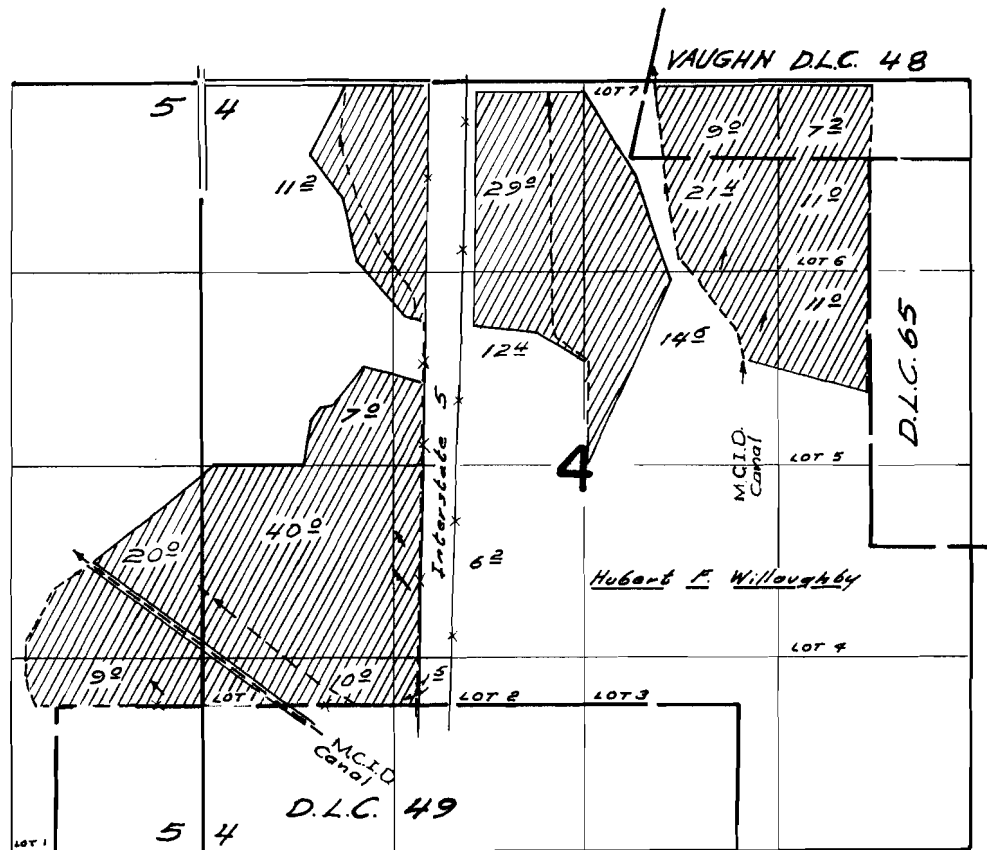


FINAL PROOF SURVEY
UNDER

Application No. 17802 Permit No. 17510
IN NAME OF

MUDDY CREEKS IRRIGATION PROJECT

Surveyed July 8, 1966, by N. d. Ruppert

T. 16 S. R. 3 W. W.M.

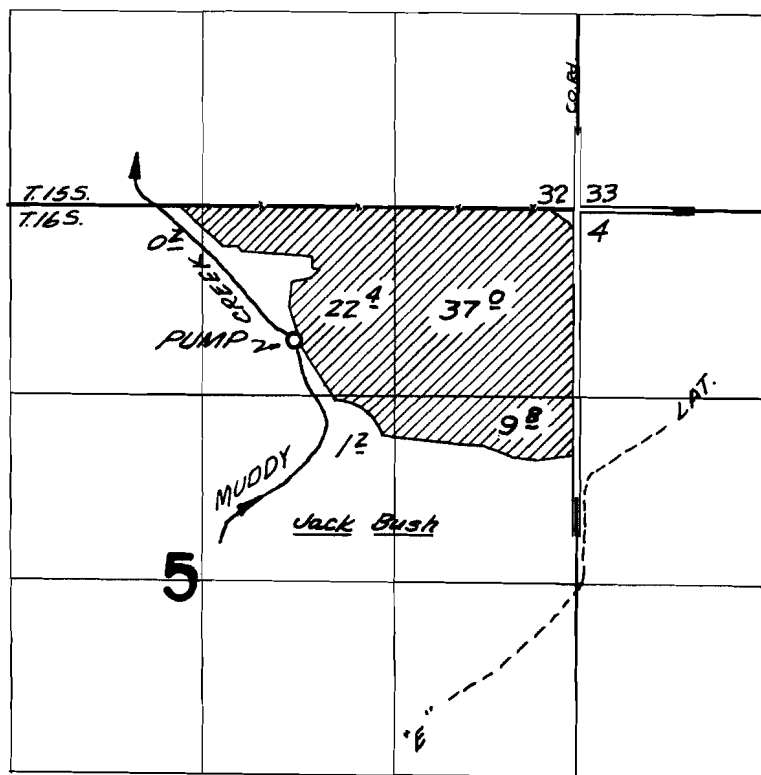


DIV. PT. LOCATED 910' S. & 1940' W. FROM NE COR. SEC. 5

FINAL PROOF SURVEY UNDER

Application No. 17802 Permit No. 17510
IN NAME OF

MUDDY CREEK IRRIGATION PROJECT

Surveyed July 27, 1966, by L. E. GOULD

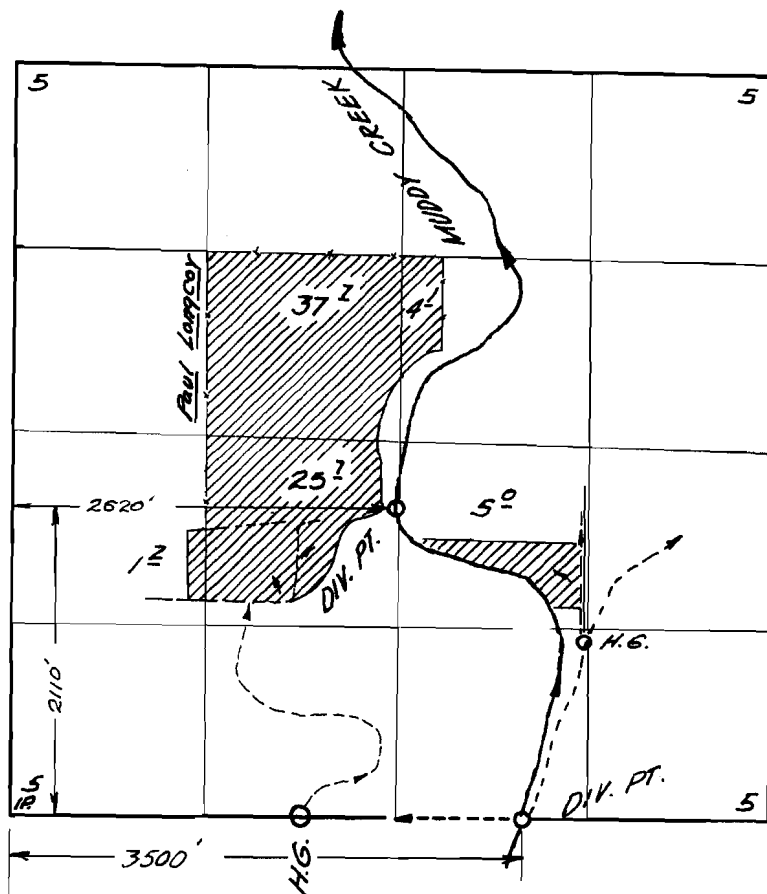


FINAL PROOF SURVEY
UNDER

Application No. 17802 Permit No. 17510
IN NAME OF

MUDDY CREEKS IRRIGATION PROJECTS

Surveyed June 17, 1966, by L. E. Gould.

T.15&16S.R.3&4W.W.M.

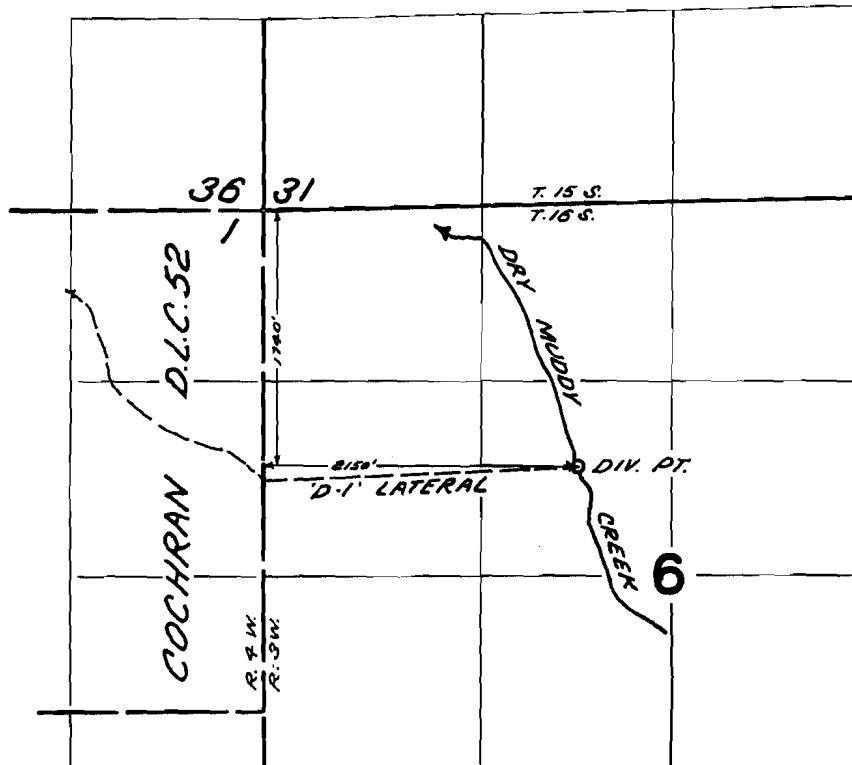


FINAL PROOF SURVEY
UNDER

Application No. 17802 Permit No. 17510
IN NAME OF

MUDDY CREEKS IRRIGATION PROJECT

Surveyed JUL. 28 1966, by V. GARNER

T.16 S. R.3 W.W.M.

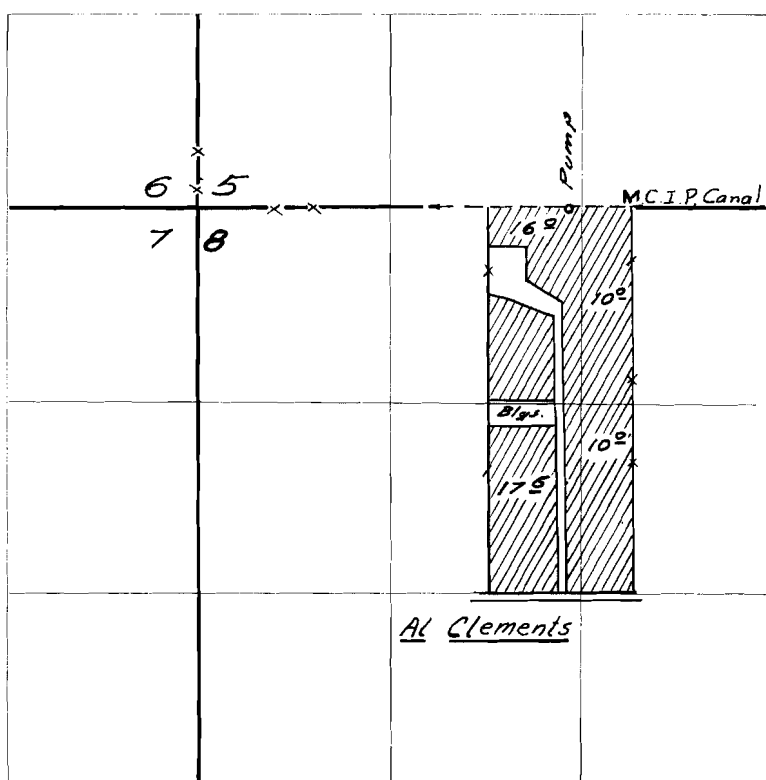


FINAL PROOF SURVEY
UNDER

Application No. 17802 Permit No. 17510
IN NAME OF

MUDDY CREEKS IRRIGATION PROJECT

Surveyed July 7 1966, by W. d. Ruppert

T.16S.R.3W.W.M.

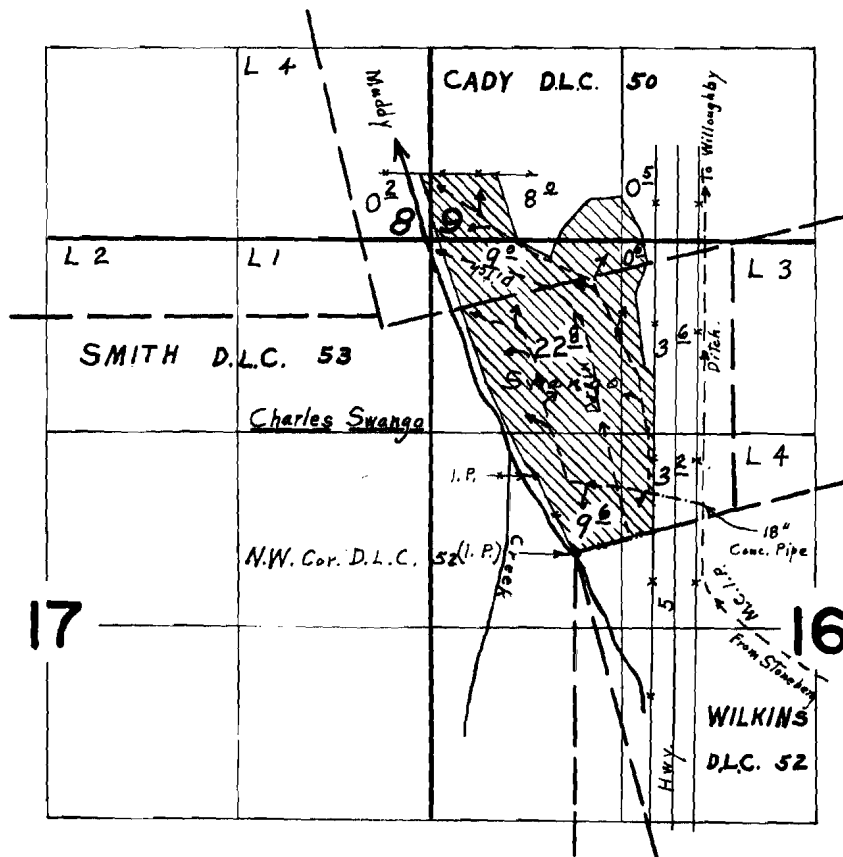


FINAL PROOF SURVEY
UNDER

Application No. 17802 Permit No. 17510
IN NAME OF

MUDDY CREEKS IRRIGATION PROJECT

Surveyed June 17 1966, by L. E. Gauld

T.16S.R.3W.W.M.

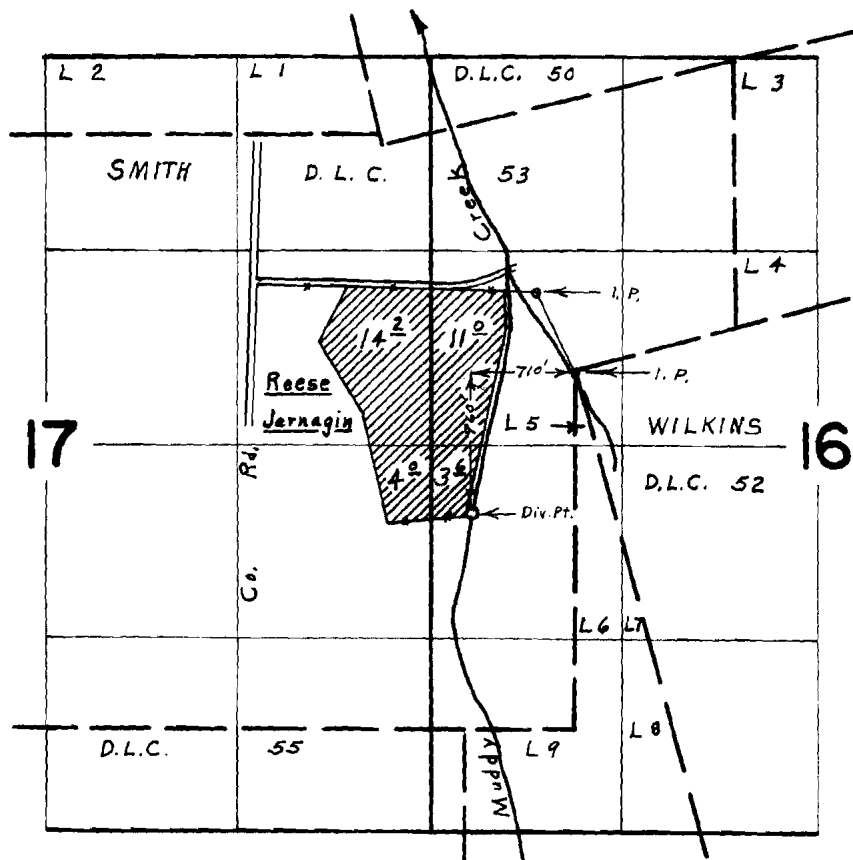


FINAL PROOF SURVEY UNDER

Application No. 17802 Permit No. 17510
IN NAME OF
MUDDY CREEKS IRRIGATION PROJECT

Surveyed June 16 1966, by L. E. Gould

T.16S.R.3W.W.M.

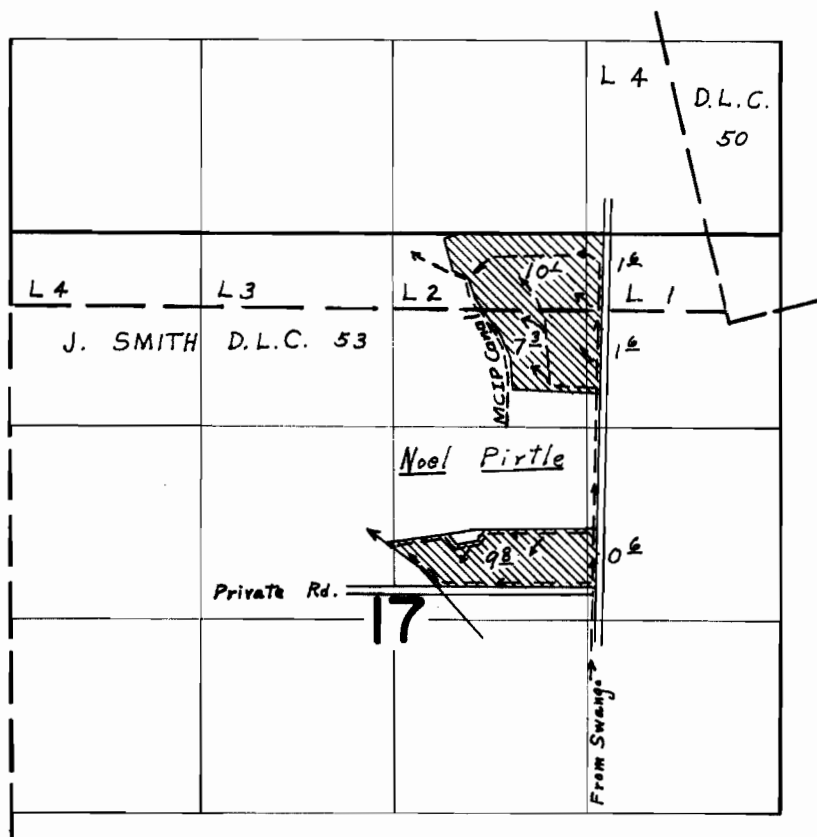


FINAL PROOF SURVEY
UNDER

Application No. 17802 Permit No. 17510
IN NAME OF

MUDDY CREEKS IRRIGATION PROJECT

Surveyed June 16, 1966, by L. E. Gould

T.16S.R.3W.W.M.

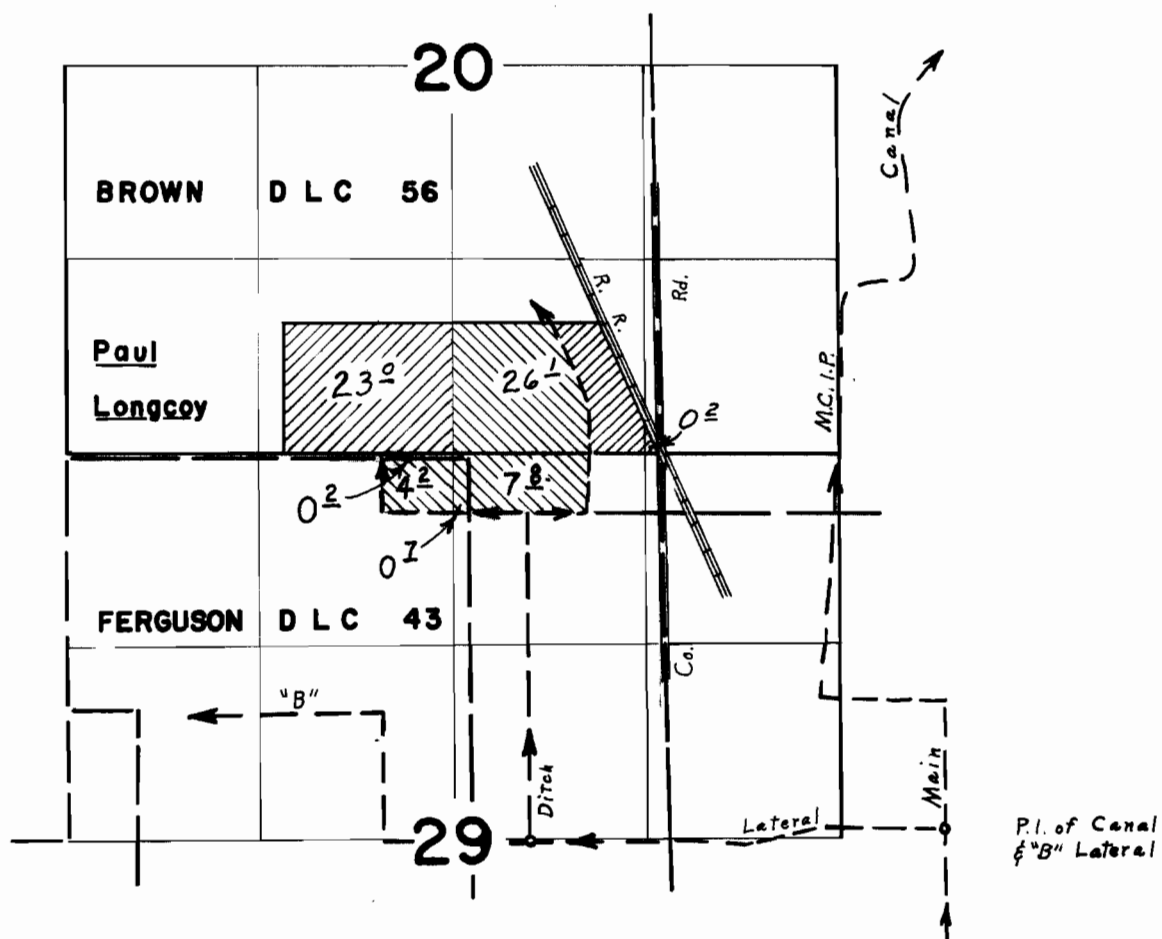


FINAL PROOF SURVEY UNDER

Application No. 17802 Permit No. 17510
IN NAME OF

MUDDY CREEKS IRRIGATION PROJECT

Surveyed June 14 1966, by L. E. Gould

T.16S.R.3W.W.M.

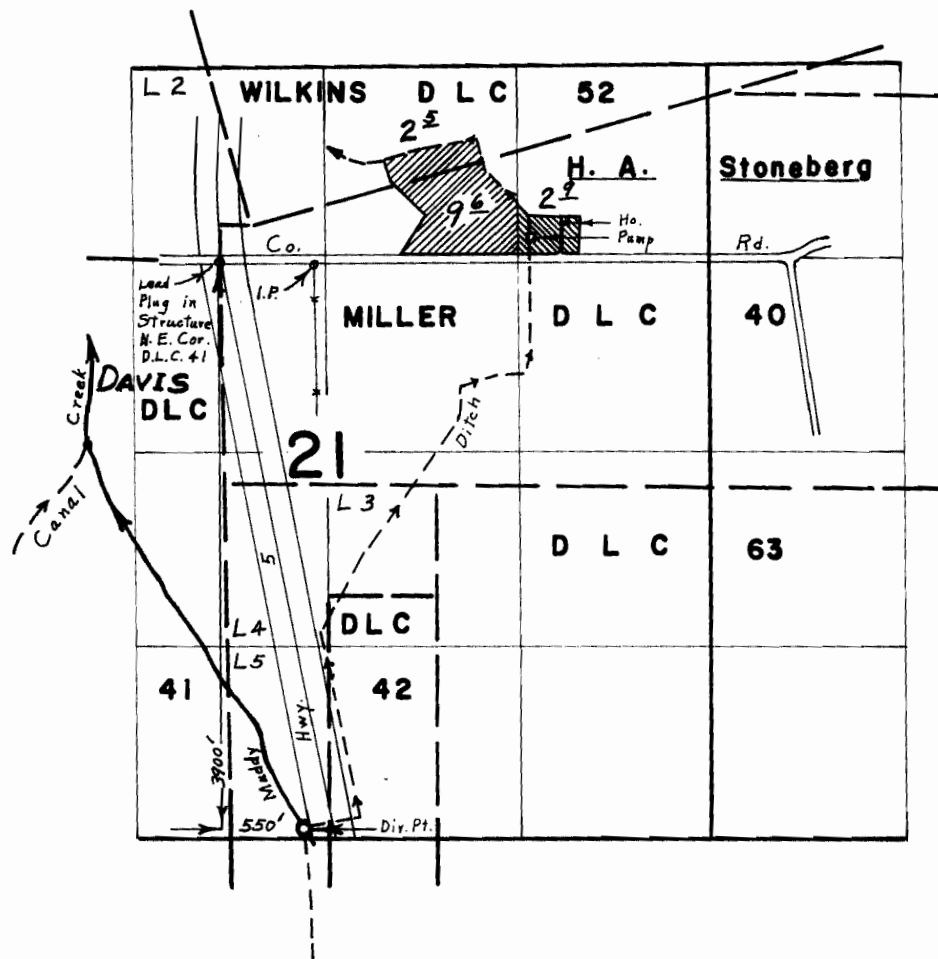


FINAL PROOF SURVEY
UNDER

Application No. 17802... Permit No. 17510...
IN NAME OF

MUDDY CREEKS IRRIGATION PROJECT

Surveyed July 7, 1966, by L. E. Gould

T.16S.R.3W.W.M.

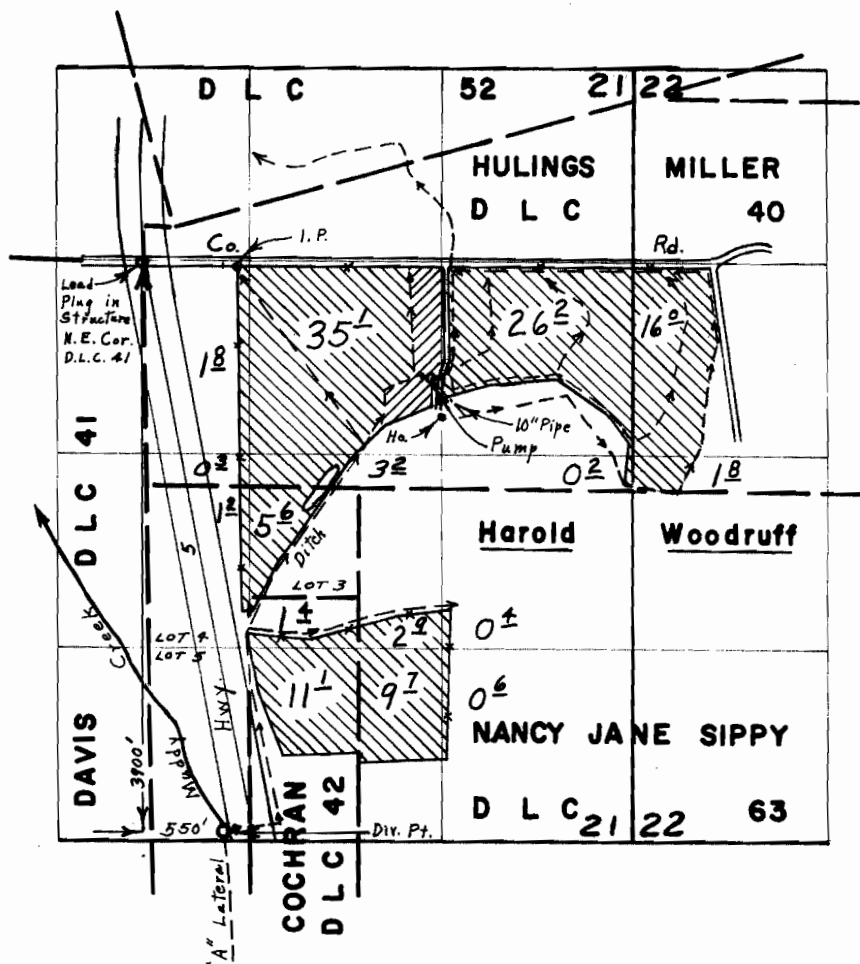


FINAL PROOF SURVEY
UNDER

Application No. 17802 Permit No. 17510
IN NAME OF
MUDDY CREEKS IRRIGATION PROJECT

Surveyed July 7 1966, by L. E. Gould

T.16S.R.3W.W.M.

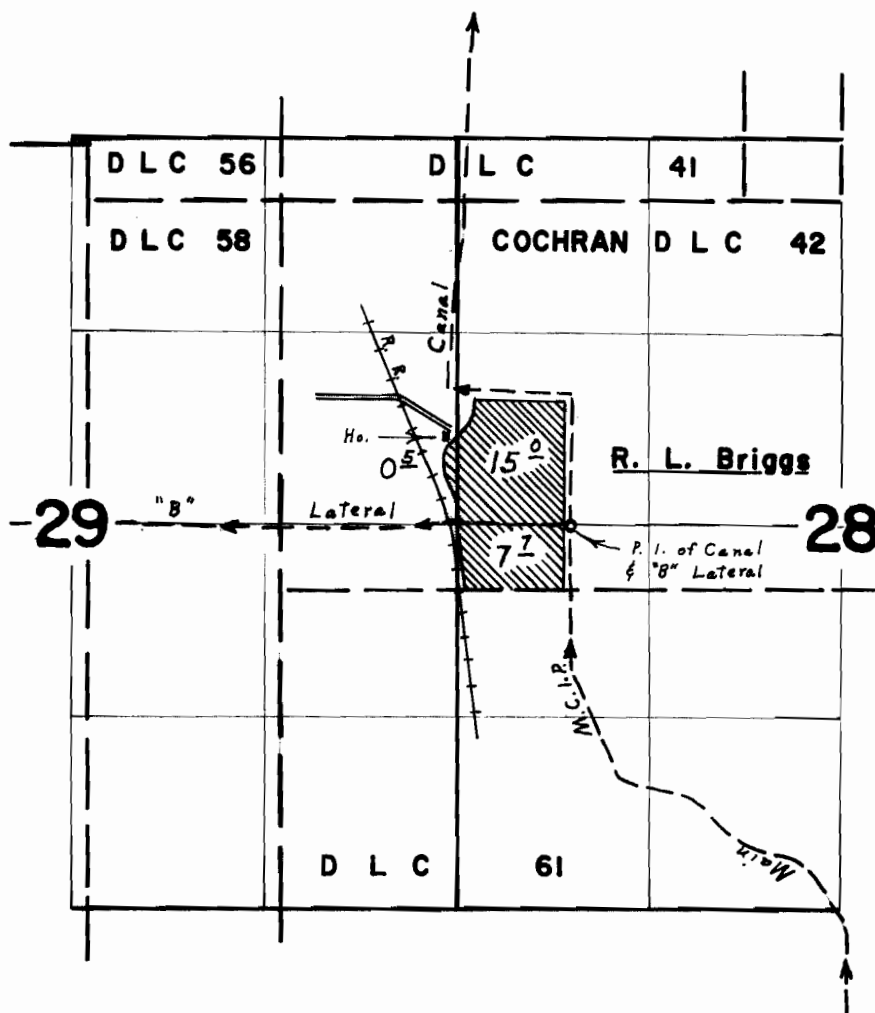


FINAL PROOF SURVEY

UNDER

Application No. 17802 Permit No. 17510
IN NAME OF
MUDDY CREEKS IRRIGATION PROJECT

Surveyed June 15 1966, by L. E. Gould

T.16S.R.3W.W.M.

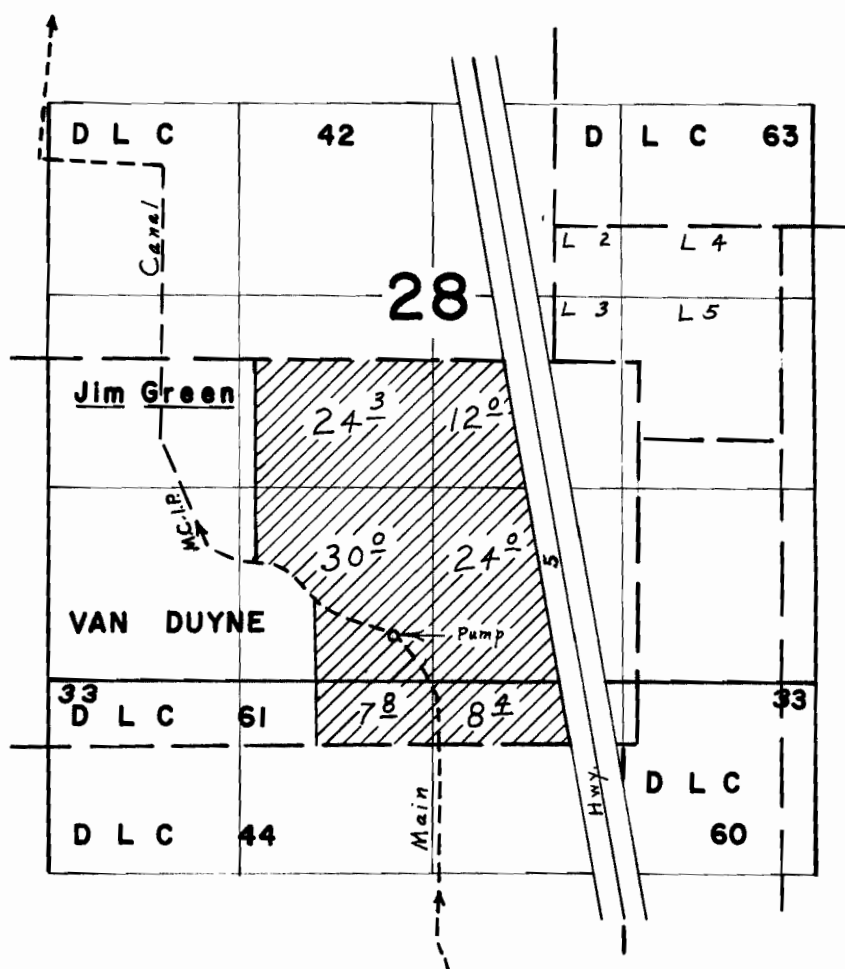


FINAL PROOF SURVEY
UNDER

Application No. 17802 Permit No. 17510
IN NAME OF
MUDDY CREEKS IRRIGATION PROJECT

Surveyed July 8, 1966, by L. E. Gould

T.16S.R.3W.W.M.

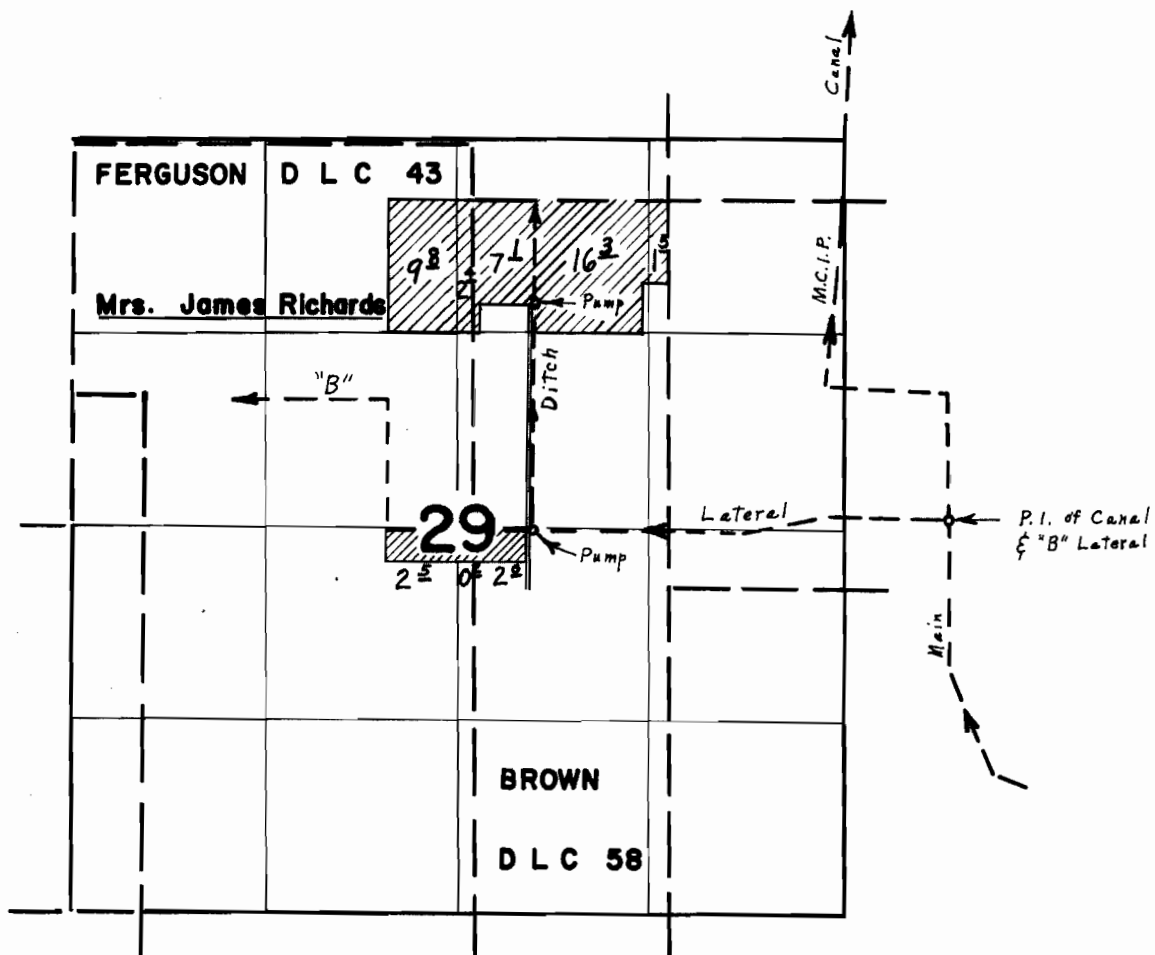


FINAL PROOF SURVEY
UNDER

Application No. 17802 Permit No. 17510
IN NAME OF
MUDDY CREEKS IRRIGATION PROJECT

Surveyed June 14, 1966, by L. E. Gould

T.16S.R.3W.W.M.

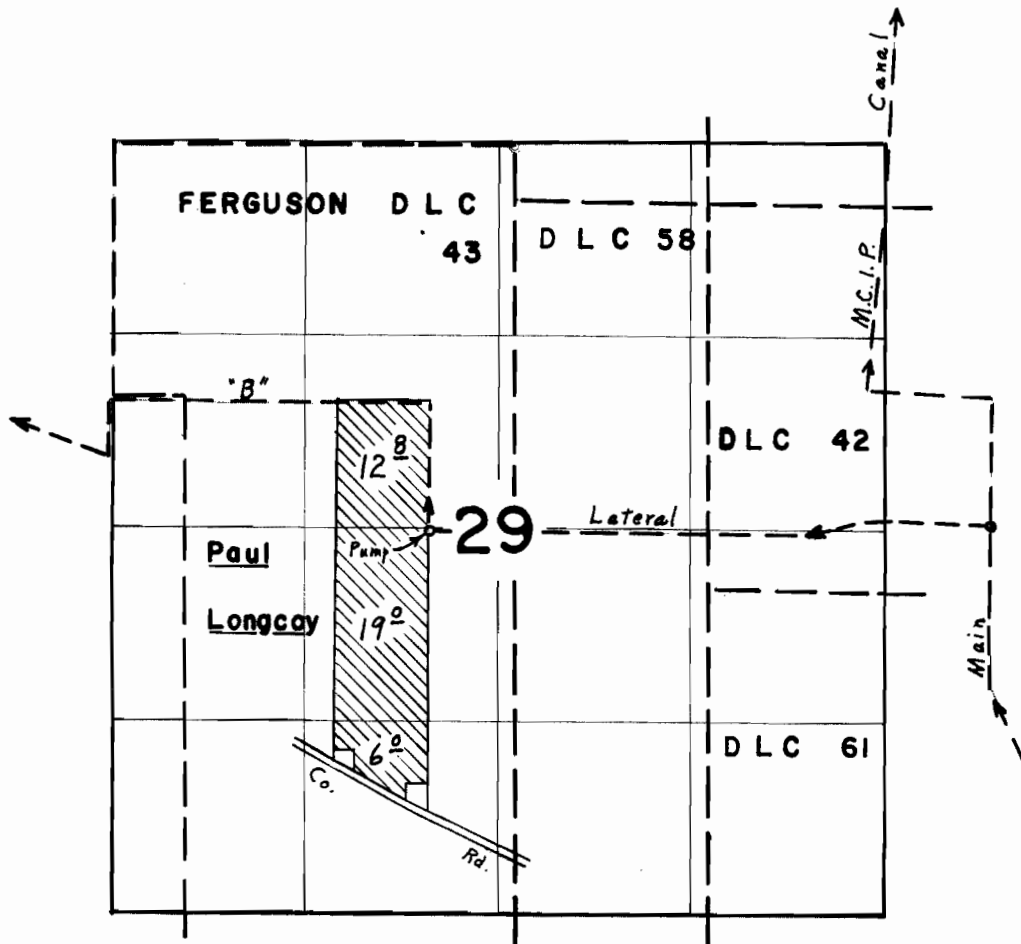


FINAL PROOF SURVEY UNDER

Application No. 17802 Permit No. 17510
IN NAME OF
MUDDY CREEKS IRRIGATION PROJECT

Surveyed June 14 1966, by L. E. Gould

T.16S.R.3W.W.M.

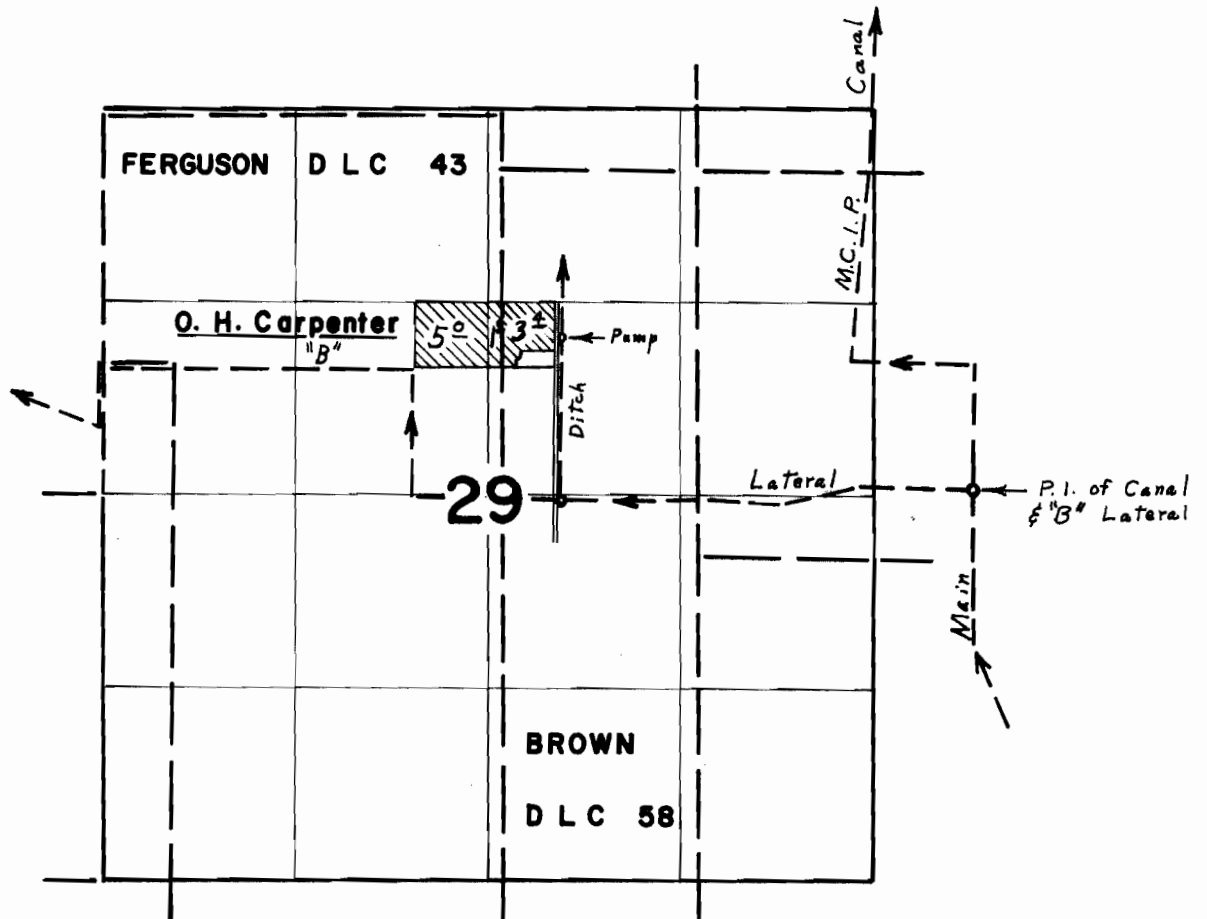


FINAL PROOF SURVEY
UNDER

Application No. 17802 Permit No. 17510
IN NAME OF
MUDDY CREEKS IRRIGATION PROJECT

Surveyed June 14 1966, by L. E. Gould

T.16S.R.3W.W.M.

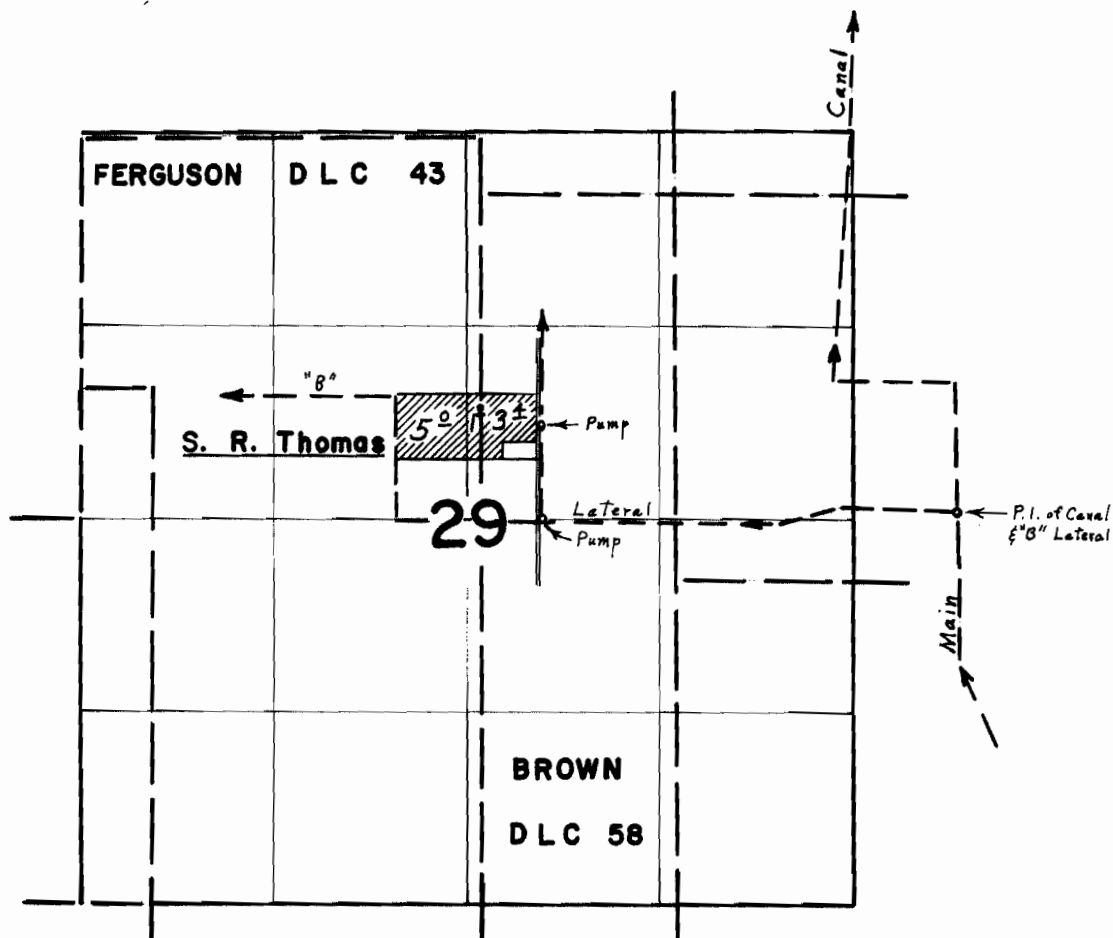


FINAL PROOF SURVEY
UNDER

Application No. 17802 Permit No. 17510
IN NAME OF
MUDDY CREEKS IRRIGATION PROJECT

Surveyed June 14, 1966, by L. E. Gould

T.16S.R.3W.W.M.

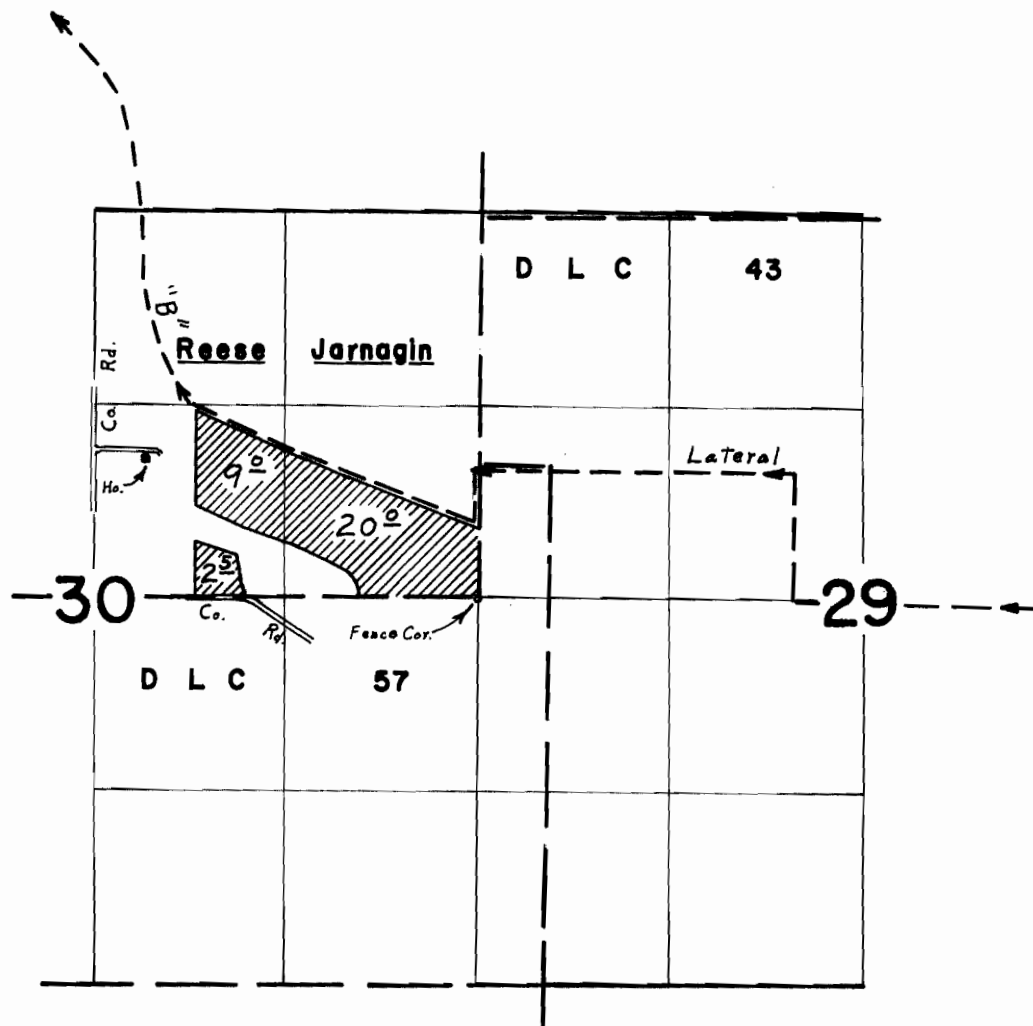

FINAL PROOF SURVEY


UNDER

Application No. 17802 Permit No. 17510
IN NAME OF

MUDDY CREEKS IRRIGATION PROJECT

Surveyed June 15, 1966, by L. E. Gould.....

T.16&17S.R.3W.W.M.

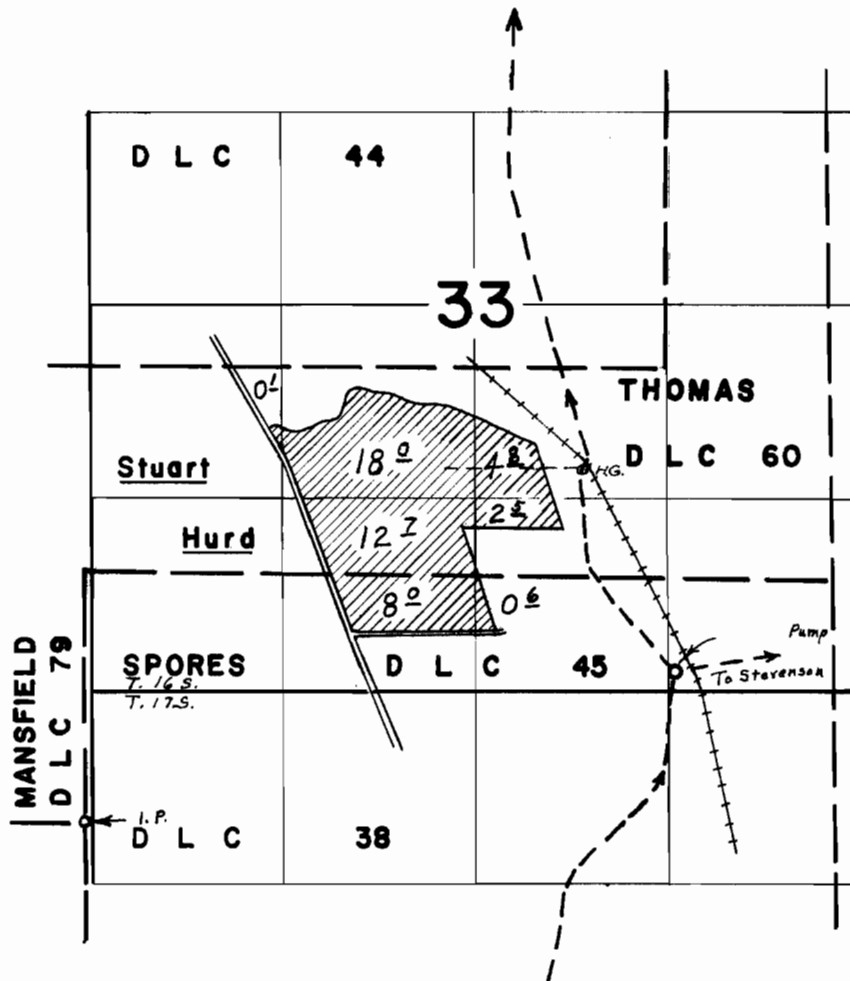

FINAL PROOF SURVEY


UNDER

Application No. 17802 Permit No. 17510
IN NAME OF

MUDDY CREEKS IRRIGATION PROJECT

Surveyed May 26 1966, by L. E. Gould

T.16&17S.R.3W.W.M.

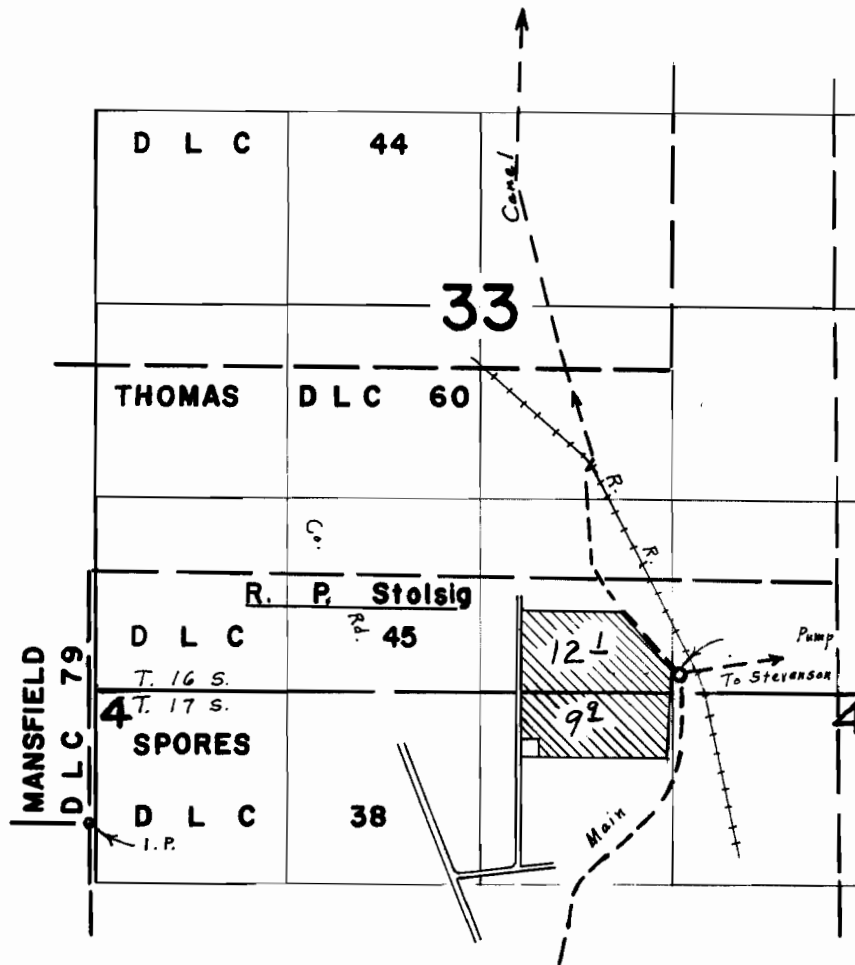


FINAL PROOF SURVEY
UNDER

Application No. 17802 Permit No. 17510
IN NAME OF

MUDDY CREEKS IRRIGATION PROJECT

Surveyed June 15, 1966, by L. E. Gould

T.15 & 16 S. R. 4 W.W.M.

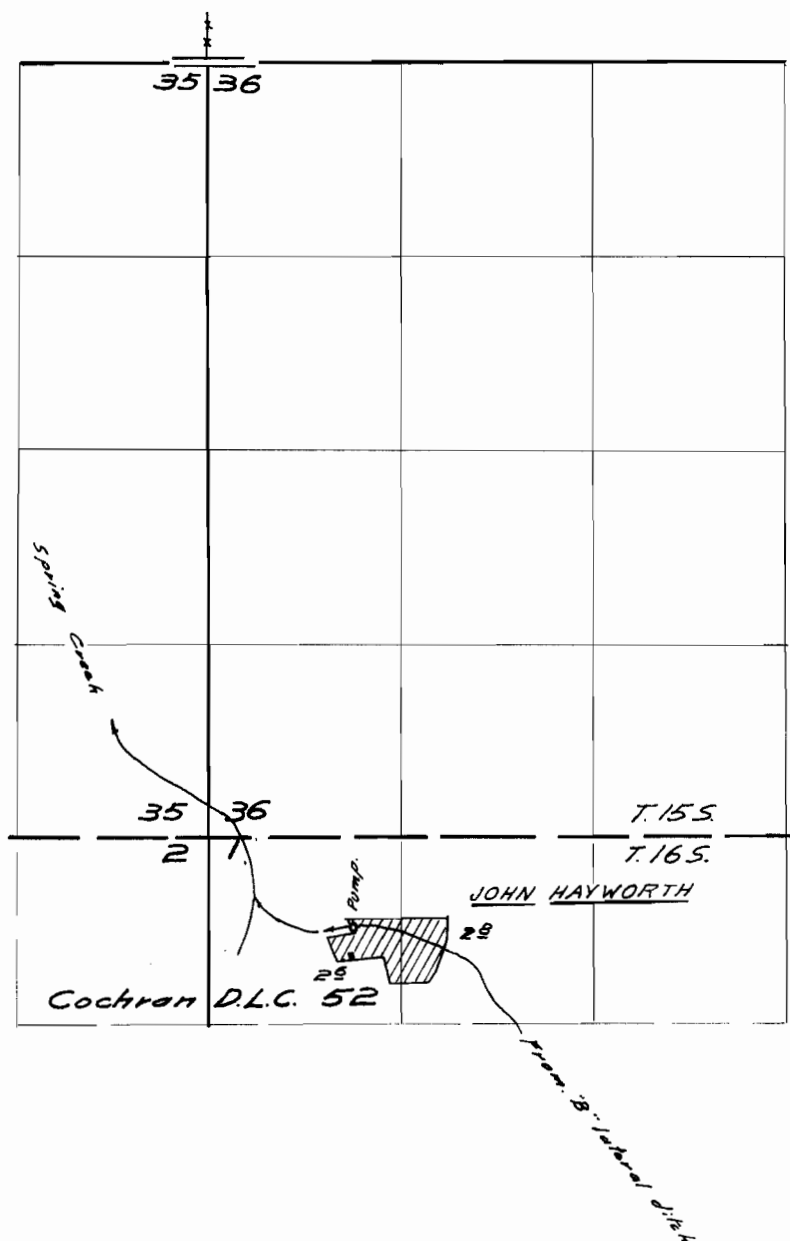


FINAL PROOF SURVEY
UNDER

Application No. 17802 Permit No. 17510
IN NAME OF

MUDDY CREEKS IRRIGATION PROJECT

Surveyed July 16, 1966, by W.D. Ruppert

T. 16S. R. 4W. W.M.

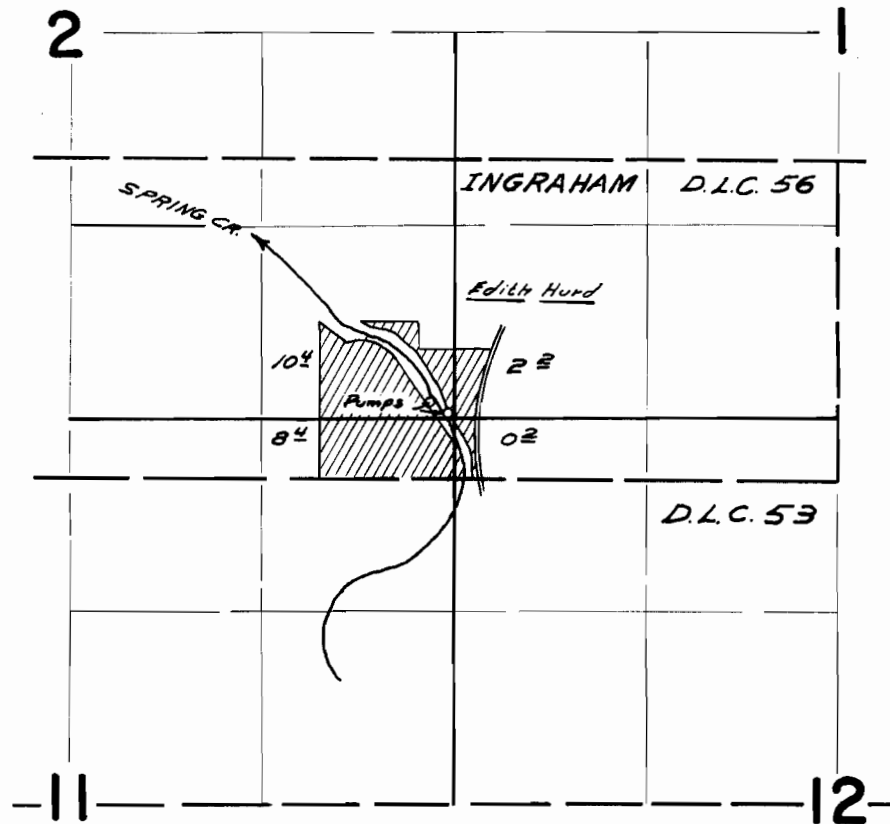


FINAL PROOF SURVEY
UNDER

Application No. 17802 Permit No. 17510
IN NAME OF

MUDDY CREEKS IRRIGATION PROJECT

Surveyed June 16, 1966, by W. J. Ruppert

T.16S. R.4W. W.M.

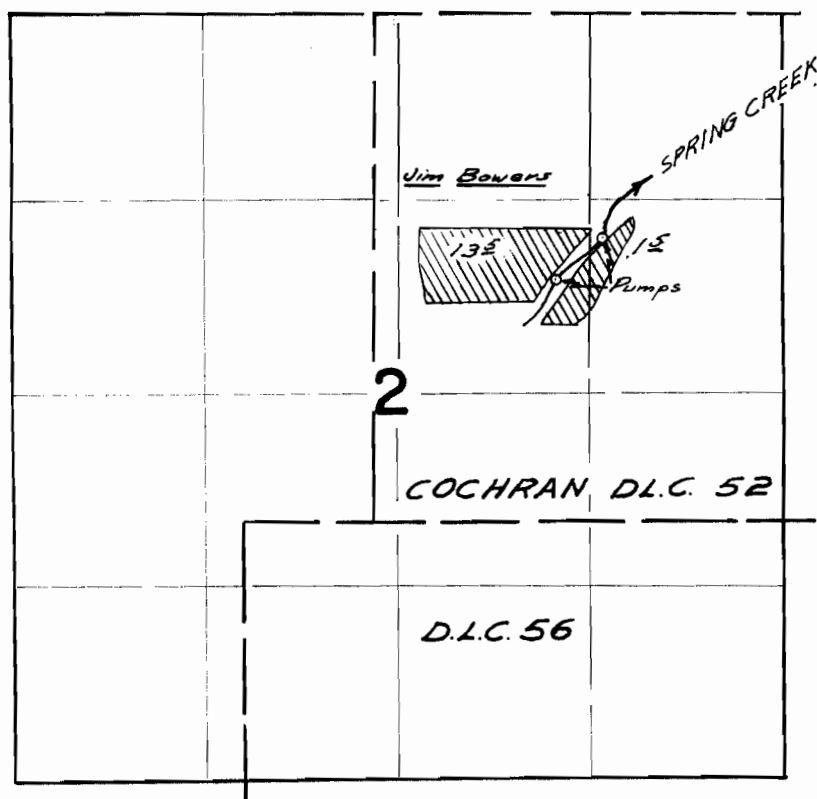


FINAL PROOF SURVEY
UNDER

Application No. 17802 Permit No. 17510
IN NAME OF

MUDDY CREEKS IRRIGATION PROJECT

Surveyed June 16 1966, by W. J. Ruppert

T.16 S. R.4 W. W.M.

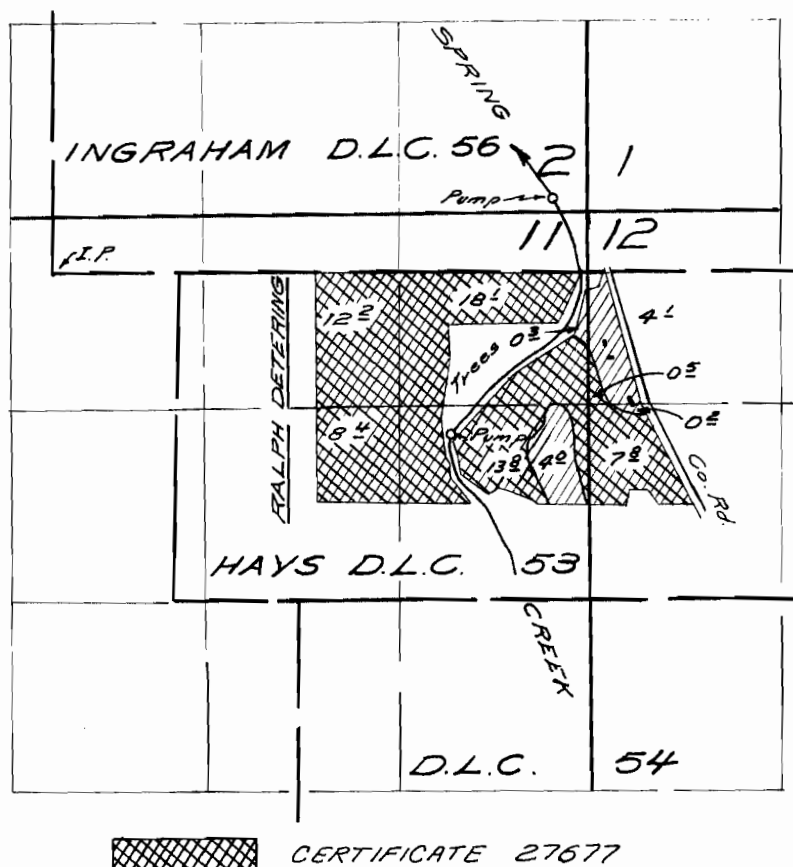


FINAL PROOF SURVEY UNDER

Application No. 17802 Permit No. 17510
IN NAME OF

MUDDY CREEKS IRRIGATION PROJECT

Surveyed March 24, 1967, by W. d. Rupperts

T. 16 S. R. 4 W. W.M.

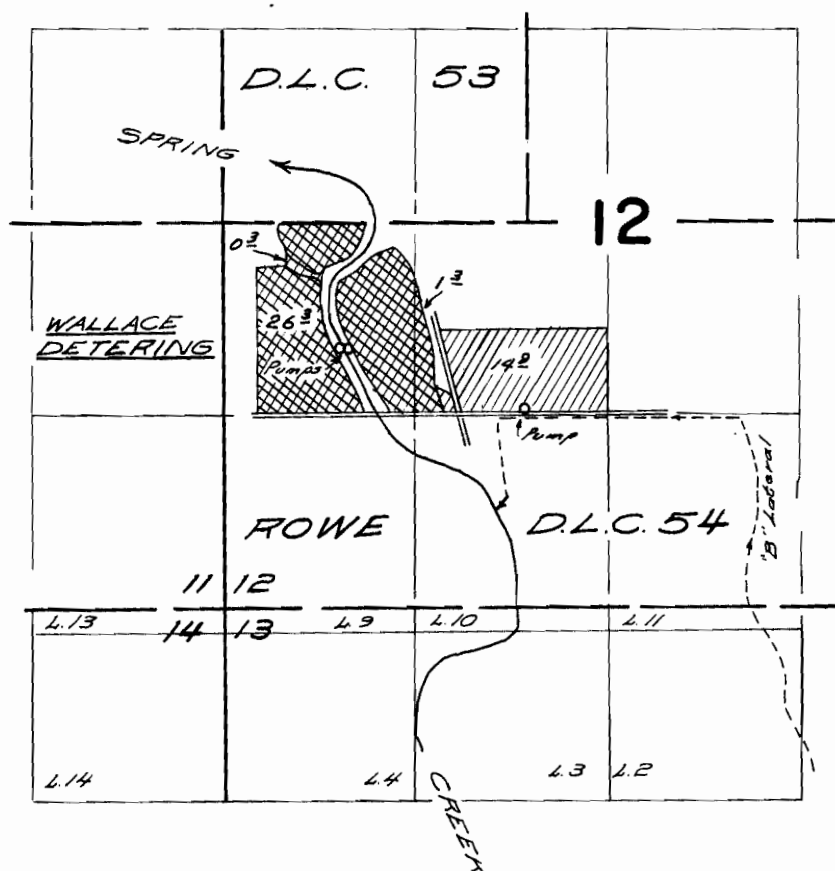

CERTIFICATE 27674


FINAL PROOF SURVEY
UNDER

Application No. 17802 Permit No. 17510
IN NAME OF

MUDDY CREEKS IRRIGATION PROJECT

Surveyed June 16 1966 by W. J. Ruppert

T.16S.R.4W.W.M.

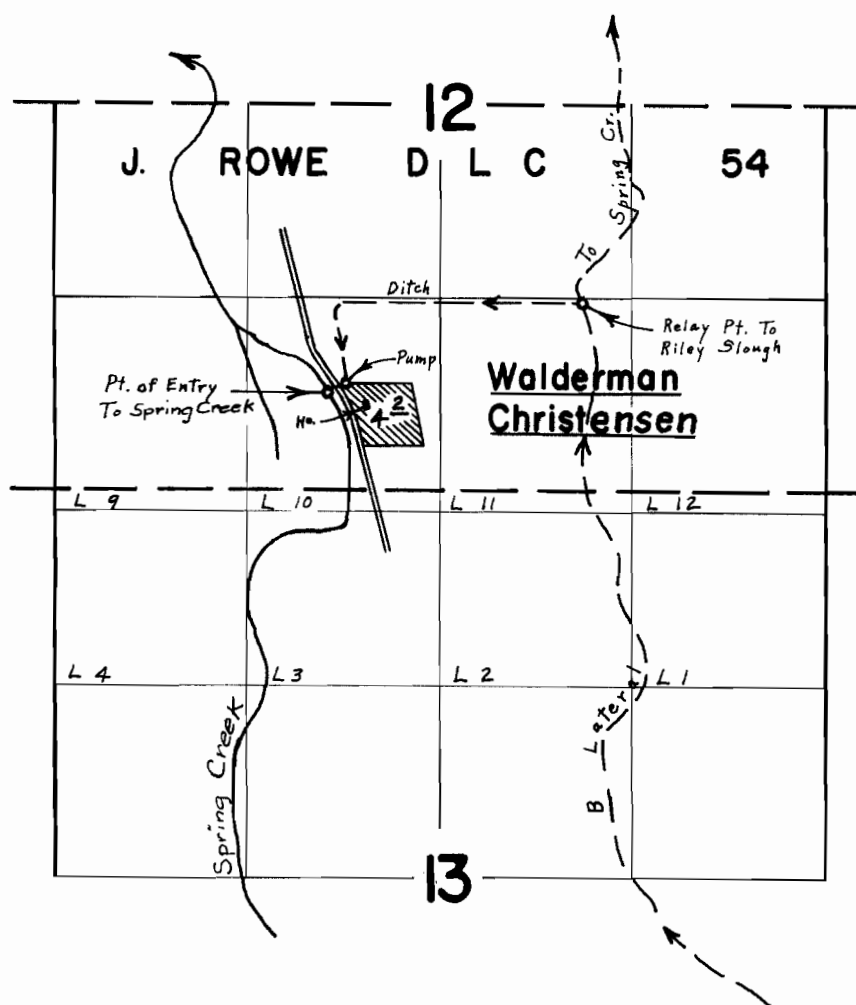


FINAL PROOF SURVEY
UNDER

Application No. 17802 Permit No. 17510
IN NAME OF
MUDDY CREEKS IRRIGATION PROJECT

Surveyed July 8, 1966, by L. E. Gould

T.16 S.R.38&4 W.W.M.

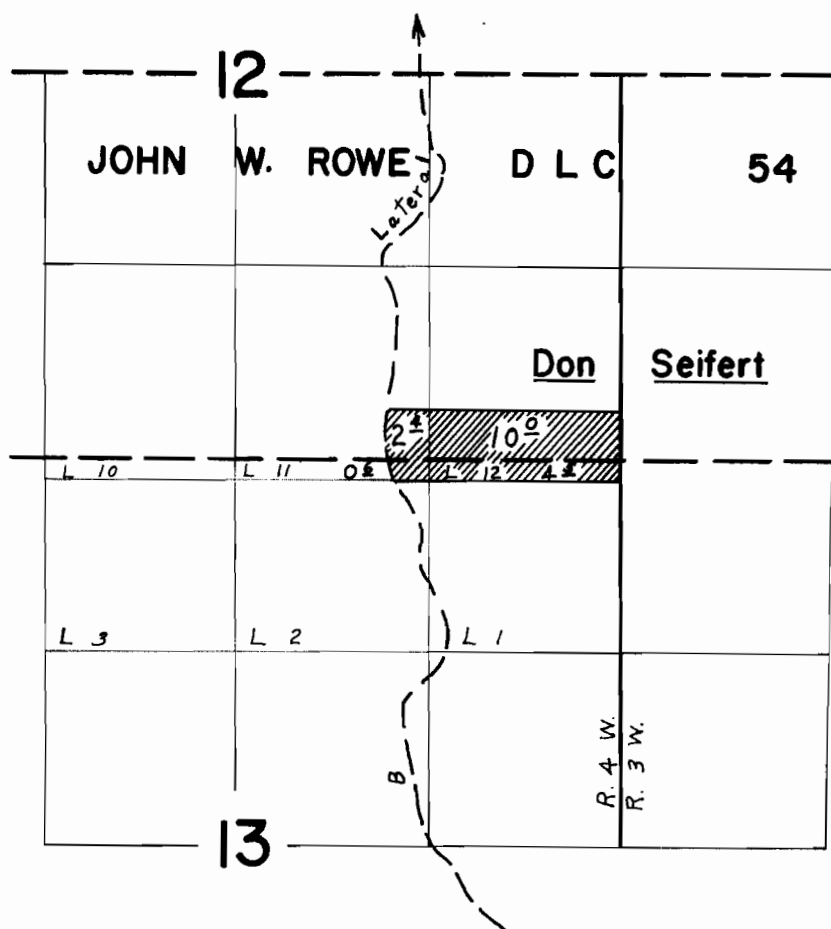


FINAL PROOF SURVEY
UNDER

Application No. 17802 Permit No. 17510
IN NAME OF
MUDDY CREEKS IRRIGATION PROJECT

Surveyed July 8, 1966, by L. E. Gould

T.16S.R.4W.W.M.

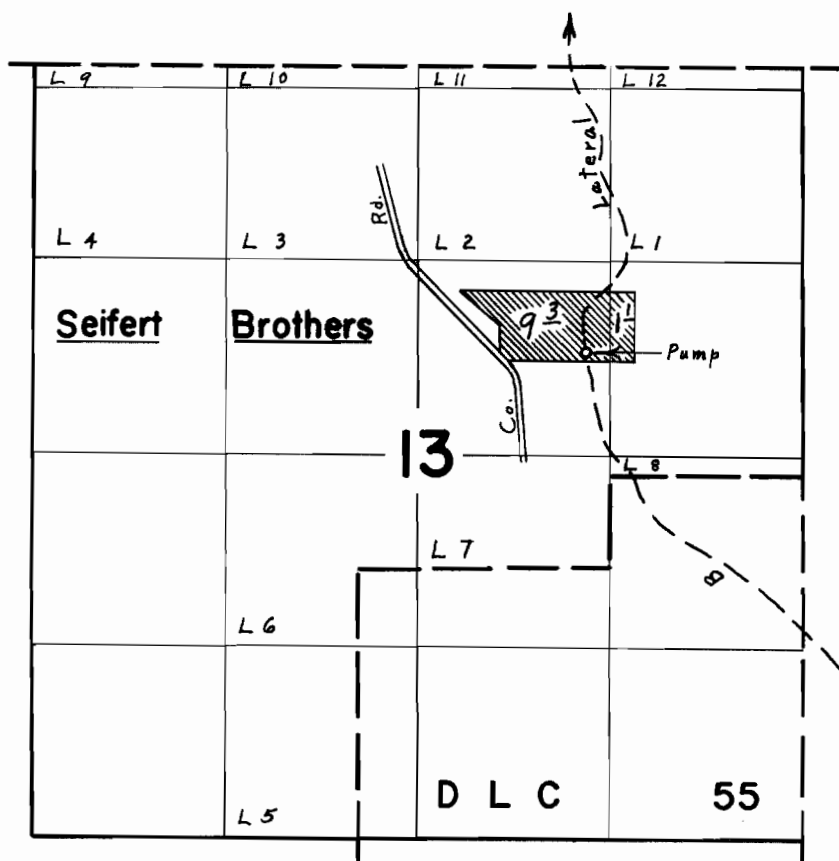


FINAL PROOF SURVEY
UNDER

Application No. 17802 Permit No. 17510
IN NAME OF
MUDDY CREEKS IRRIGATION PROJECT

Surveyed July 8, 1966, by L. E. Gould

T.17 S.R.3 W.W.M.

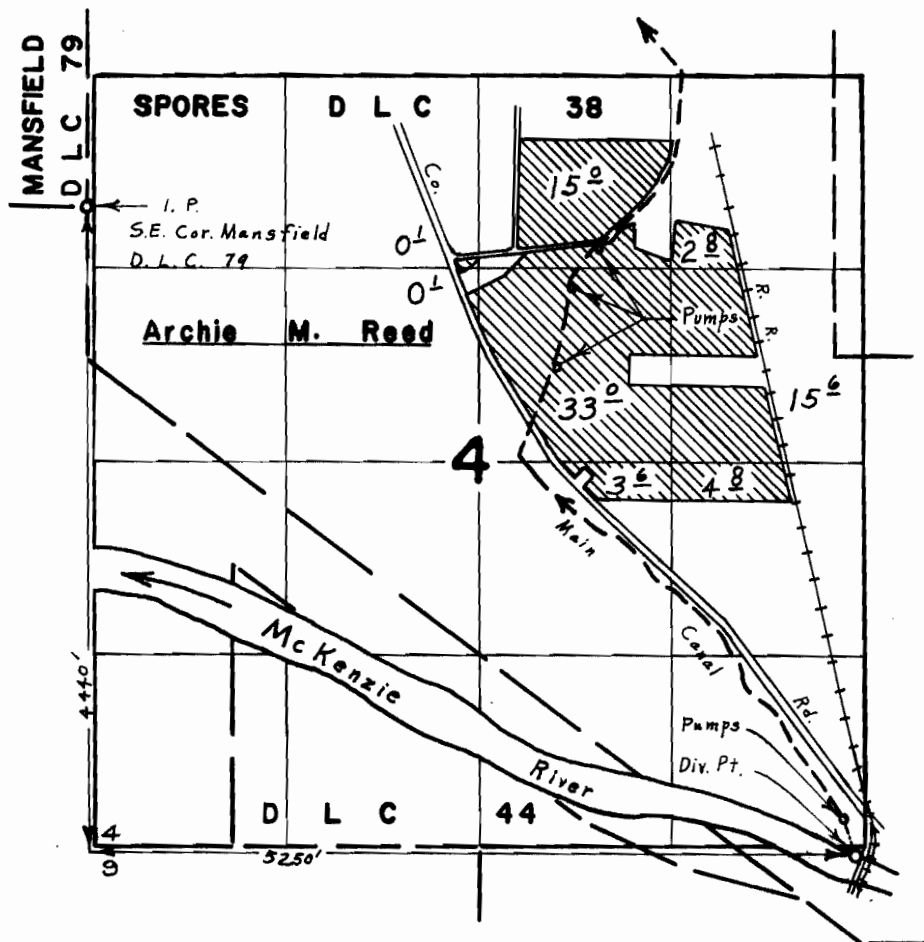

FINAL PROOF SURVEY
UNDER

Application No. 17802 Permit No. 17510
IN NAME OF
MUDDY CREEKS IRRIGATION PROJECT

Surveyed May 26 1966, by L. E. Gould