


City of John Day Water Utility Examiner
 #1101
 J.
 2
 GRAYSON
 6-1-24



311 B Avenue, Suite P
 Lake Oswego, OR 97034
 (503) 954-1326

Att 1 - Claim of Beneficial Use Map
App G-15640, Permit G-15101
T13S, R31E, Sec 21-23, 25-29, 34
T13S, R32E, Sec 30

1	DATE	AUTH	DRAFT
No.	Date	By	Revisions

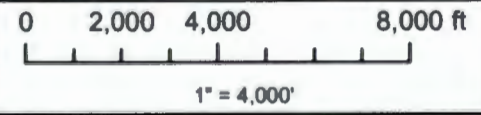

Proj#: 2111006
CJD Claim of Beneficial Use
 City of John Day
 450 E Main Street
 John Day, OR 97845

- Well-5 (GRAN-50574)
- ▨ City of John Day UGB
- Conveyance
- Other City Wells
- ▲ Pump Stations
- Reservoirs

Received
 MAY 17 2024
 OWRD