
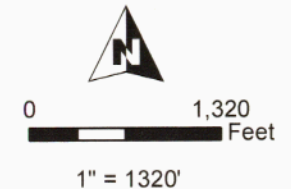


Received
SEP 26 2024

OWRD

T19S R24E, WM,
CROOK COUNTY, OR
&
T19S R25E, WM
HARNEY COUNTY, OR

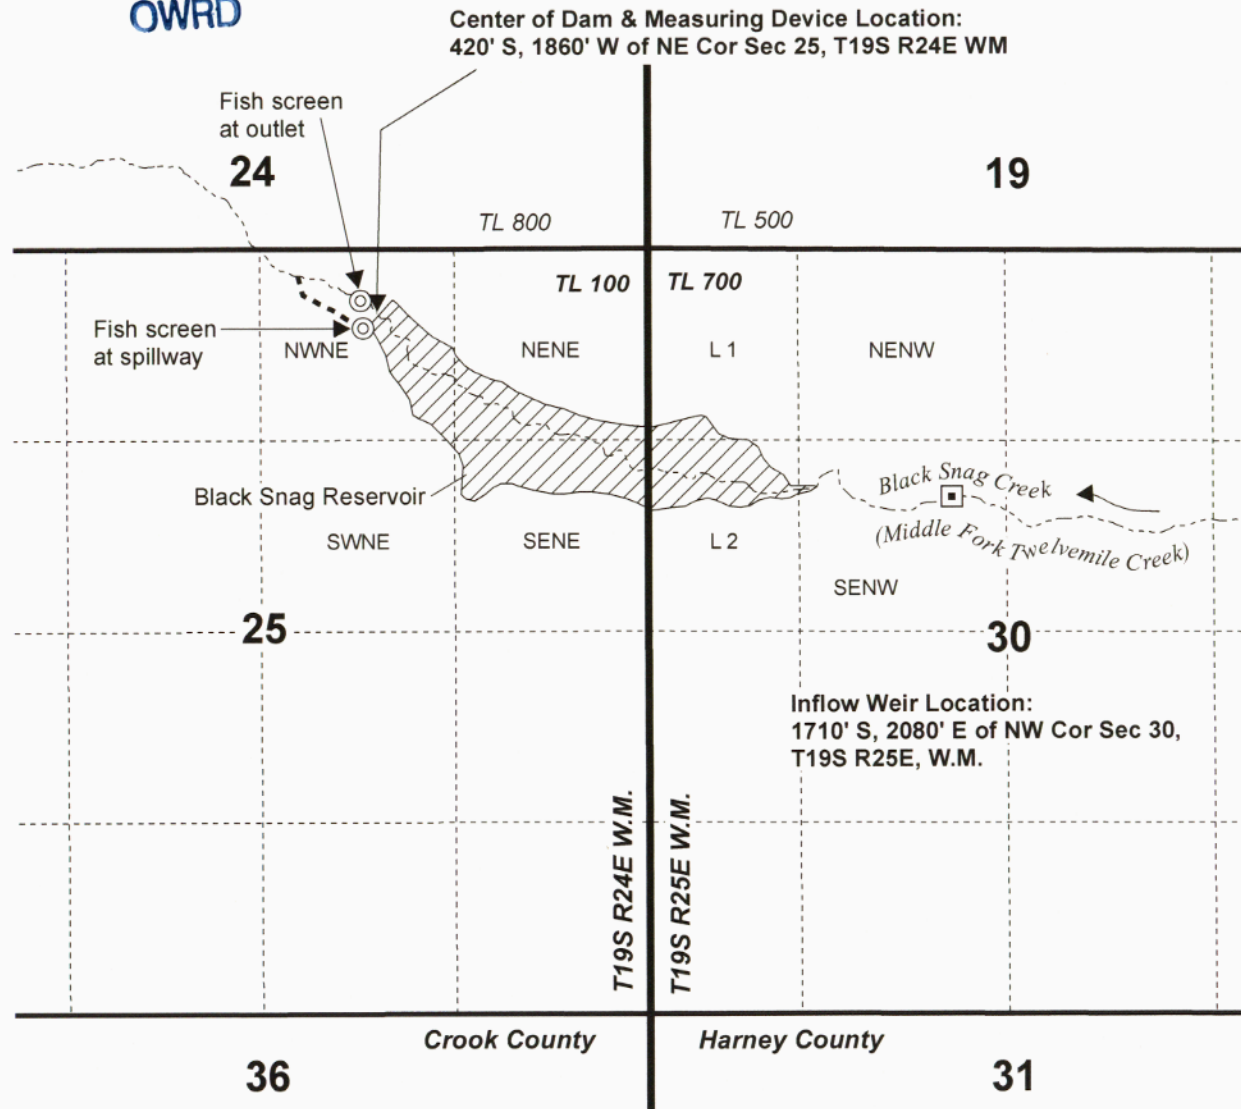

- Weir
- ⊙ Fish screen
- Spillway
- Creek
- ▨ Storage for Fish, Recreation, and Livestock
- ▭ Township
- ▭ Section
- Quarter Quarter
- ▭ Tax Lot



**CLAIM OF BENEFICIAL USE MAP
GI RANCH**

Date: 9/17/2024 Ap R-71909 Permit R-13158

Project #24025

This map is not intended
to provide legal dimensions
or locations of property
ownership lines.

WATER RIGHT SERVICES, LLC
PO BOX 1830, BEND, OR 97709
WWW.OREGONWATER.US CCB # 197121
johnshort@usa.com 541-389-2837