


T.7S. R.2W. Sec. 7 and 18

DLC 48

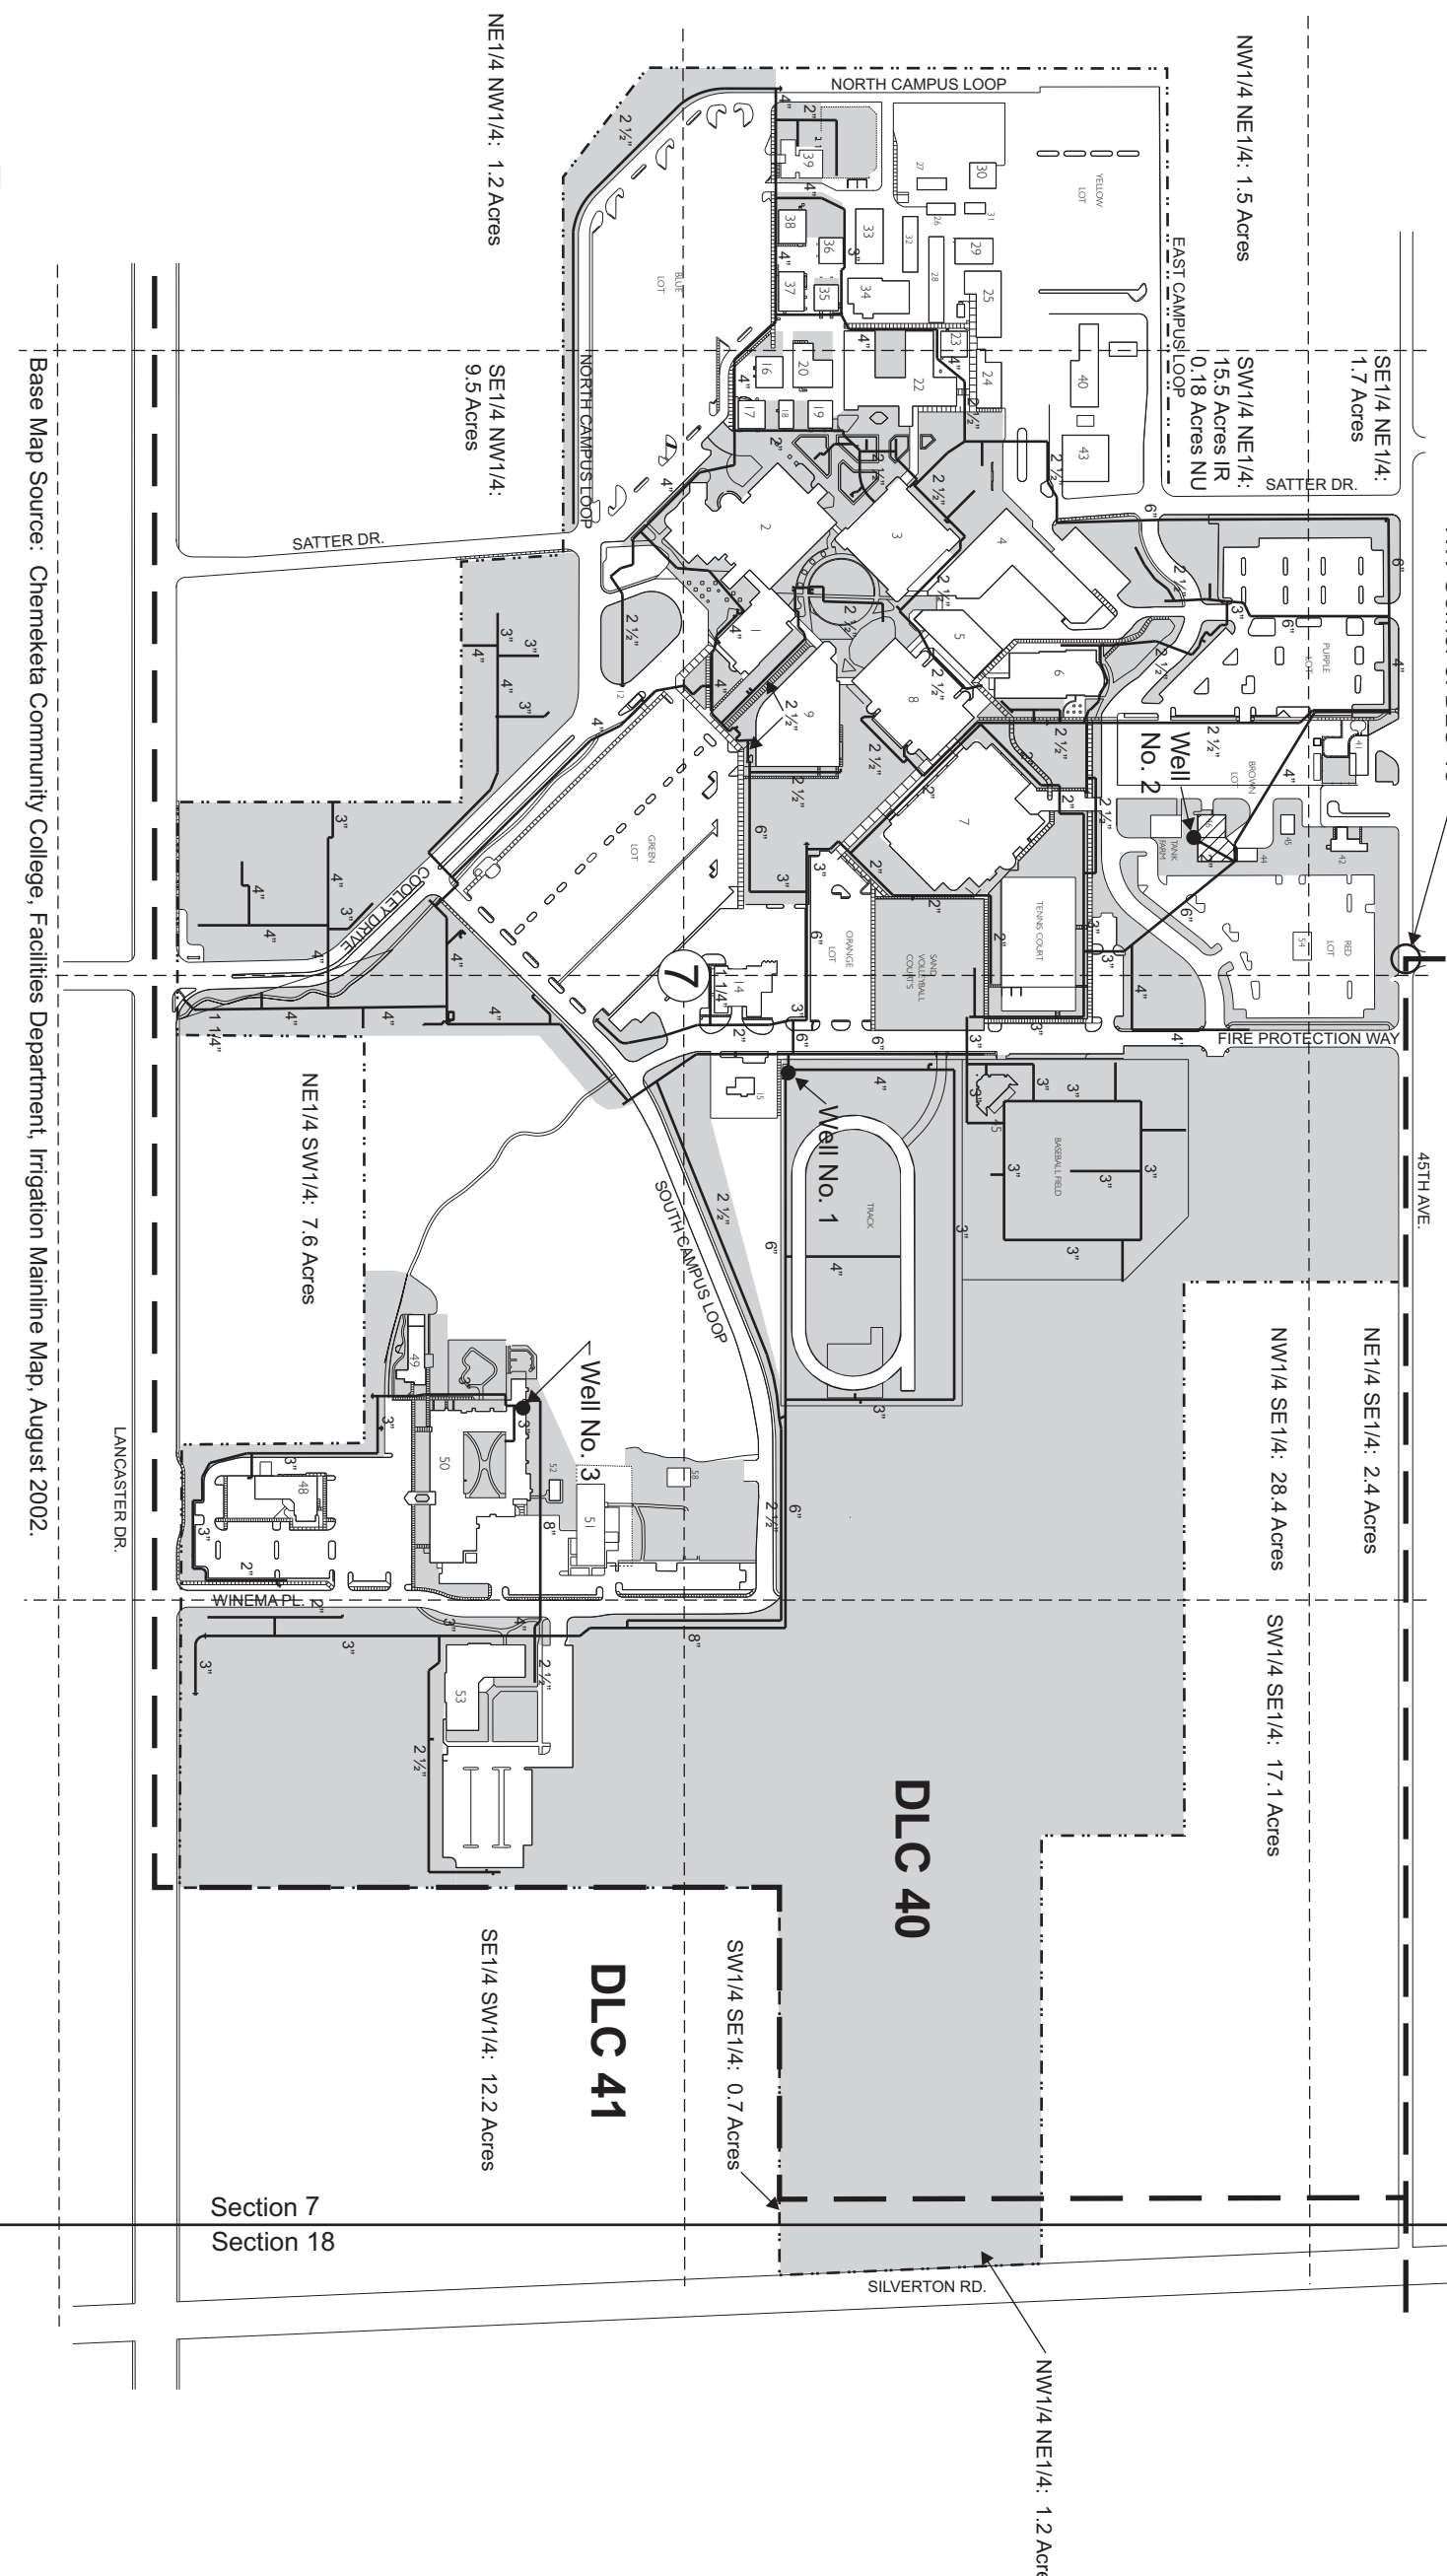


Well Locations From Northwest Corner of DLC 48:

Well No. 1 - 240 feet south and 1,310 feet west

Well No. 2 - 260 feet north and 450 feet west

Well No. 3 - 955 feet south and 1,870 feet west

This map was prepared for the purpose of identifying the location of a water right only and is not intended to provide legal dimensions or location of property ownership lines.

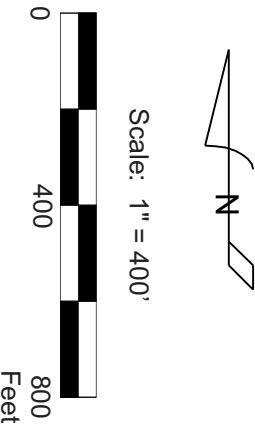

Pacific Hydro-Geology Inc.

Claim of Beneficial Use Map

Chemeketa Community College

T.7S. R.2W. Sec. 7 and 18

Rev. 01/ 2025