

CLAIM OF BENEFICIAL USE

GROUND WATER PERMIT
FOR NURSERY USE

APPLICATION NUMBER G-18235

PERMIT NUMBER G-17723

ERICH BUER
505 THE TREES ROAD
WILLIAMS, OR 97544

SITUATED IN
SECTION 14, TOWNSHIP 38S, RANGE 5W, W.M



SE NW

CLAIM 4048

160 ACS

THE TREES DRIVE

REFERENCE CORNER
CENTER ¼ SECTION 14

RECEIVED
JUN 01 2020
OWED

LEGEND

POINT OF APPROPRIATION (JOSE 2000)

14

--- PIPELINE

□ PLACE OF USE
0.35 ACS NURSERY

✕ METER, BURIED STORAGE TANK,
4 GPM FLOW RESTRICTOR
120' SOUTH & 40' EAST OF POA

● ADD'L STORAGE TANK



CLAIM 4048 COVERS 160 ACRES

NE ¼ SW ¼

SE ¼ NW ¼

SW ¼ NE ¼

NW ¼ SE ¼

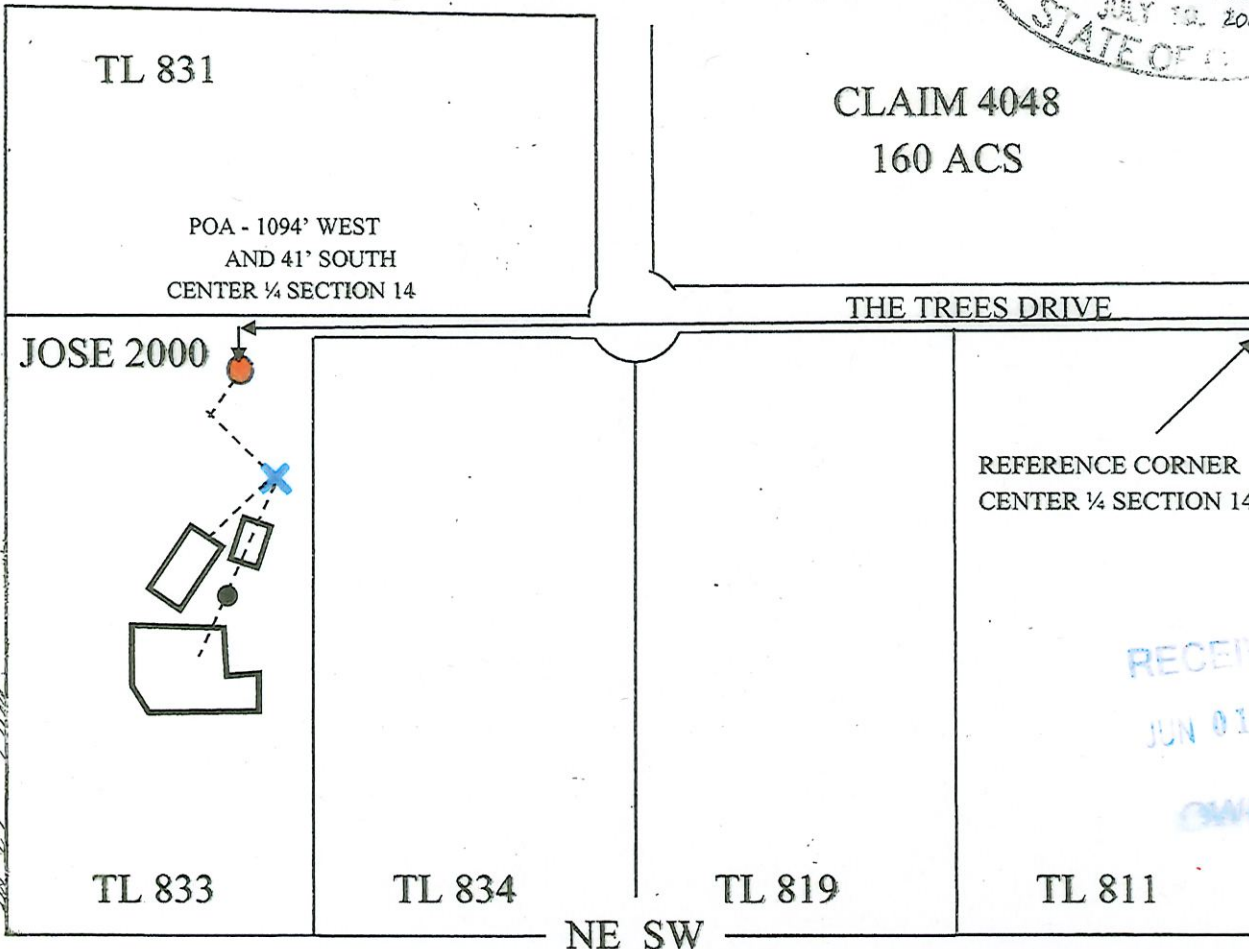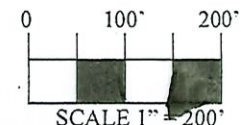

This map is not intended to provide legal
dimensions or locations of property
ownership lines

ParsonsWater Consulting LLC
rick.parsons@parsonwater.com
541.499.0257 303.667.5067

