


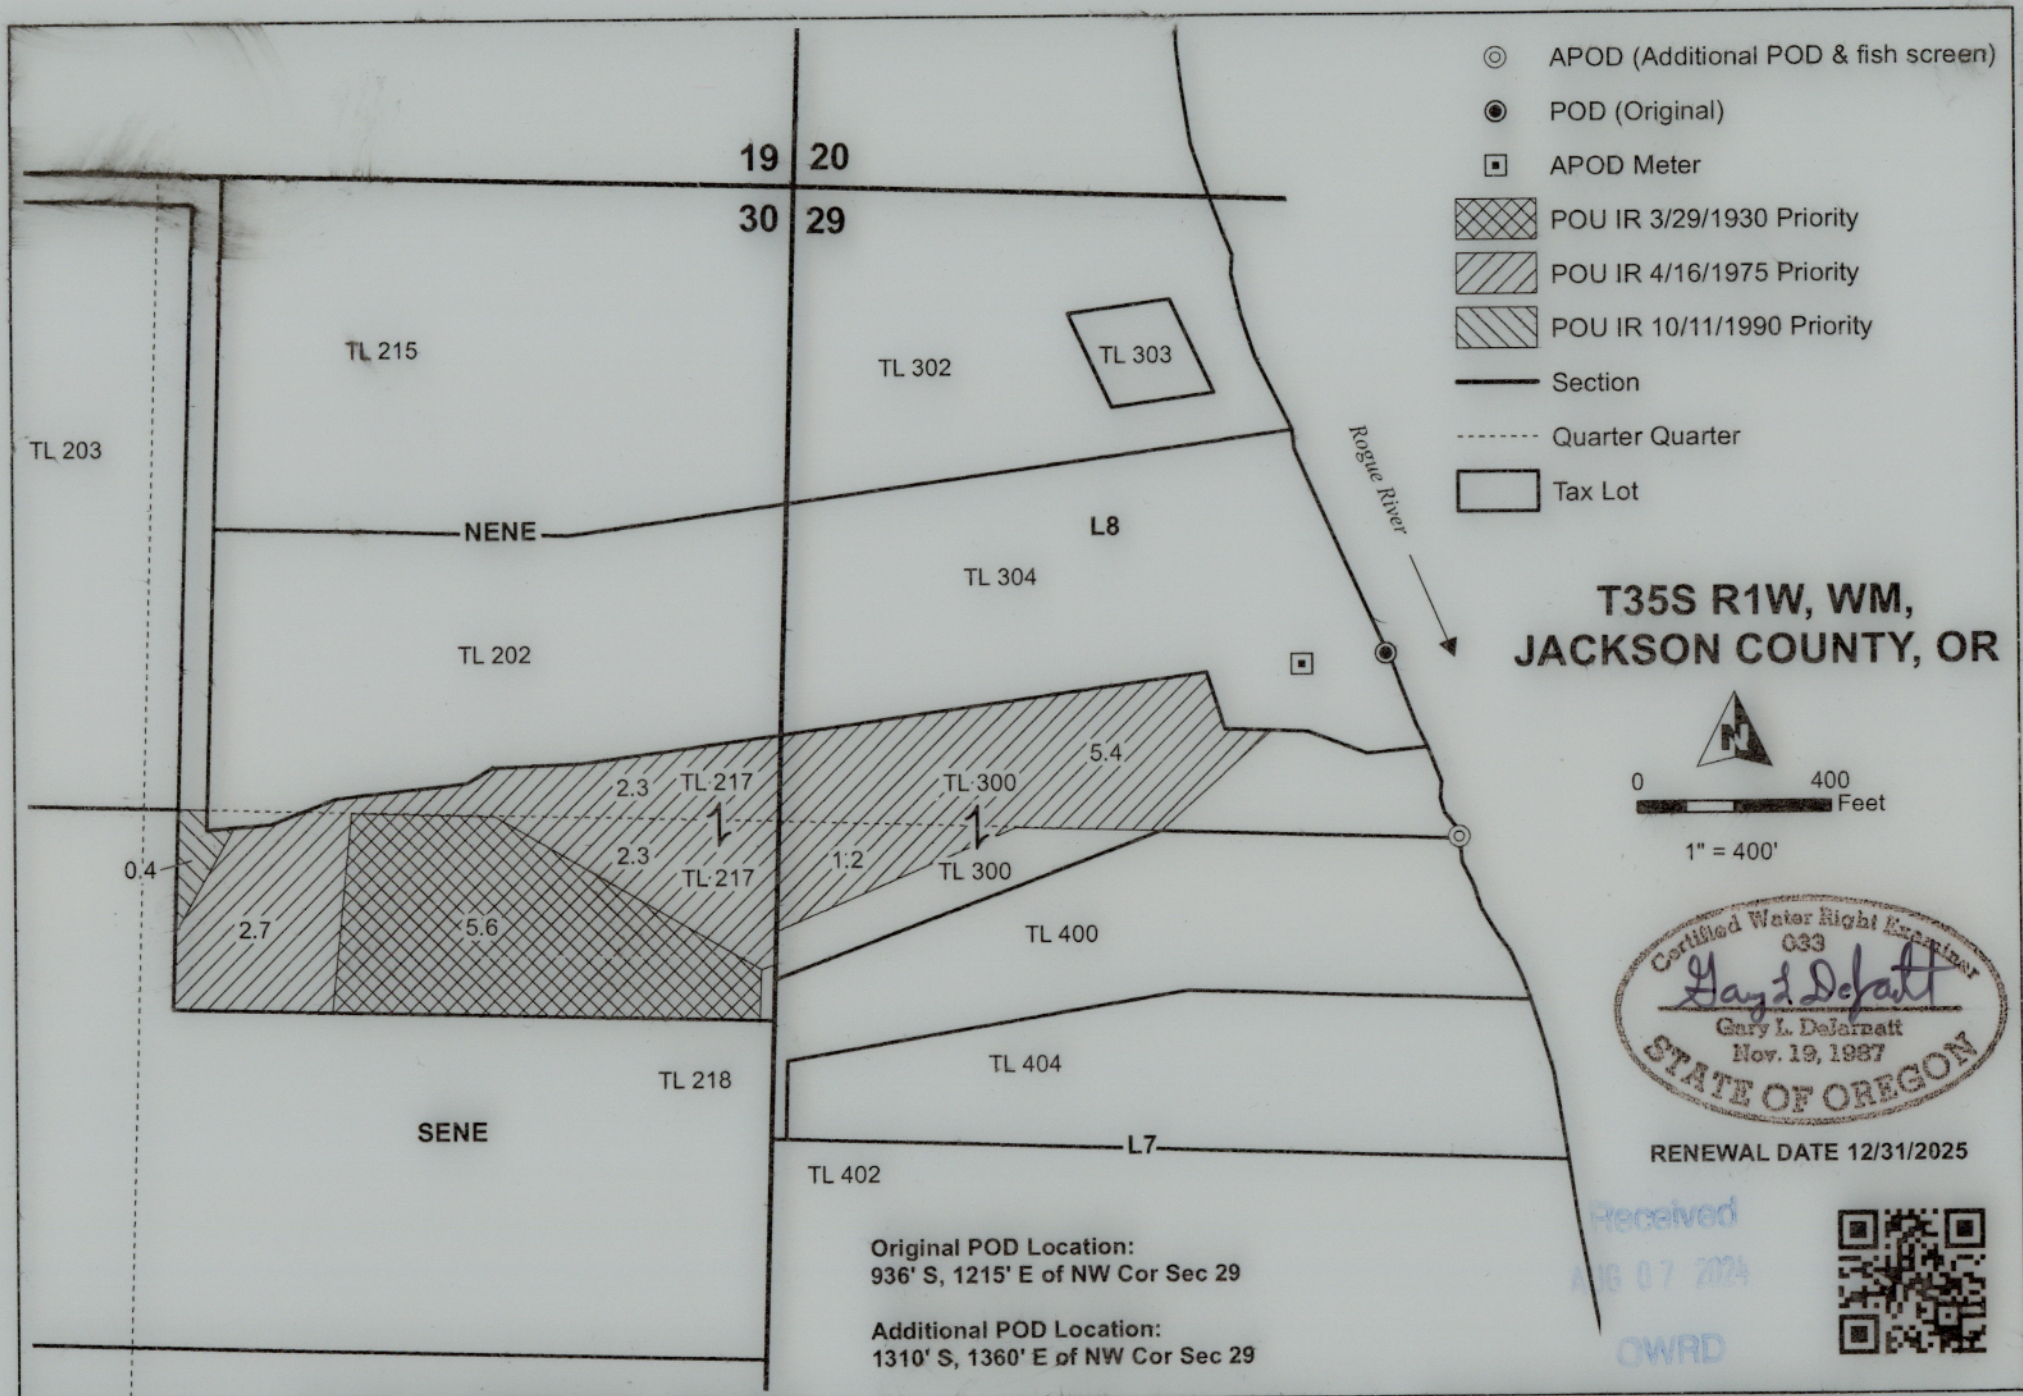

**CLAIM OF BENEFICIAL USE MAP
Desimone**

Date: 6/26/2024

T-8997

Project #24011

This map is not intended
to provide legal dimensions
or locations of property
ownership lines.

WATER RIGHT SERVICES, LLC
PO BOX 1830, BEND, OR 97709
WWW.OREGONWATER.US CCB # 197121
johnshort@usa.com 541-389-2837