


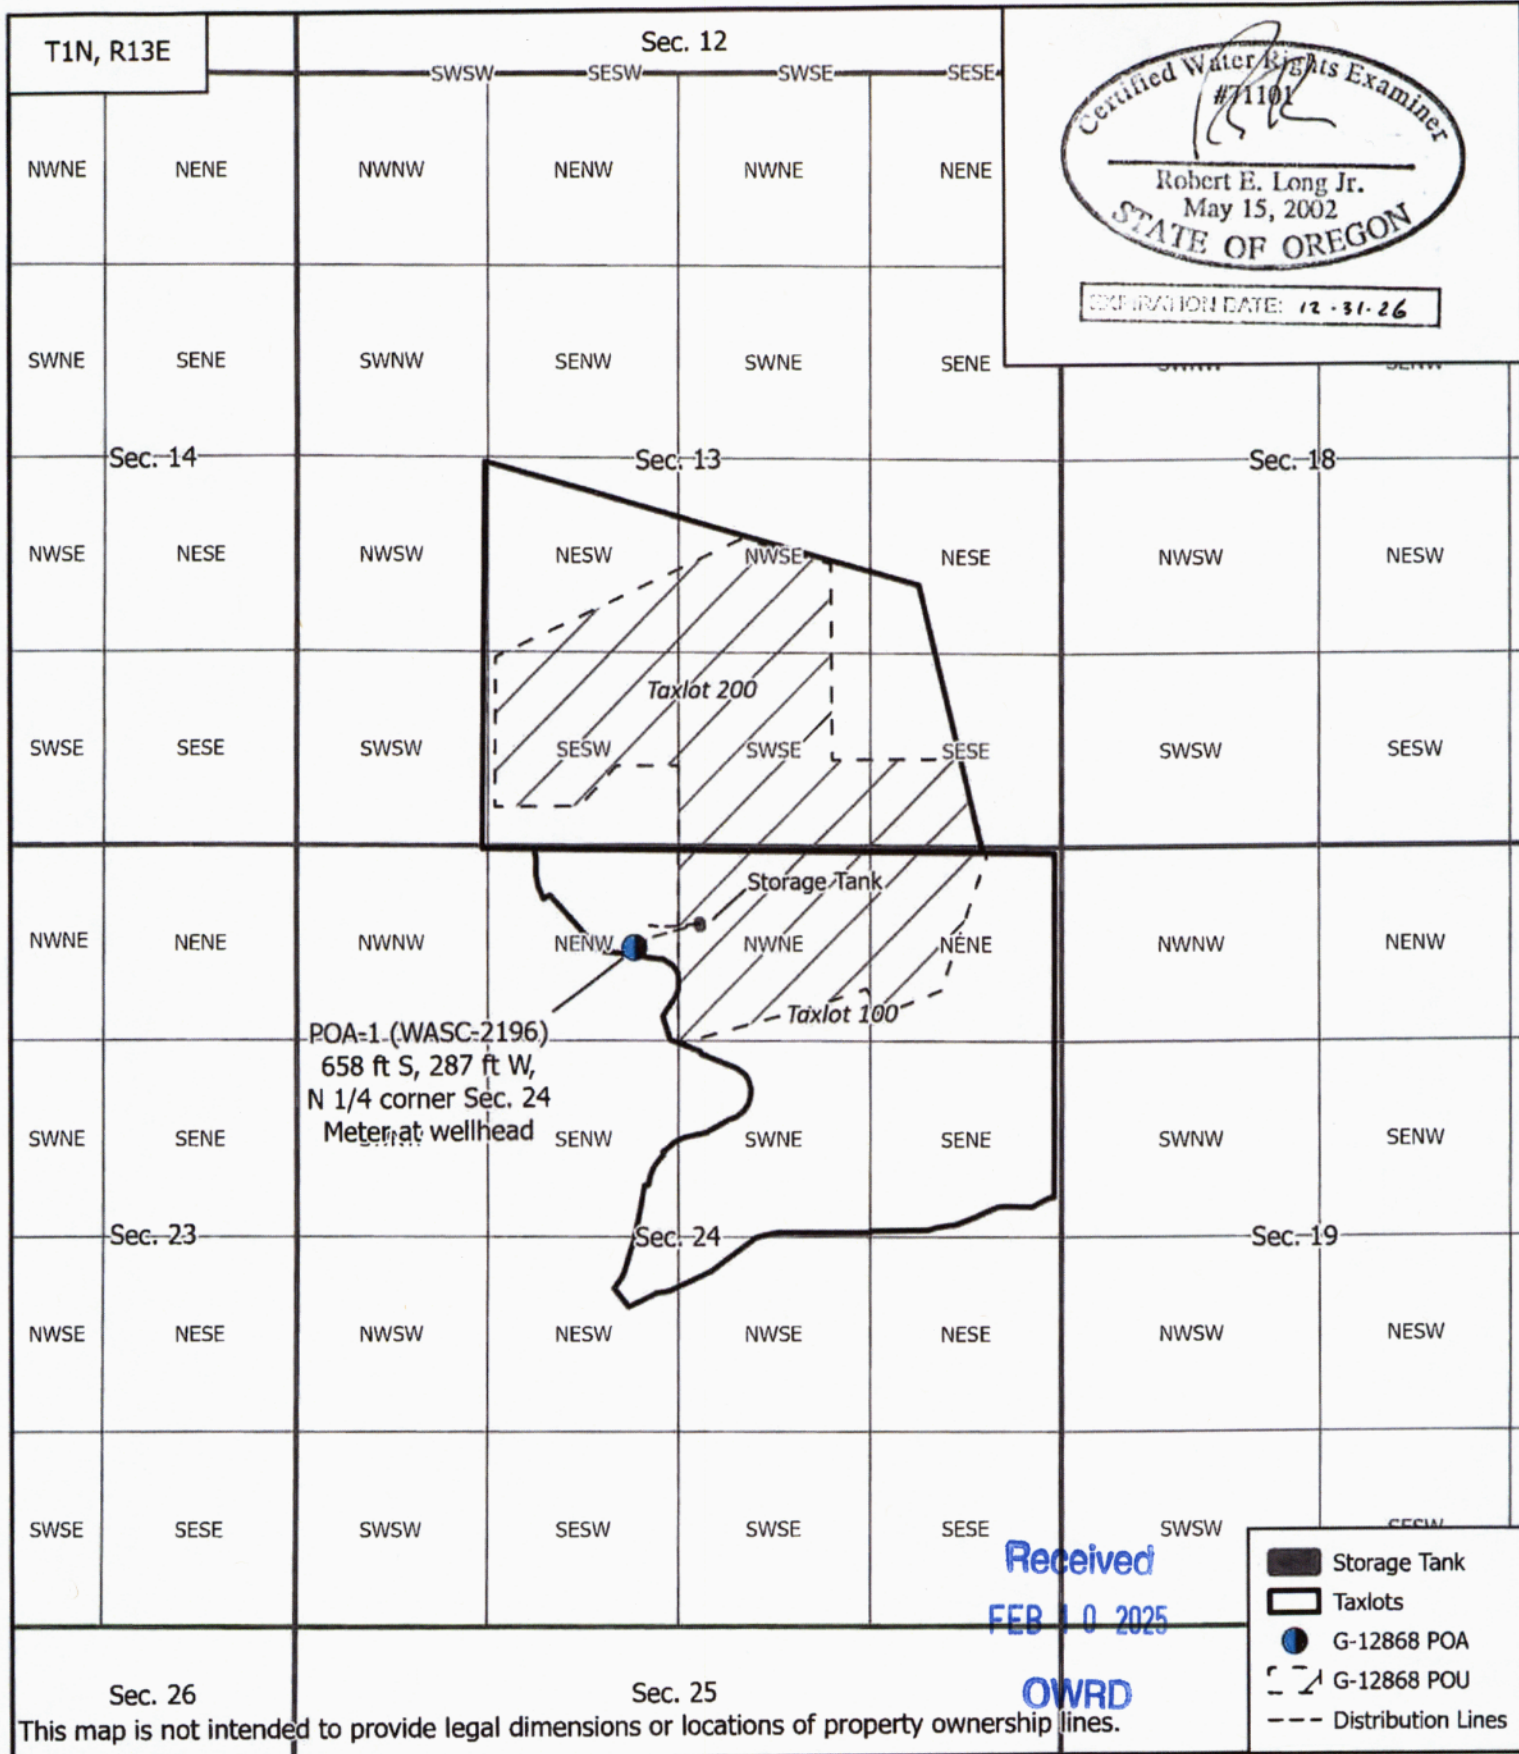

CwM-H2O
Complete Water Management



311 B Avenue, Suite P
Lake Oswego, Oregon 97034
(503) 954-1326

Figure 1
Application G-13708
Permit G-12868
CBU Map

1	DATE	AUTH	DRAFT
No.	Date	By	Revisions

Proj#: 2414001
Wasco County Landfill CBU
Brian Evola, District Manager
Waste Connections, Wasco County Landfill
2550 Steele Road
The Dalles, Oregon 97508