
## IS-72169 Reach Location Map

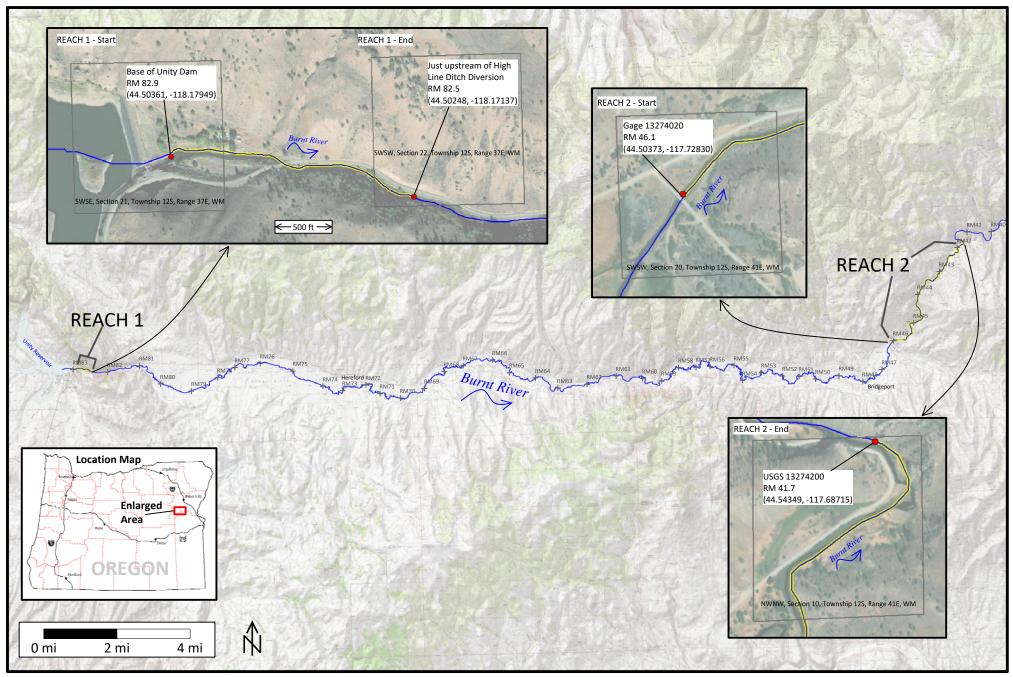

NOTE: River Miles derived from OWRD provided stream layer (5/3/24)