

LEGEND

- SECTION LINE
- 1/4 1/4 LINE
- TAX LOT LINE
- CREEK
- BURIED PIPE
- C. ROAD
- FLOW DIRECTION
- SECTION CORNER
- TAX LOT NUMBER
- POA (WELL)
- IRRIGATED UNDER PERMIT G-13288
- IRRIGATED ACRES
- 1/4 1/4 SECTION


NOTES:

1. THIS MAP WAS PREPARED FROM FIELD MEASUREMENTS, NAIP 2020 AERIAL PHOTOGRAPH, JOSEPHINE COUNTY TAX MAP 38-5-11 AND OREGON GLO MAPS.
2. THE PURPOSE OF THIS MAP IS TO IDENTIFY THE LOCATION OF THE WATER RIGHT ONLY, AND IS NOT INTENDED TO PROVIDE DIMENSIONS OR LOCATION OF PROPERTY LINES.
3. DATE OF PRIORITY FOR THIS WATER RIGHT IS FEBRUARY 19, 1997.

WELL TIES:

WELL 1: SE1/4 NW1/4, SECTION 11, T38S, R5W, W.M.; 660' NORTH & 960' EAST FROM CW1/16 CORNER OF SECTION 11.

RECEIVED
JUN 04 2022
WOOD

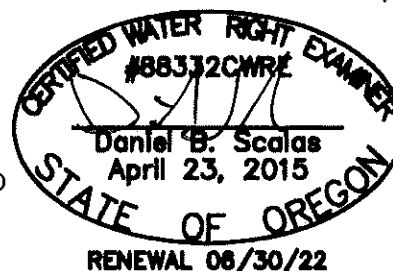

AL ADKINS
ENGINEERING & SURVEYING

o / 541.884.4666
w / AdkinsEngineering.com

1435 ESPLANADE AVENUE, KLAMATH FALLS, OR 97601

SERVING S. OREGON & N. CALIFORNIA

ENGINEERING • SURVEYING • PLANNING • TESTING

3818-01

CLAIM OF BENEFICIAL USE AND FINAL PROOF MAP

FOR

VICKI L BAUER
T38S, R5W, SEC. 11, WM
JOSEPHINE COUNTY, OREGON
PERMIT G-13288
APPLICATION G-14463

5/20/2021