



NOTE:
T-12958 (GR Modification)
T-12959 (POU Change for Certificates 93678 & 93676)

FINAL PROOF MAP
(Applications T-12958 & T-12959)
Section 33, T.37S., R.2W., W.M.

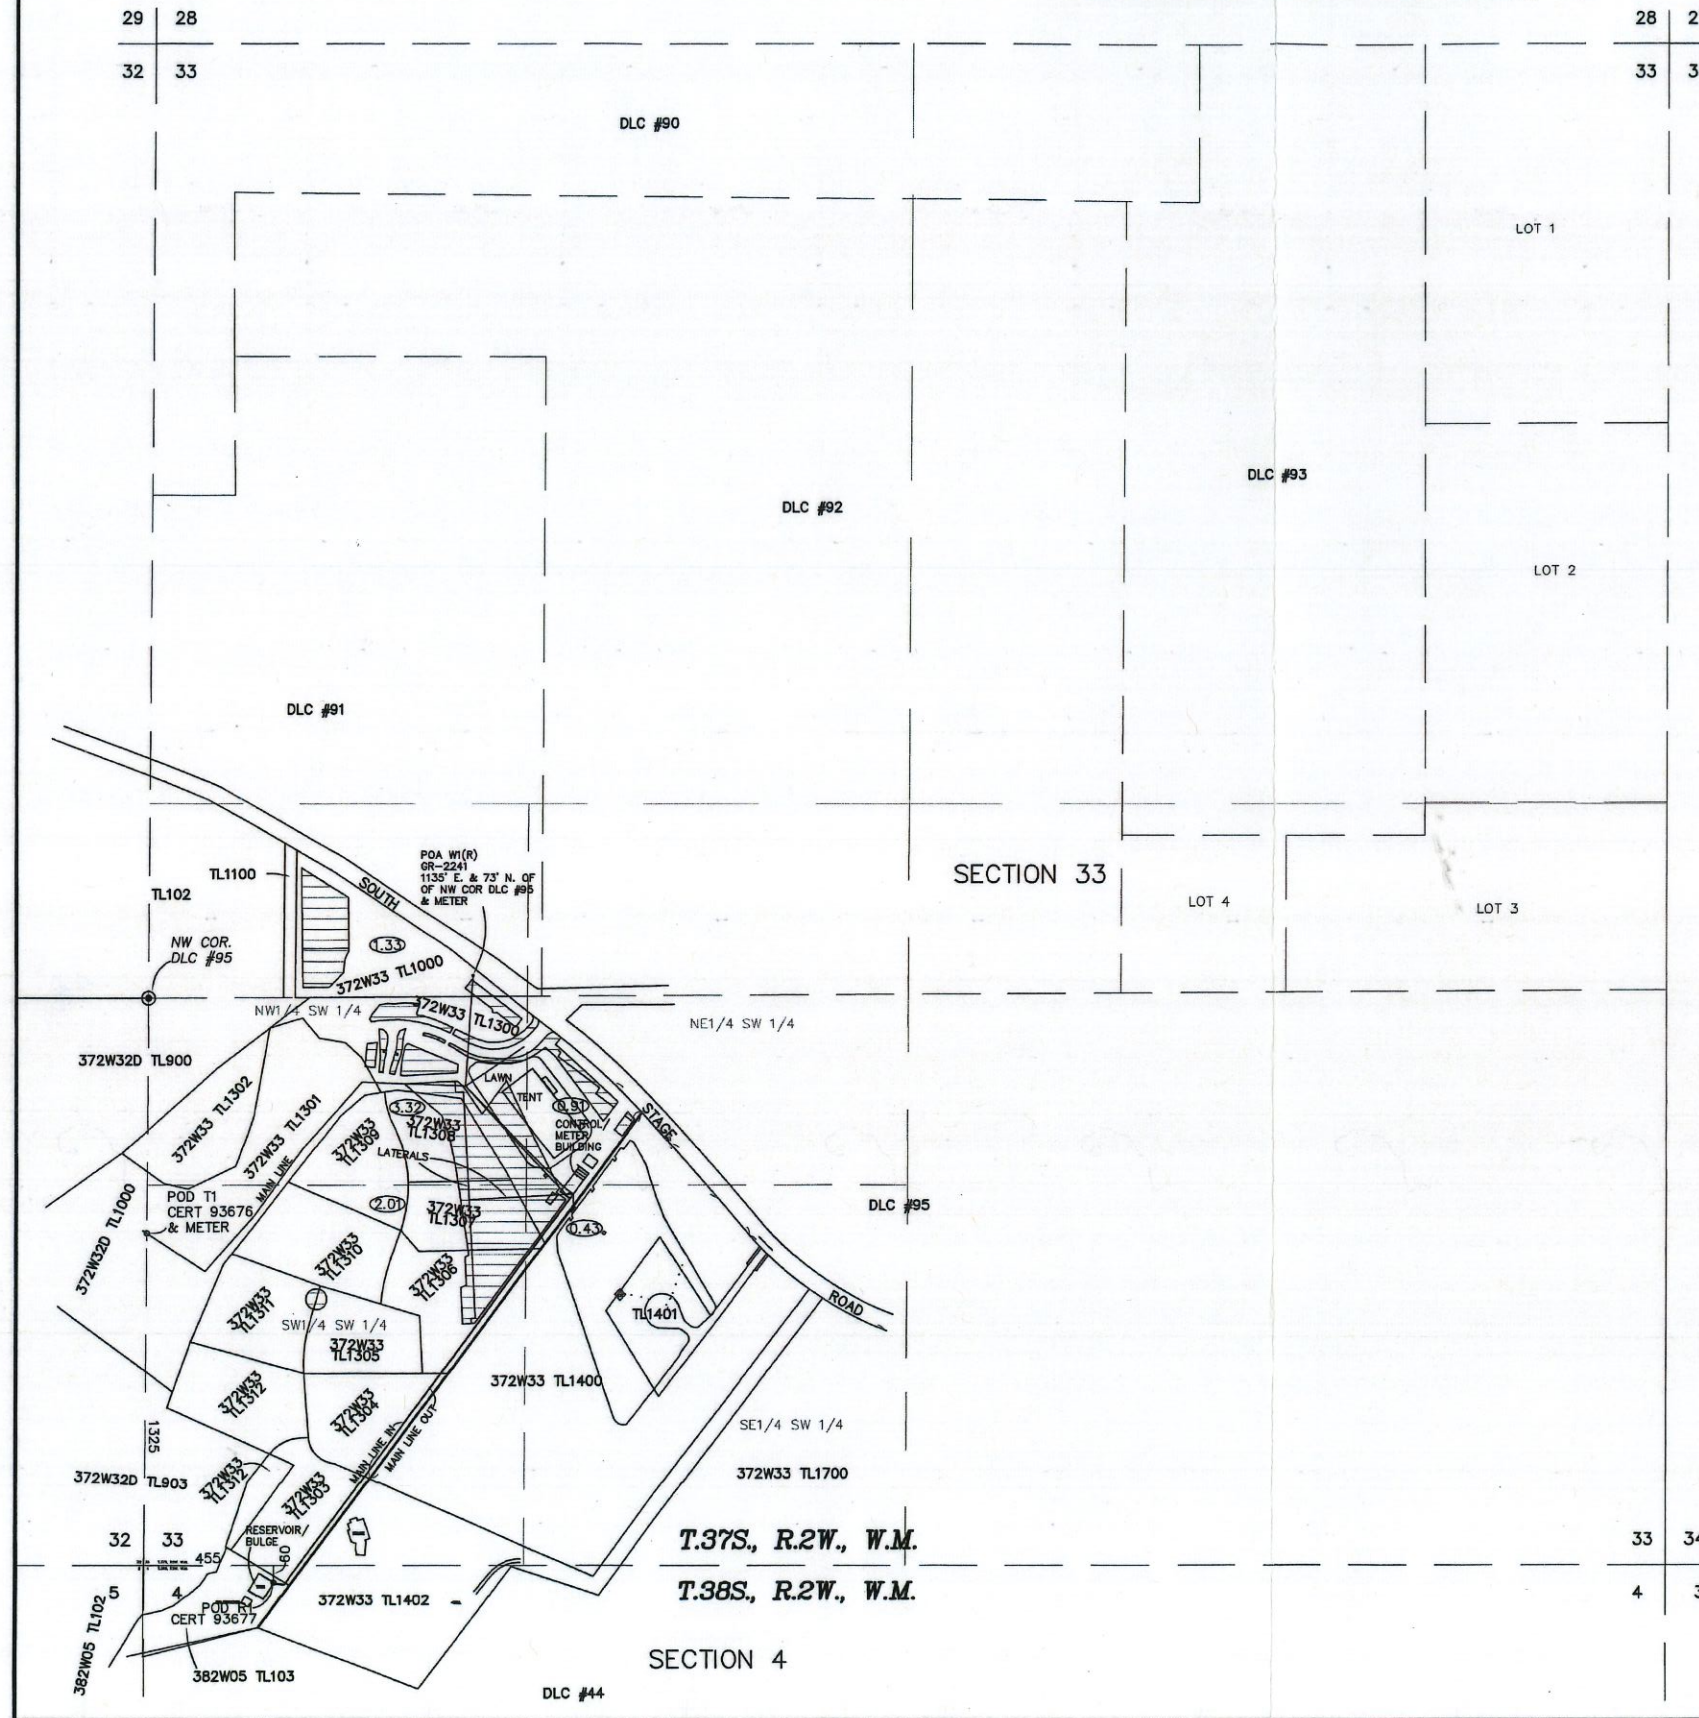

RIGHT AFTER TRANSFER 8.0 ACRES IN SECTION 33 (TO LANDS)

AREA	1/4-1/4	DLC
0.91	NE-SW	95
0.43	SE-SW	95
3.32	NW-SW	95
1.33	NW-SW	91
2.01	SW-SW	95

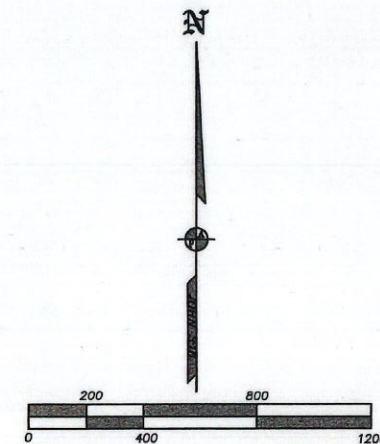

RECEIVED
DEC 05 2023
OWRD


LEGEND:

— = AREA TRANSFERRED FROM GR-2241, CERTIFICATES 93676 & 93678 PER THIS APPLICATION.

1.33 = IRRIGATED AREA (TO LANDS) UNDER THIS APPLICATION.

POD T1 = POINT OF DIVERSION PER CERTIFICATE 93676.
POA W1(R) = POINT OF APPROPRIATION PER GR-2241 TO REPLACE ORIGINAL POA UNDER THIS APPLICATION.
POD R1 = POINT OF DIVERSION PER CERTIFICATE 93677 & BULGE FOR PERMIT G-17310.

THE PREPARATION OF THIS MAP
IS TO IDENTIFY THE WATER RIGHT
ONLY AND IS NOT INTENDED TO
PROVIDE LEGAL DIMENSIONS OF
PROPERTY OWNERSHIP LINES.

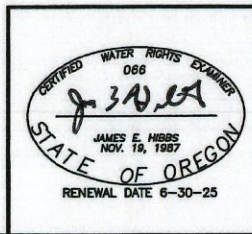

REVISIONS:	DATE: 18 OCT 2023
TITLE: FINAL PROOF MAP	SCALE: 1 inch = 400 feet
ASSESSOR'S MAP #: 372W33 TL'S 1000,1300,1306-1308 382W05 TL103	DRAWN BY: JEH
FOR: SELLWOOD VENTURES, LLC 19 N. BARNEBURG RD. MEDFORD, OR 97504	CHK BY:
	ORIGIN:
	ROTATION: 0°
	JOB#: 14115FM
	Sheet 1 of 1