


T3SR8#9WWM

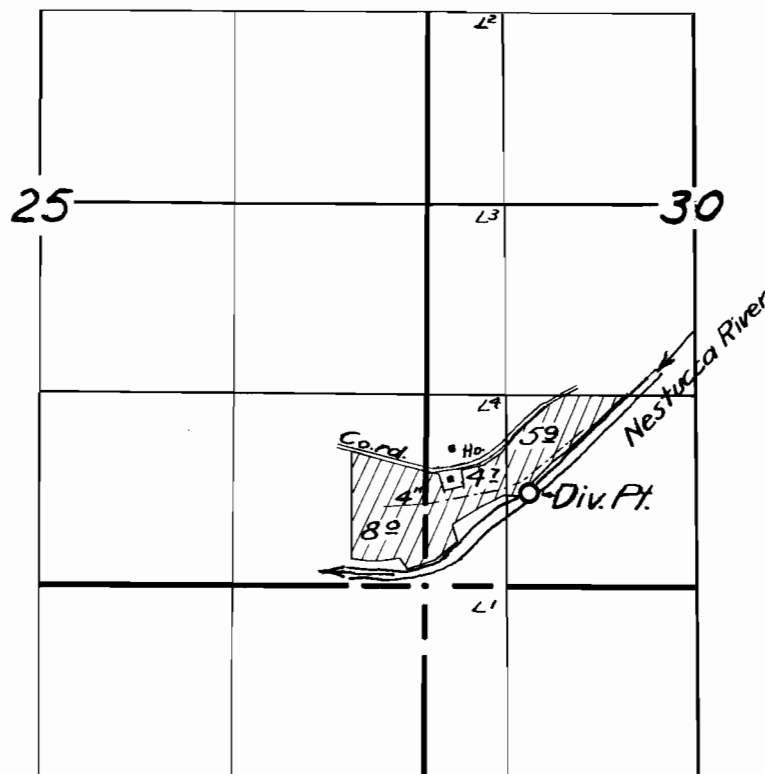

FINAL PROOF SURVEY
UNDER

Application No. 21523 Permit No. 16878
IN NAME OF

IVAH L. BROWNING

Surveyed Sept. 12 1955, by Tm. B. B. B.


1955M

RECEIVED

AUG 21 2023

OWRD

Transfer Application - Hudspeth

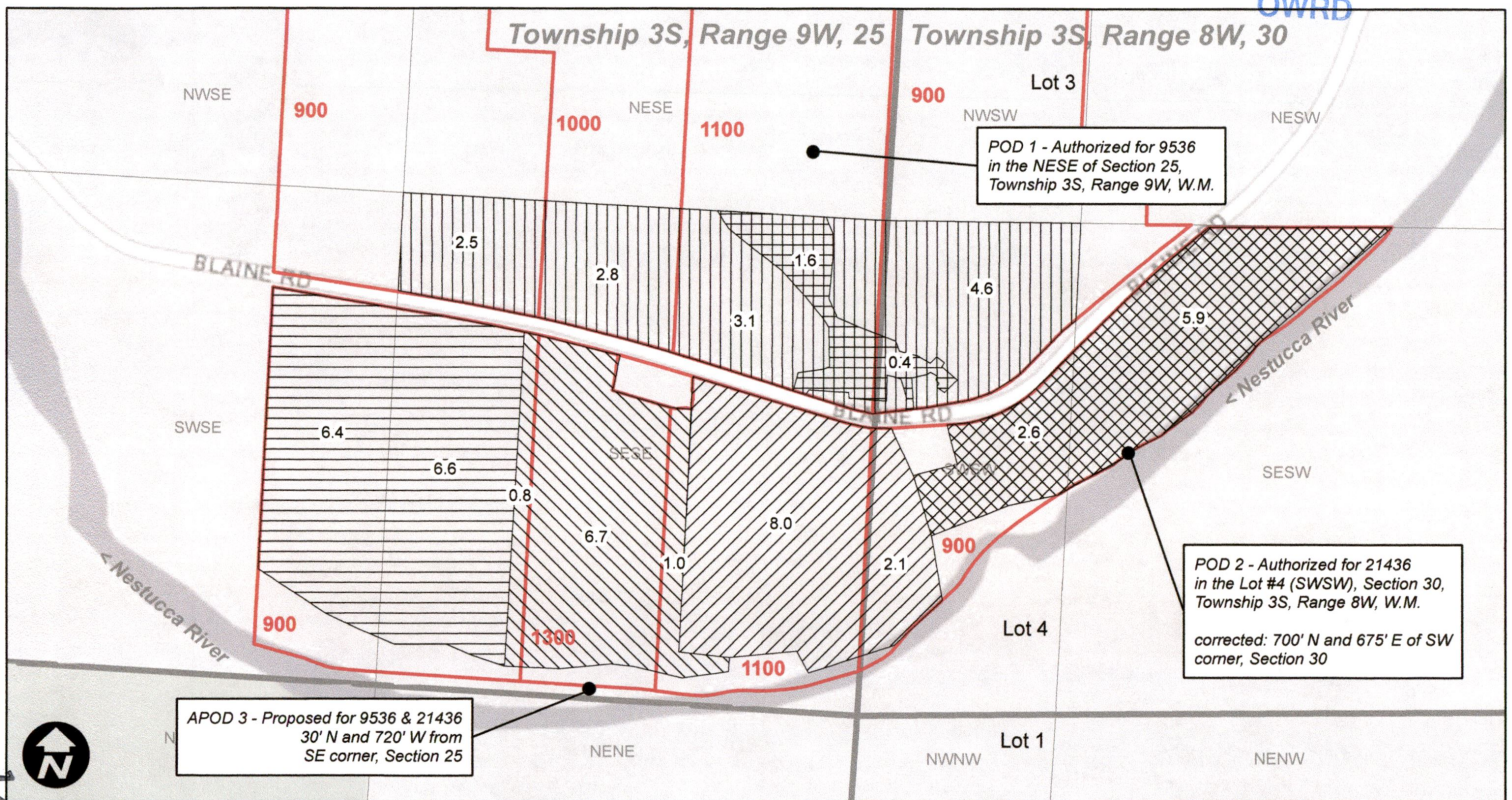

Legend

- | | | | | | |
|--|---------------------------|--|-----------------------|--|---------|
| | Cert. 9536 From | | Cert. 21436 From | | Taxlots |
| | Cert. 9536 To | | Cert. 21436 To | | |
| | Pending Cancellation 9536 | | Cert. 21436 No Change | | |

WM
WILL MCGILL SURVEYING LLC

