




**CLIENT: ESTACADA ROCK PRODUCTS**

NOTE: THIS DRAWING IS AN APPLICATION TO APPROPRIATE GROUNDWATER, IT IS NOT A LAND SURVEY. PROPERTY LINES AND/OR OTHER LINES OF OCCUPATION SHOWN HEREON ARE NOT REPRESENTED BY THE UNDERSIGNED TO MEET ACCURACY STANDARDS OF LAND SURVEYS.



**All COUNTY SURVEYORS  
& PLANNERS, INC.**  
P.O. BOX 955  
SANDY, OREGON 97055  
(503) 668-3151

**JOB NO. 94-313A**

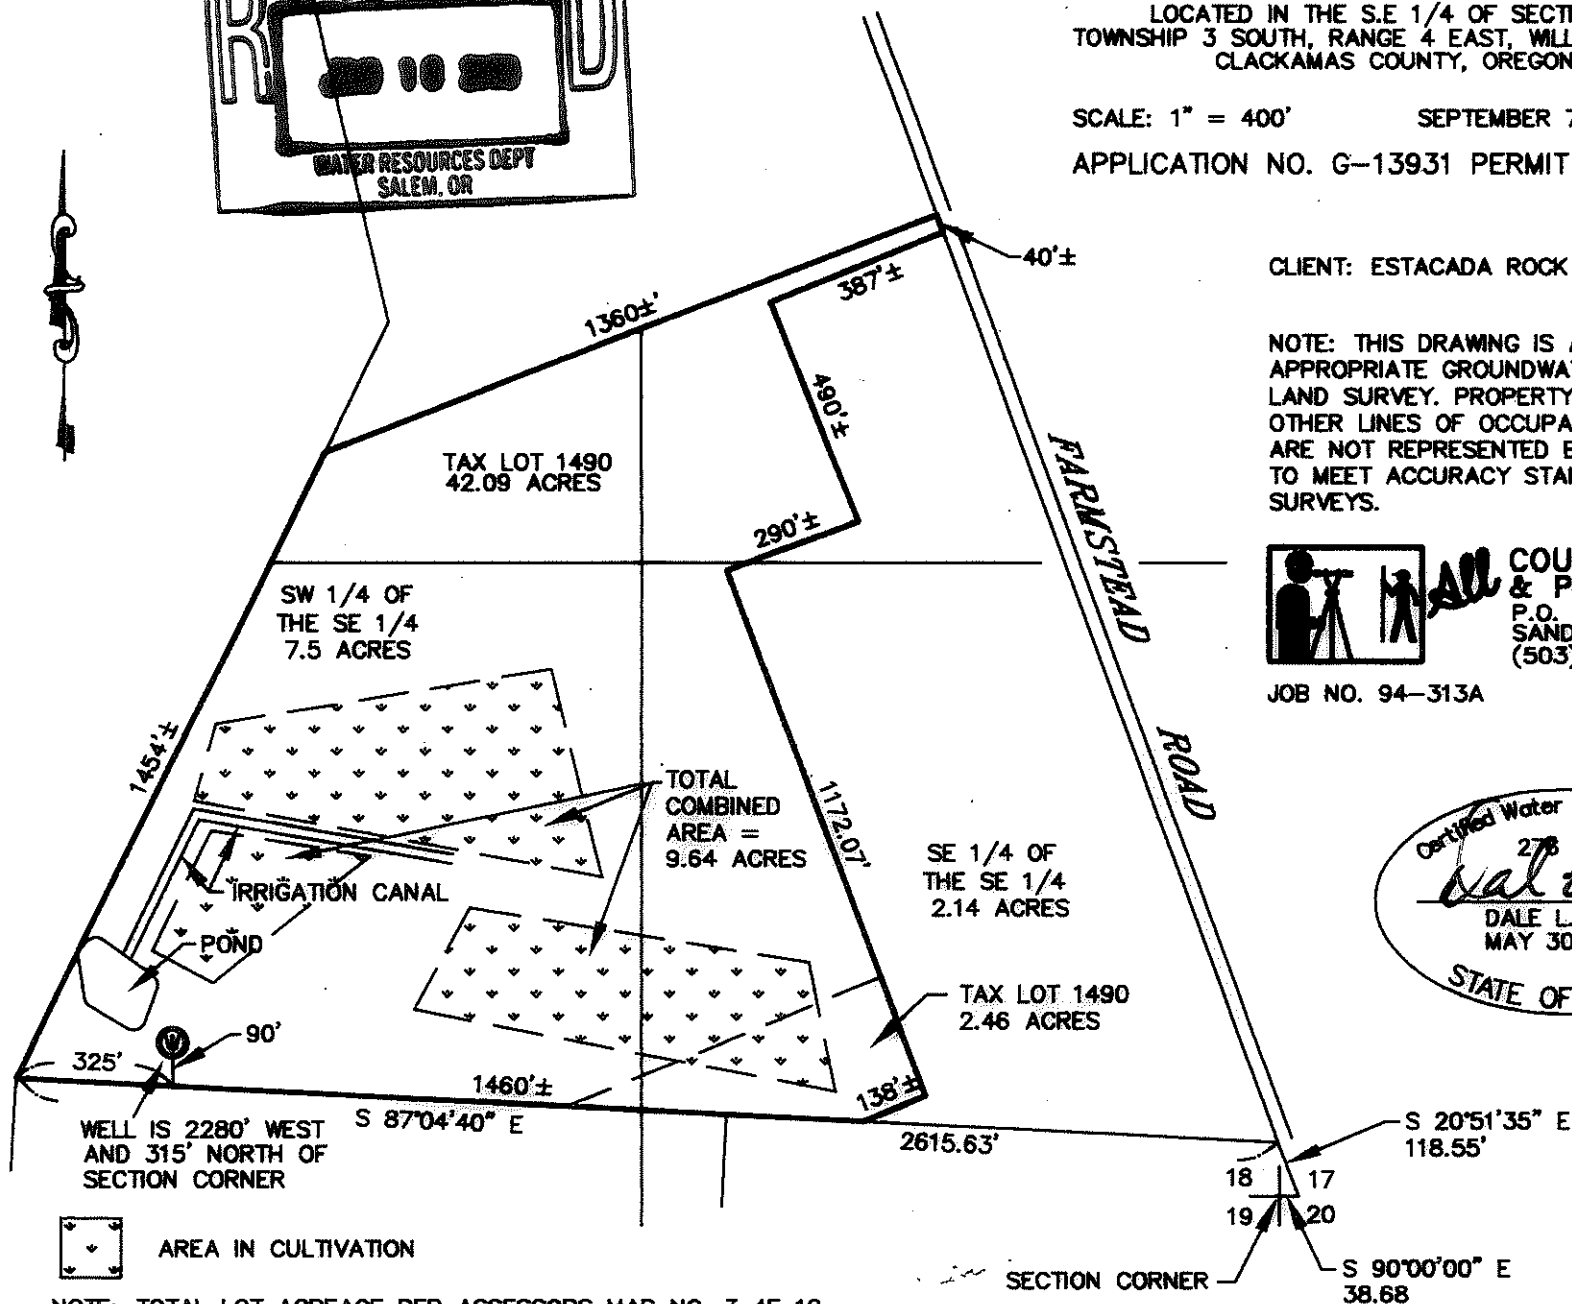

NOTE: TOTAL LOT ACREAGE PER ASSESSORS MAP NO. 3 4E 18