


TOWNSHIP 28 SOUTH, RANGE 37 EAST OF THE WILLAMETTE MERIDIAN
MALHEUR COUNTY, OREGON

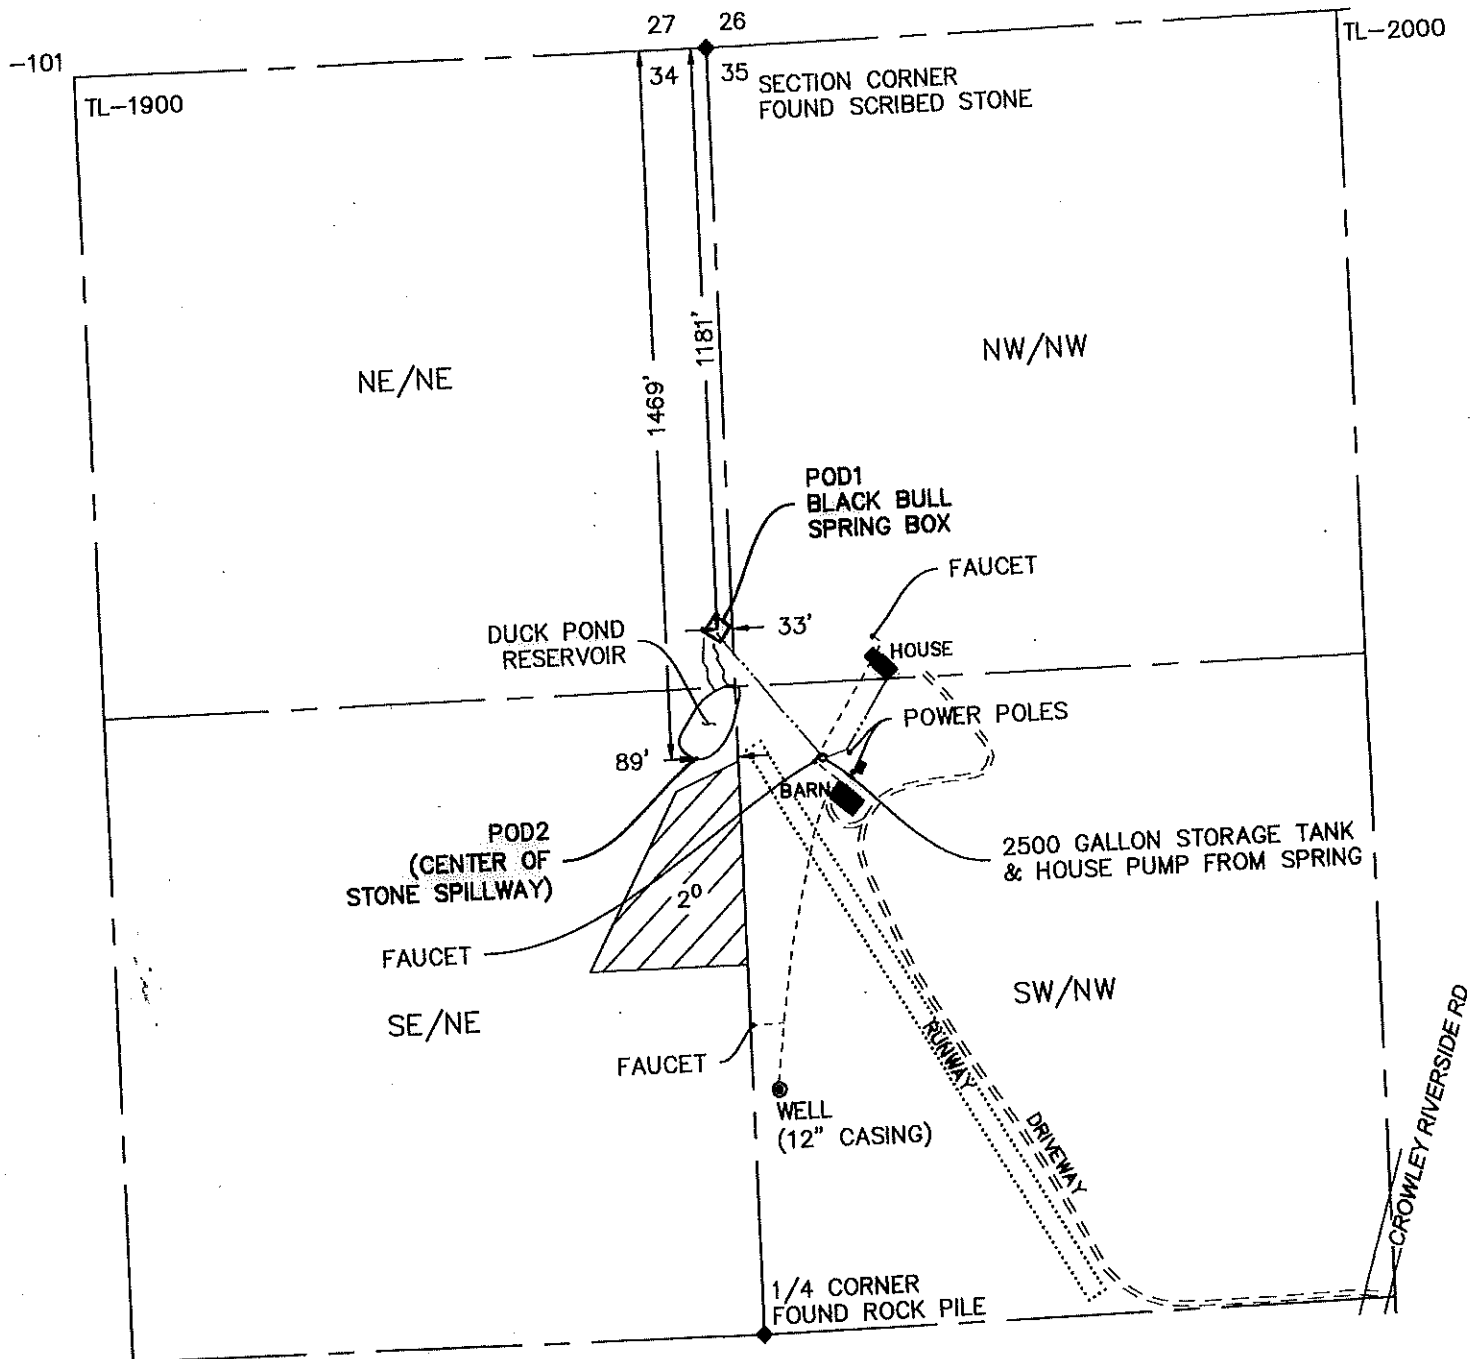

LEGEND


- WELL SUPPLY LINE
- SPRING SUPPLY LINE
- IRRIGATED FIELD



NOTES

1. THIS MAP IS FOR THE PURPOSE OF LOCATING A WATER RIGHT AND IS NOT INTENDED TO PROVIDE LEGAL DIMENSIONS FOR LOCATIONS OF PROPERTY BOUNDARIES.
2. THE DOMESTIC AND LIVESTOCK PIPELINES ORIGINATE AT THE WELL AND THE BLACK BULL SPRING BOX.
3. DISTANCES SHOWN WERE DETERMINED FROM HAND HELD GPS.

4. MAP NUMBER 28S37E:
TAX LOT 101-OREGON DEPARTMENT OF STATE LANDS
TAX LOT 1900-DANIEL J & LINDA J HUTCHISON
TAX LOT 2000-TREE TOP RANCHES LTD PRNTNSP

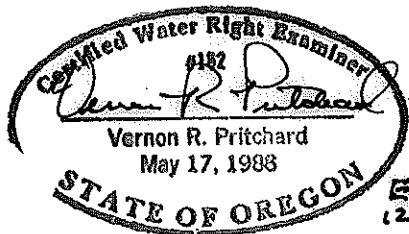

RECEIVED

AUG 04 2023

OWRD

VERN PRITCHARD P.O. BOX 134 VALE, OR 97918		541-473-3612
DANIEL J. HUTCHISON CLAIM OF BENEFICIAL USE APP. S-87504, PERMIT S-54886		
DRAWN: D. McKROLA	SCALE: 1" = 400'	
APPROVED:	DWG NO: 016	
DATE: JULY 24, 2023	SHEET 1 OF 1	