


CLAIM OF BENEFICIAL USE
RESERVOIR STORAGE RIGHT

RECEIVED

MAY 25 2023


OWRD

PERMIT R-15313
APPLICATION R-88487
SITUATED IN
SECTION 7, TOWNSHIP 38 S RANGE 2 W, W.M.
JACKSON COUNTY OREGON

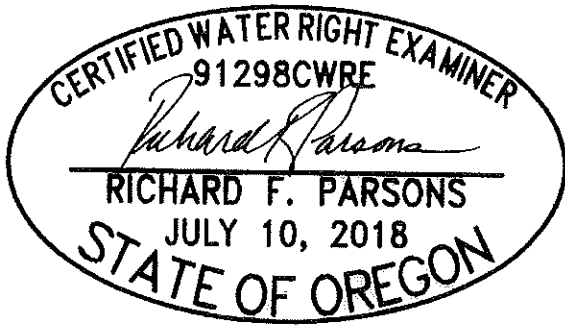

LEGEND

- ▲ DAM
125' NORTH and 385' EAST OF WEST 1/4 CORNER
SECTION 7, T38S R2W
- POORMAN CREEK POD and PUMP
20' NORTH and 395' EAST OF WEST 1/4 CORNER
SECTION 7, T38S R2W
- PIPELINE

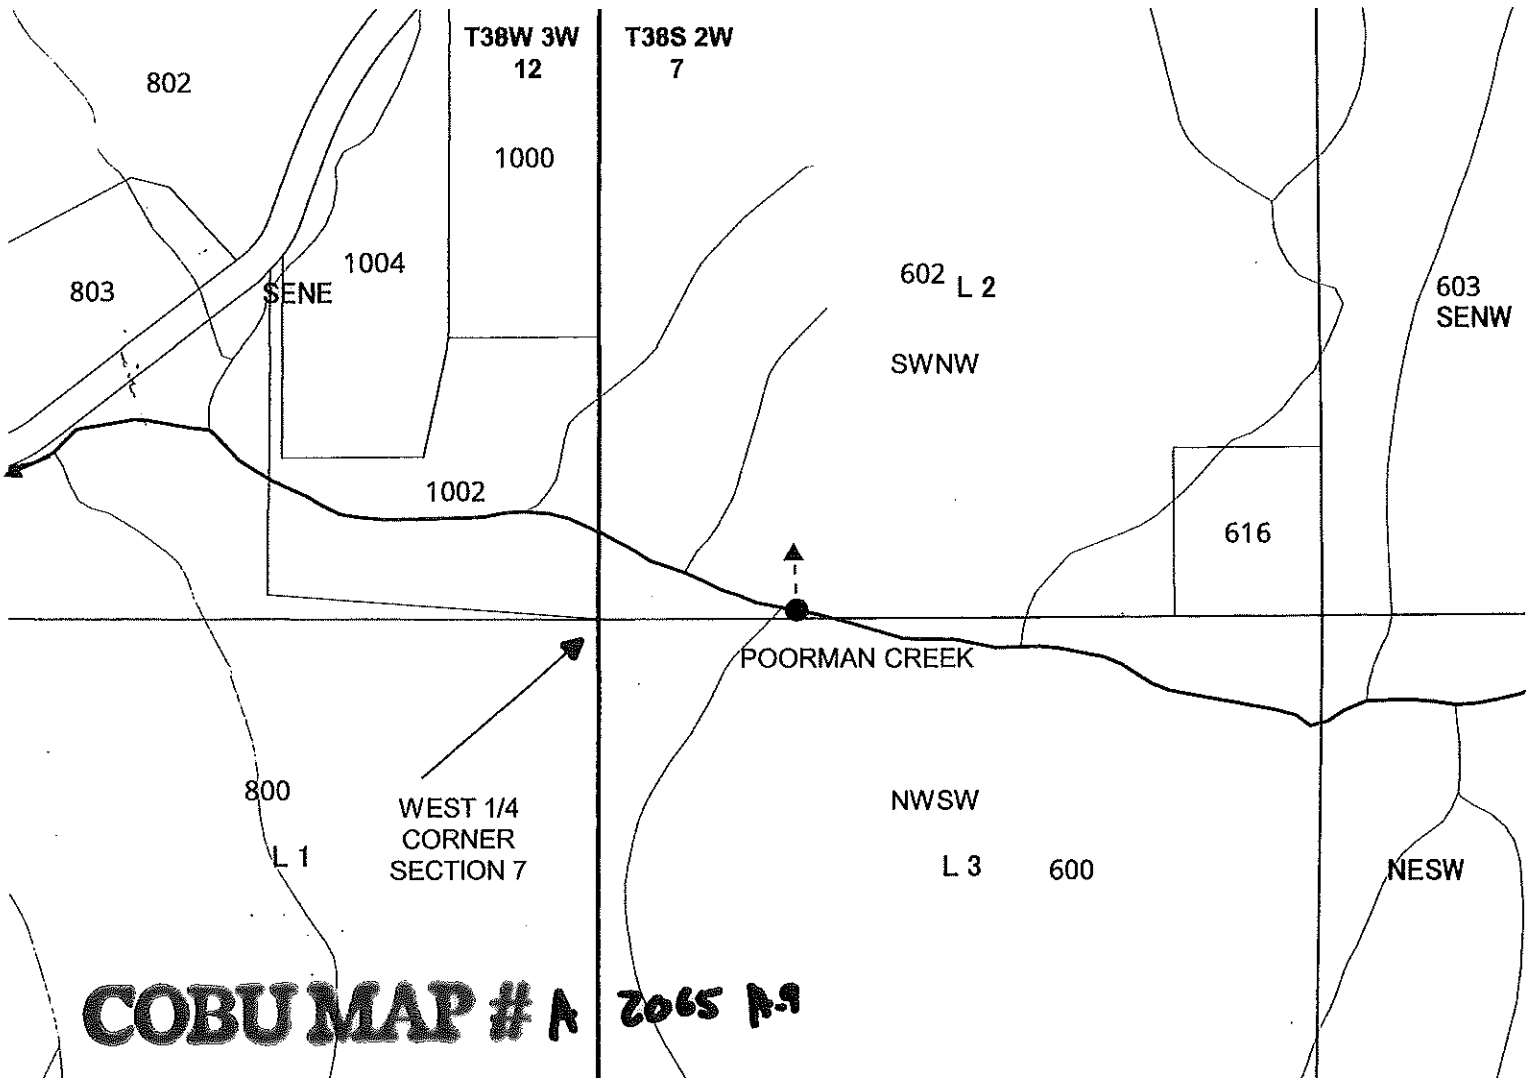

0 400 ft

This map is not intended to provide
legal dimensions or locations of
property ownership lines

ParsonsWater Consulting LLC
rick.parsons@parsonwater.com
541.499.0257 303.667.5067