

SUPERSEDING


**TRANSFER APPLICATION
FOR DUNN FAMILY TRUST
BY NATHAN REED PE CWRE
T20S, R4W, W.M. SECTION 7
CERTIFICATE NO. 11883**

SCALE: 1" = 1320'

Received by OWRD

APR 24 2025

Salem, OR

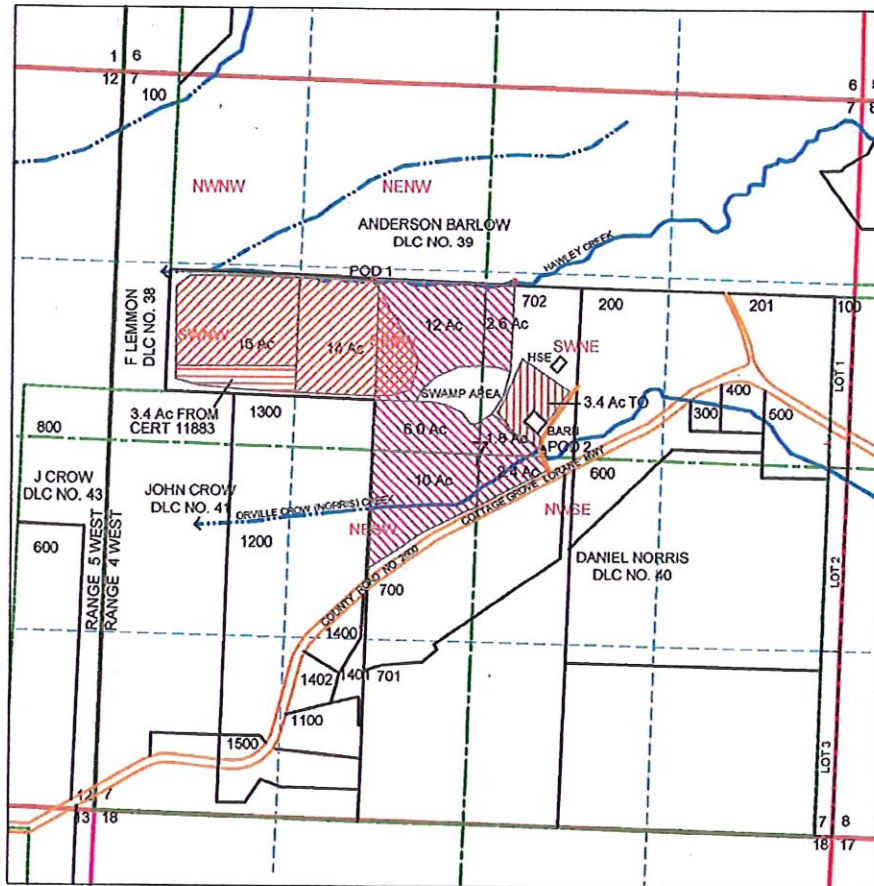

- LEGEND
- POD
 - ▲ PUMP
 - WATER
 - TOWNSHIP/RANGE
 - QUARTER
 - SIXTEENTH
 - DLC
 - GOV. LOT
 - PARCEL
 - CERT 11883, PR 9-8-1928
 - CERT 24385, PR 11-18-1937
 - CERT 11883, PR 9-8-1928 FR
 - CERT 11883, PR 9-8-1928 TO

CERT 11883 PODS 1616 FEET EAST FROM NW CORNER OF DLC NO. 40 AND 2640 FEET EAST AND 1188 FEET SOUTH OF THE NW CORNER OF DLC NO. 40.
CERT 24385 PODS 2742 FEET EAST FROM NW CORNER OF DLC NO. 40 AND 2838 FEET EAST AND 1265 FEET SOUTH FROM NW CORNER OF DLC NO. 40.



MAP PREPARED FOR:
DUNN FAMILY TRUST
28394 COTTAGE GROVE LORANE RD
COTTAGE GROVE, OR 97424

THE PURPOSE OF THIS MAP IS TO IDENTIFY THE LOCATION OF THE WATER RIGHT. IT IS NOT INTENDED TO PROVIDE INFORMATION RELATIVE TO THE LOCATION OF PROPERTY OWNERSHIP BOUNDARY LINES.


MAP PREPARED BY:
NATHAN REED PE, CWRE
157 WEST BODIE STREET
ROSEBURG, OR 97471

Received
MAY 16 2024
OWRD

TRANSFER APPLICATION
FOR DUNN FAMILY TRUST
BY NATHAN REED PE CWRE
T20S, R4W, W.M. SECTION 7
CERTIFICATE NO. 11883


SCALE: 1" = 1320'

SUPERSEDED

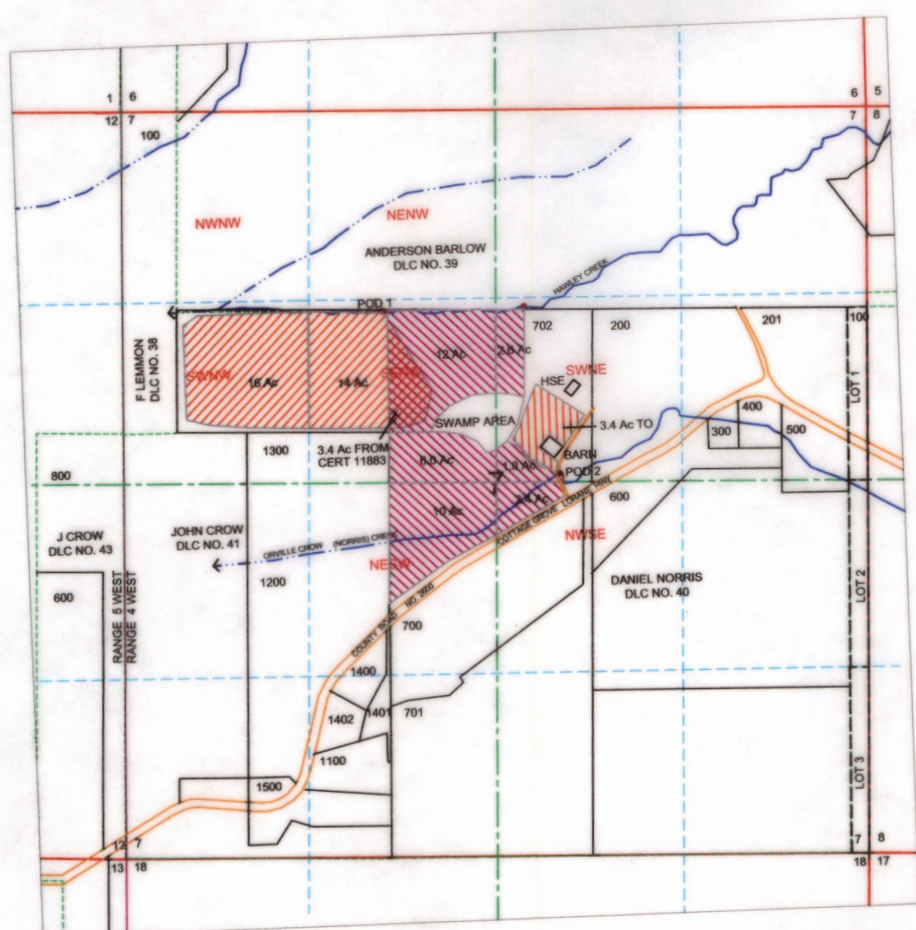

- LEGEND
- POD
 - ▲ PUMP
 - WATER
 - TOWNSHIP/RANGE
 - QUARTER
 - SIXTEENTH
 - DLC
 - GOV. LOT
 - PARCEL
 - CERT 11883, PR 9-8-1928
 - CERT 24385, PR 11-18-1937
 - CERT 11883, PR 9-8-1928 TO

CERT 11883 PODS 1616 FEET EAST FROM NW CORNER OF DLC NO. 40 AND 2640 FEET EAST AND 1188 FEET SOUTH OF THE NW CORNER OF DLC NO. 40.
CERT 24385 PODS 2742 FEET EAST FROM NW CORNER OF DLC NO. 40 AND 2838 FEET EAST AND 1265 FEET SOUTH FROM NW CORNER OF DLC NO. 40.

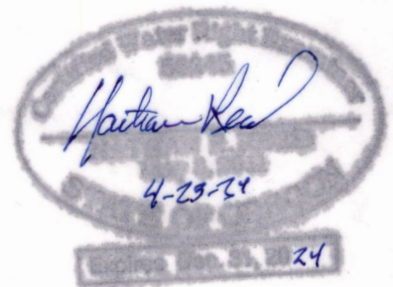

MAP PREPARED FOR:
DUNN FAMILY TRUST
28394 COTTAGE GROVE LORANE RD
COTTAGE GROVE, OR 97424

THE PURPOSE OF THIS MAP IS TO IDENTIFY THE LOCATION OF THE WATER RIGHT. IT IS NOT INTENDED TO PROVIDE INFORMATION RELATIVE TO THE LOCATION OF PROPERTY OWNERSHIP BOUNDARY LINES.

MAP PREPARED BY:
NATHAN REED PE, CWRE
157 WEST BODIE STREET
ROSEBURG, OR 97471