




LEGEND

- Point of Diversion (POD)
- Staff Guage
- Place of Use (POU)
- Tax Lot
- Donation Land Claim (DLC)
- Government Lot (GL)
- Watercourse

POD LOCATION DESCRIPTION
Outlet (WCS 2)
Located 607 feet North and 3409 feet East from the SW corner of Section 6, Township 1 South, Range 2 West (W.M.)

CERTIFIED WATER RIGHTS EXAMINER STAMP

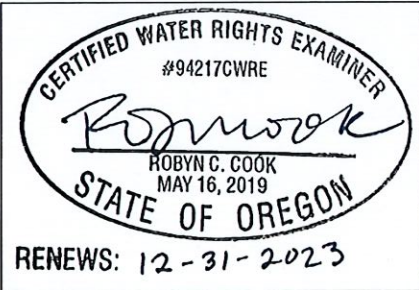

DISCLAIMER
This map was prepared for the purpose of identifying the location of a water right only and it is not intended to provide legal dimensions or location of property ownership lines.
Date: November 1, 2023
Data Sources: BLM, ESRI, OWRD, USGS

RECEIVED
NOV 21 2023
OWRD

Claim of Beneficial Use Map
City of Hillsboro

Application R-88582; Permit R-15347
Township 1 South, Range 2 West (W.M.)
Washington County

