



# SECTION 5, TWP.2 S. RANGE 20 E. W.M. GILLIAM COUNTY, OREGON

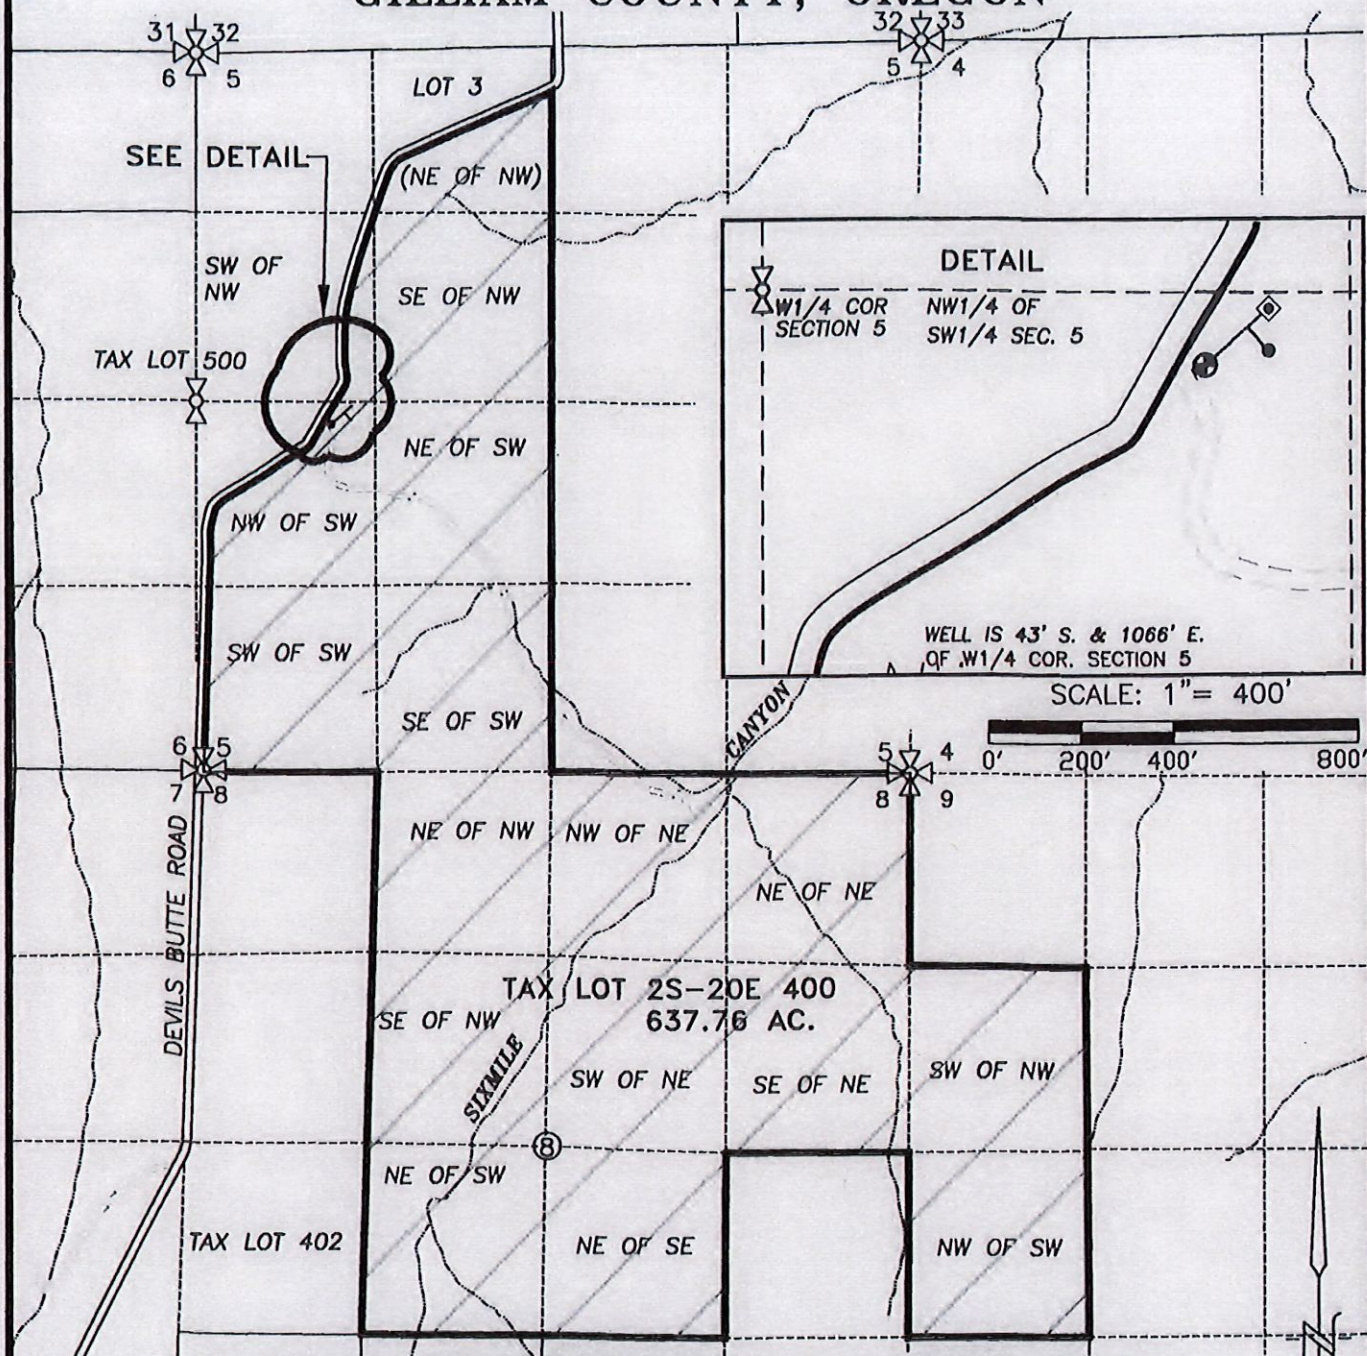

## CLAIM OF BENEFICIAL USE MAP

SCALE: 1" = 1320'

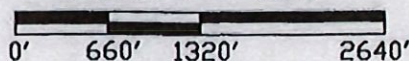

### LEGEND:

- STOCK TANK
- ◆ WELL (GILL 50331) AND FLOW METER
- STORAGE TANK, 6000 GAL
- PIPELINE

RECEIVED

JUN 2 2023

OWRD