


T.11S., R.29E.
T.11S., R.30E.

T.11S., R.30E., W.M.

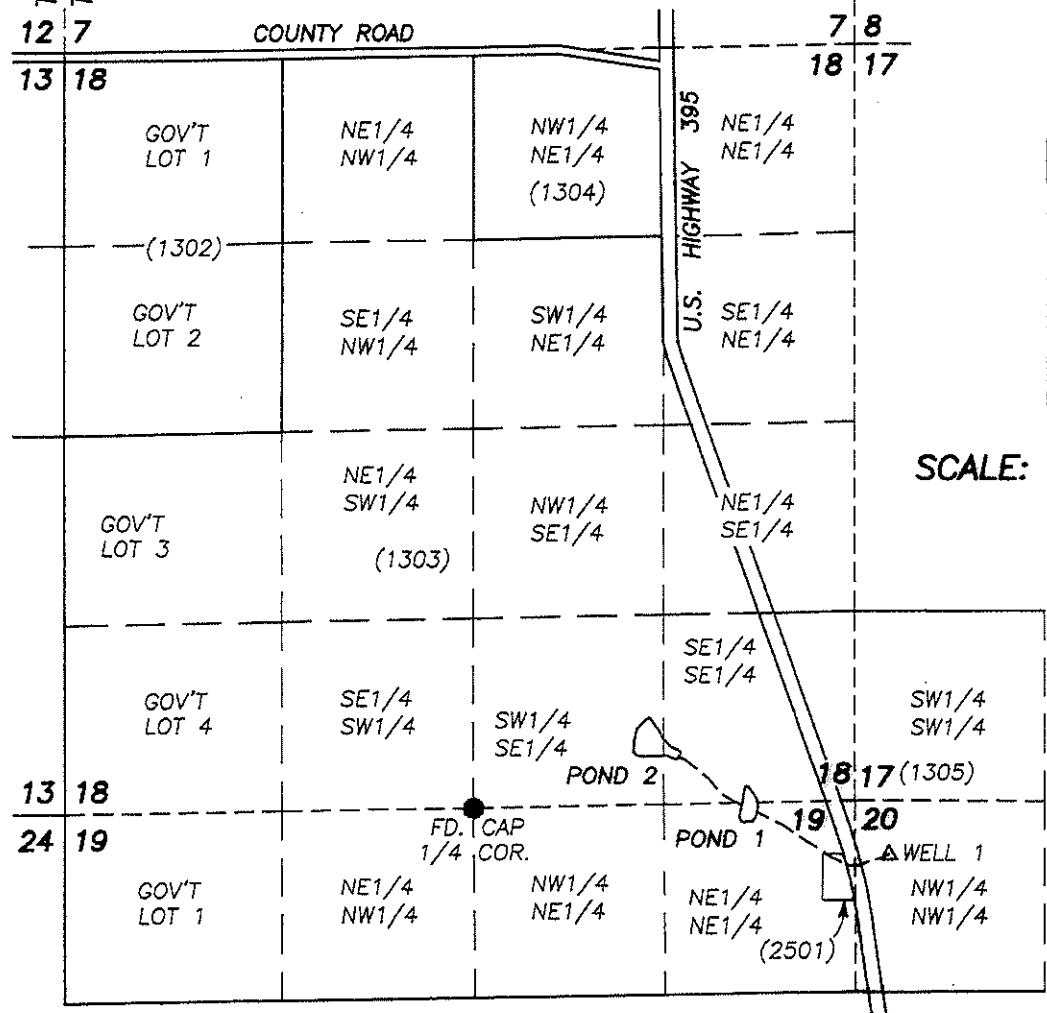

SCALE: 1"=1320'

CLAIM OF BENEFICIAL USE MAP
UNDER
APPLICATION G-17944
PERMIT G-17586
IN NAME OF
ROY VARDANEGA


POA - WELL 1: 330 FT. SOUTH & 2890 FT. EAST FROM
THE N1/4 CORNER SECTION 19,
T.11S., R.30E., W.M.

----- PIPELINE
() TAX LOT

RECEIVED
SEP 16 2021
OWRD

PREPARED BY
ROBERT D. BAGETT, PLS, CWRE
217 N. CANYON BLVD.
JOHN DAY, OR 97845
MAY 22, 2021

DISCLAIMER: THIS MAP IS NOT INTENDED TO
PROVIDE LEGAL DIMENSIONS OR LOCATIONS
OF PROPERTY OWNERSHIP LINES.

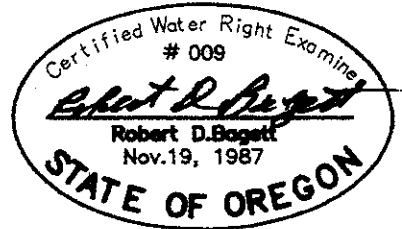

RENEWS 12/31/2021