


**T16S R11E, WM
DESCHUTES COUNTY, OR**



0 400
Feet

1" = 400'

- Well & Meter
- Bulge-in-System
- Pipeline
- ▨ POU Nursery Use
- ▭ Township
- ▭ Section
- Quarter Quarter
- ▭ Tax Lot

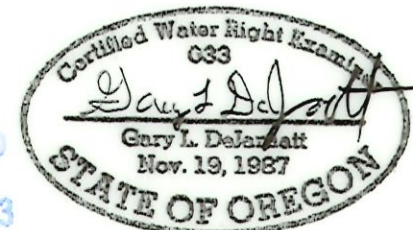


RECEIVED
OCT 23 2023
OWRD

RENEWAL DATE 12/31/2023



Well Location:
Well #1 (L-66553 / DESC 56129):
980' S, 185' W of E 1/4 Sec 35

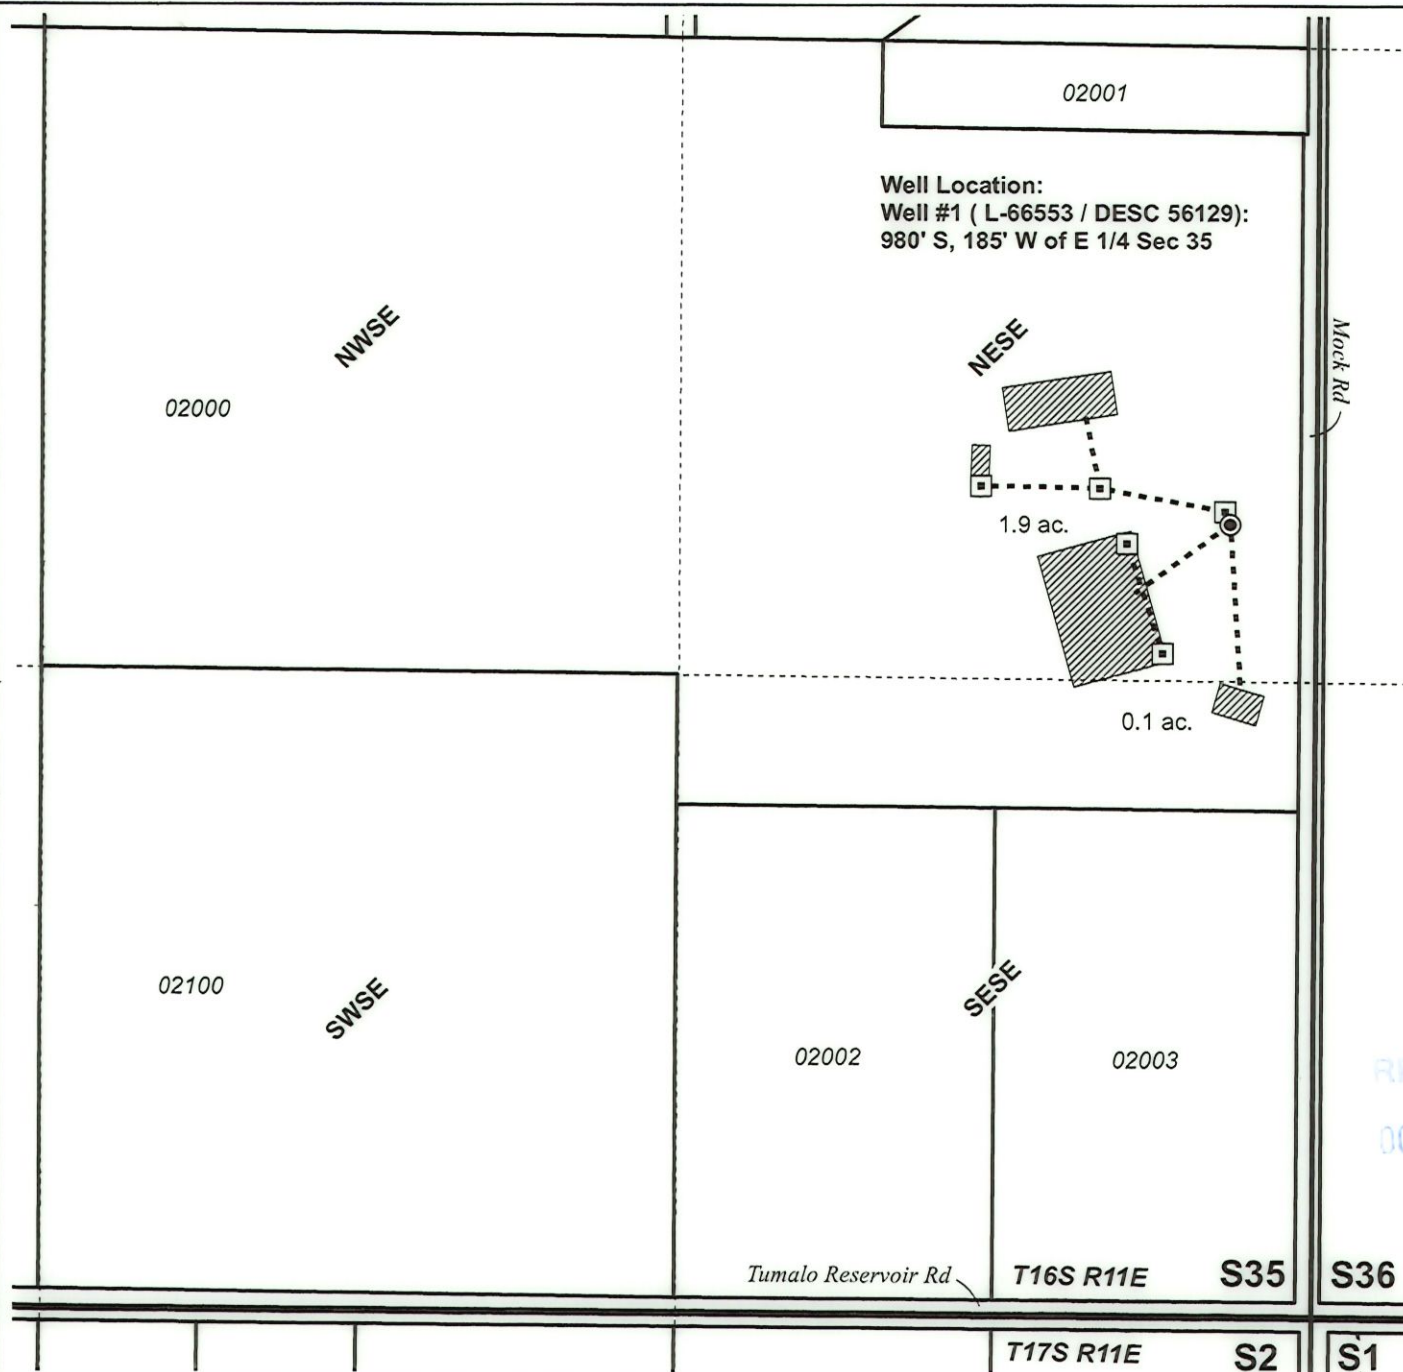

**CLAIM OF BENEFICIAL USE MAP
Oregrown Industries, Inc.**

Date: 8/14/2023

T-12241

Project #23031

This map is not intended
to provide legal dimensions
or locations of property
ownership lines.

WATER RIGHT SERVICES, LLC
PO BOX 1830, BEND, OR 97709
WWW.OREGONWATER.US CCB # 197121
johnshort@usa.com 541-389-2837