


T.6S. R.3W. Section 24, W.M.

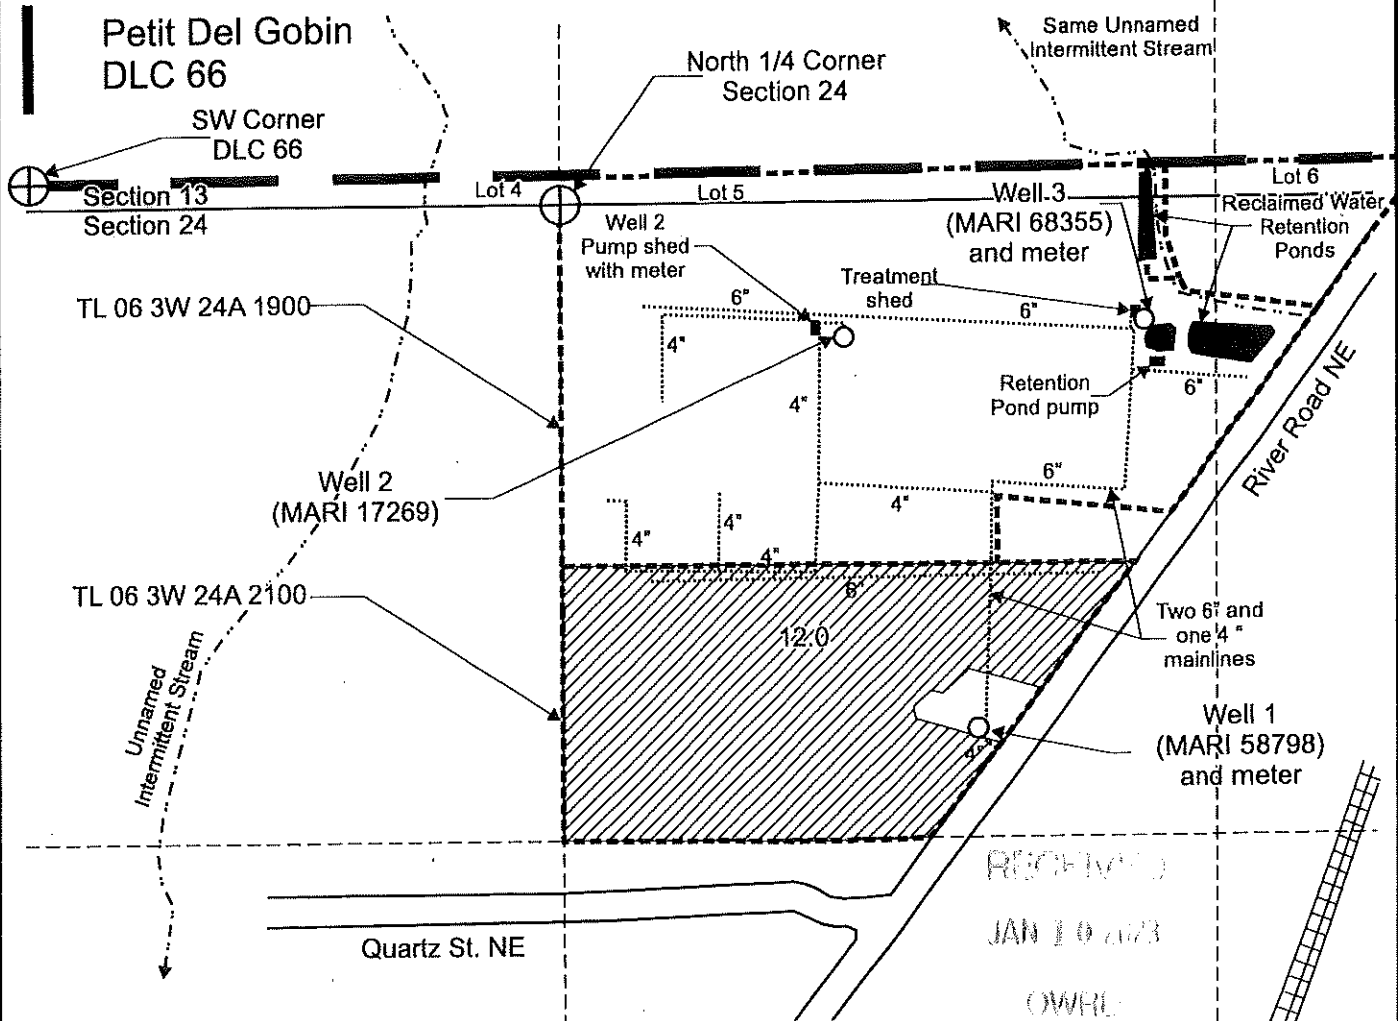

Well 1 (MARI 58798) is located 1,085 feet south and 865 feet east from the N 1/4 corner, Section 24.



Well 2 (MARI 17269) is located 330 feet south and 1,690 feet east from the SW corner, DLC 66.

Well 3 (MARI 68355) is located 250 feet south and 1,210 feet east from the N 1/4 corner, Section 24.

Area (12.0 Acres) irrigated under T-12558 (formerly Certificate 92078) priority date: March 11, 2005.

- Tax lot boundary
- Donation Land Claim boundary
- Irrigation mainline

Scale: 1" = 400'

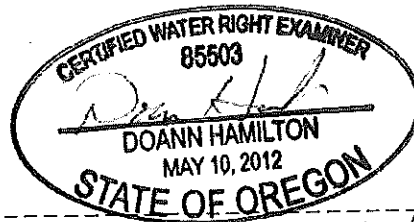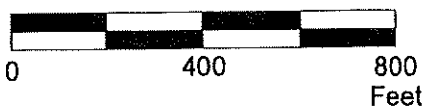

EXPIRES: Jan 30, 2023

This map was prepared for the purpose of identifying the location of a water right only and is not intended to provide legal dimensions or location of property ownership lines.

Claim of Beneficial Use Map
T-12558

Robert W. Gabriel Trust
T.6S. R.3W. Section 24, W.M.

Pacific Hydro-Geology Inc.

12/2022