

**T27S R19E, WM,
LAKE COUNTY, OR**

6


5

4

7

8

9

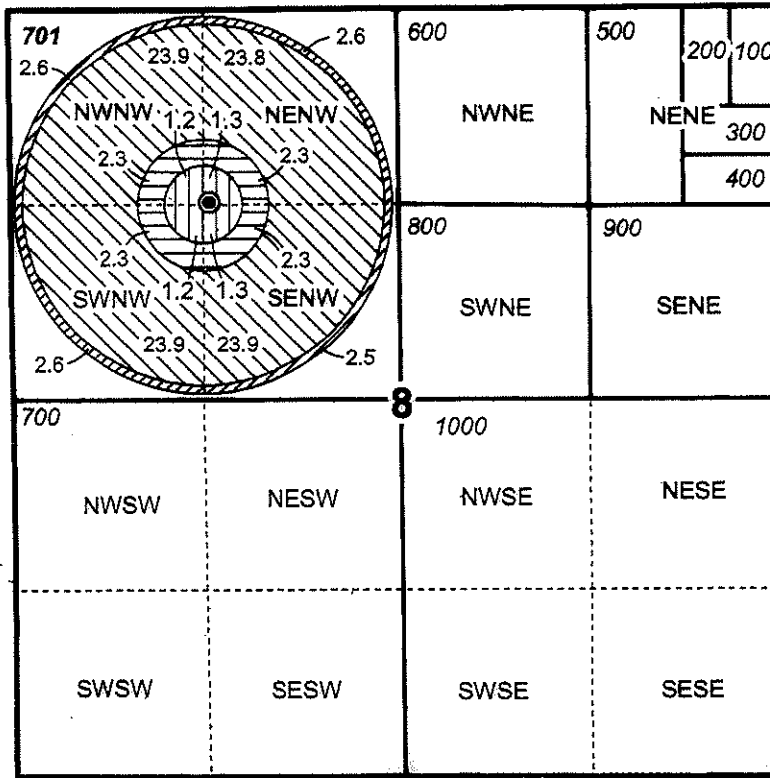


County Road No. 5-14 (Christmas Valley - Wagontire Hwy)

18

17


16

DEC 29 2022

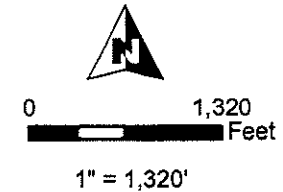

- Well 1 (LAKE 1166) & Meter
- POU IR (from C-83338) 11/4/1983 Priority
- POU IR (from C-91153) 7/10/1980 Priority
- POU IR (from C-91152) 4/5/1982 Priority
- POU IR (from C-76468) 6/11/1980 Priority
- Section
- - - - Quarter Quarter
- Tax Lot

Well 1 (LAKE 1166) Location:
S 1319.99', W 1305.75' W
of the N 1/4 Cor Sec 8

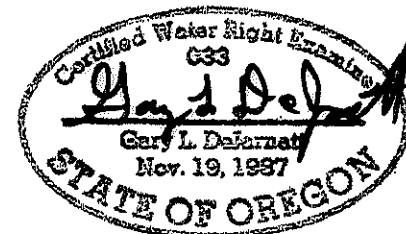

RENEWAL DATE 12/31/2023



CLAIM OF BENEFICIAL USE MAP 1 of 2
Nofziger Ranch

Date: 11/14/2022

T-13865

Project #22071

This map is not intended
to provide legal dimensions
or locations of property
ownership lines.

WATER RIGHT SERVICES, LLC
PO BOX 1830, BEND, OR 97709
WWW.OREGONWATER.US CCB # 197121
johnshort@usa.com 541-389-2837

**T27S R17E, WM,
LAKE COUNTY, OR**



0 1,320 Feet


1" = 1,320'

13

18

17

Mountain St

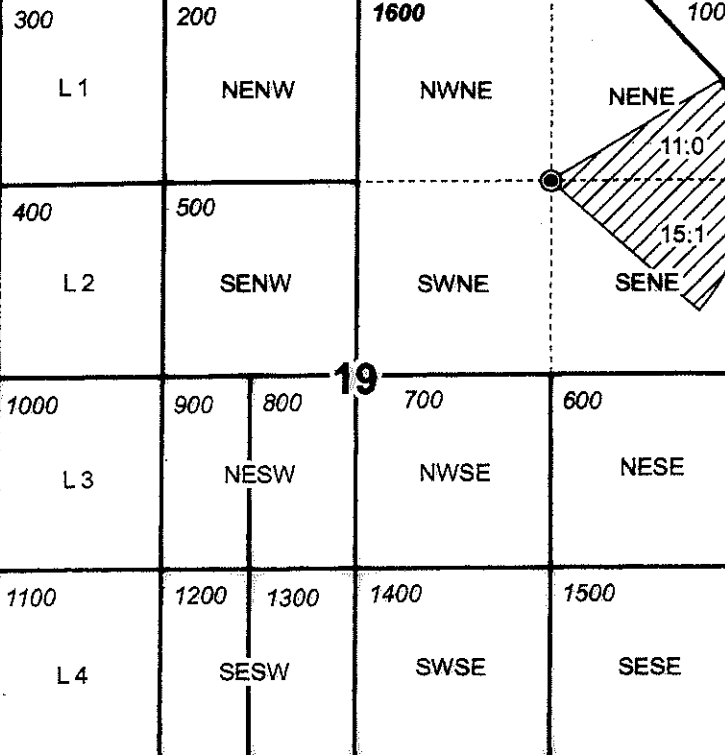

- Well 3 (LAKE 1027) & Meter
- POU IR (from C-91152) 4/5/1982 Priority
- Township
- Section
- Quarter Quarter
- Tax Lot

Well 3 (LAKE 1027) Location:
1322' S, 1335' W of NE Cor Sec 19

24


20

30

29

25

DEC 9 2022

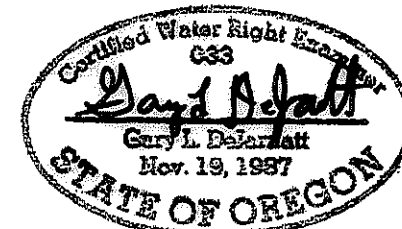

RENEWAL DATE 12/31/2023



**CLAIM OF BENEFICIAL USE MAP 2 of 2
Nofziger Ranch**

Date: 11/14/2022

T-13865

Project #22071

This map is not intended
to provide legal dimensions
or locations of property
ownership lines.

WATER RIGHT SERVICES, LLC
PO BOX 1830, BEND, OR 97709
WWW.OREGONWATER.US CCB # 197121
johnshort@usa.com 541-389-2837