



CLAIM OF BENEFICIAL USE
 APPLICATION G-17537 - PERMIT G-16996
 SITUATED IN
 SECTIONS 22 & 27
 T.38S., R.5W., W.M.
 JOSEPHINE COUNTY, OREGON
 FOR
 JOSEPH GINET
 16955 WATER GAP ROAD
 WILLIAMS, OR 97544

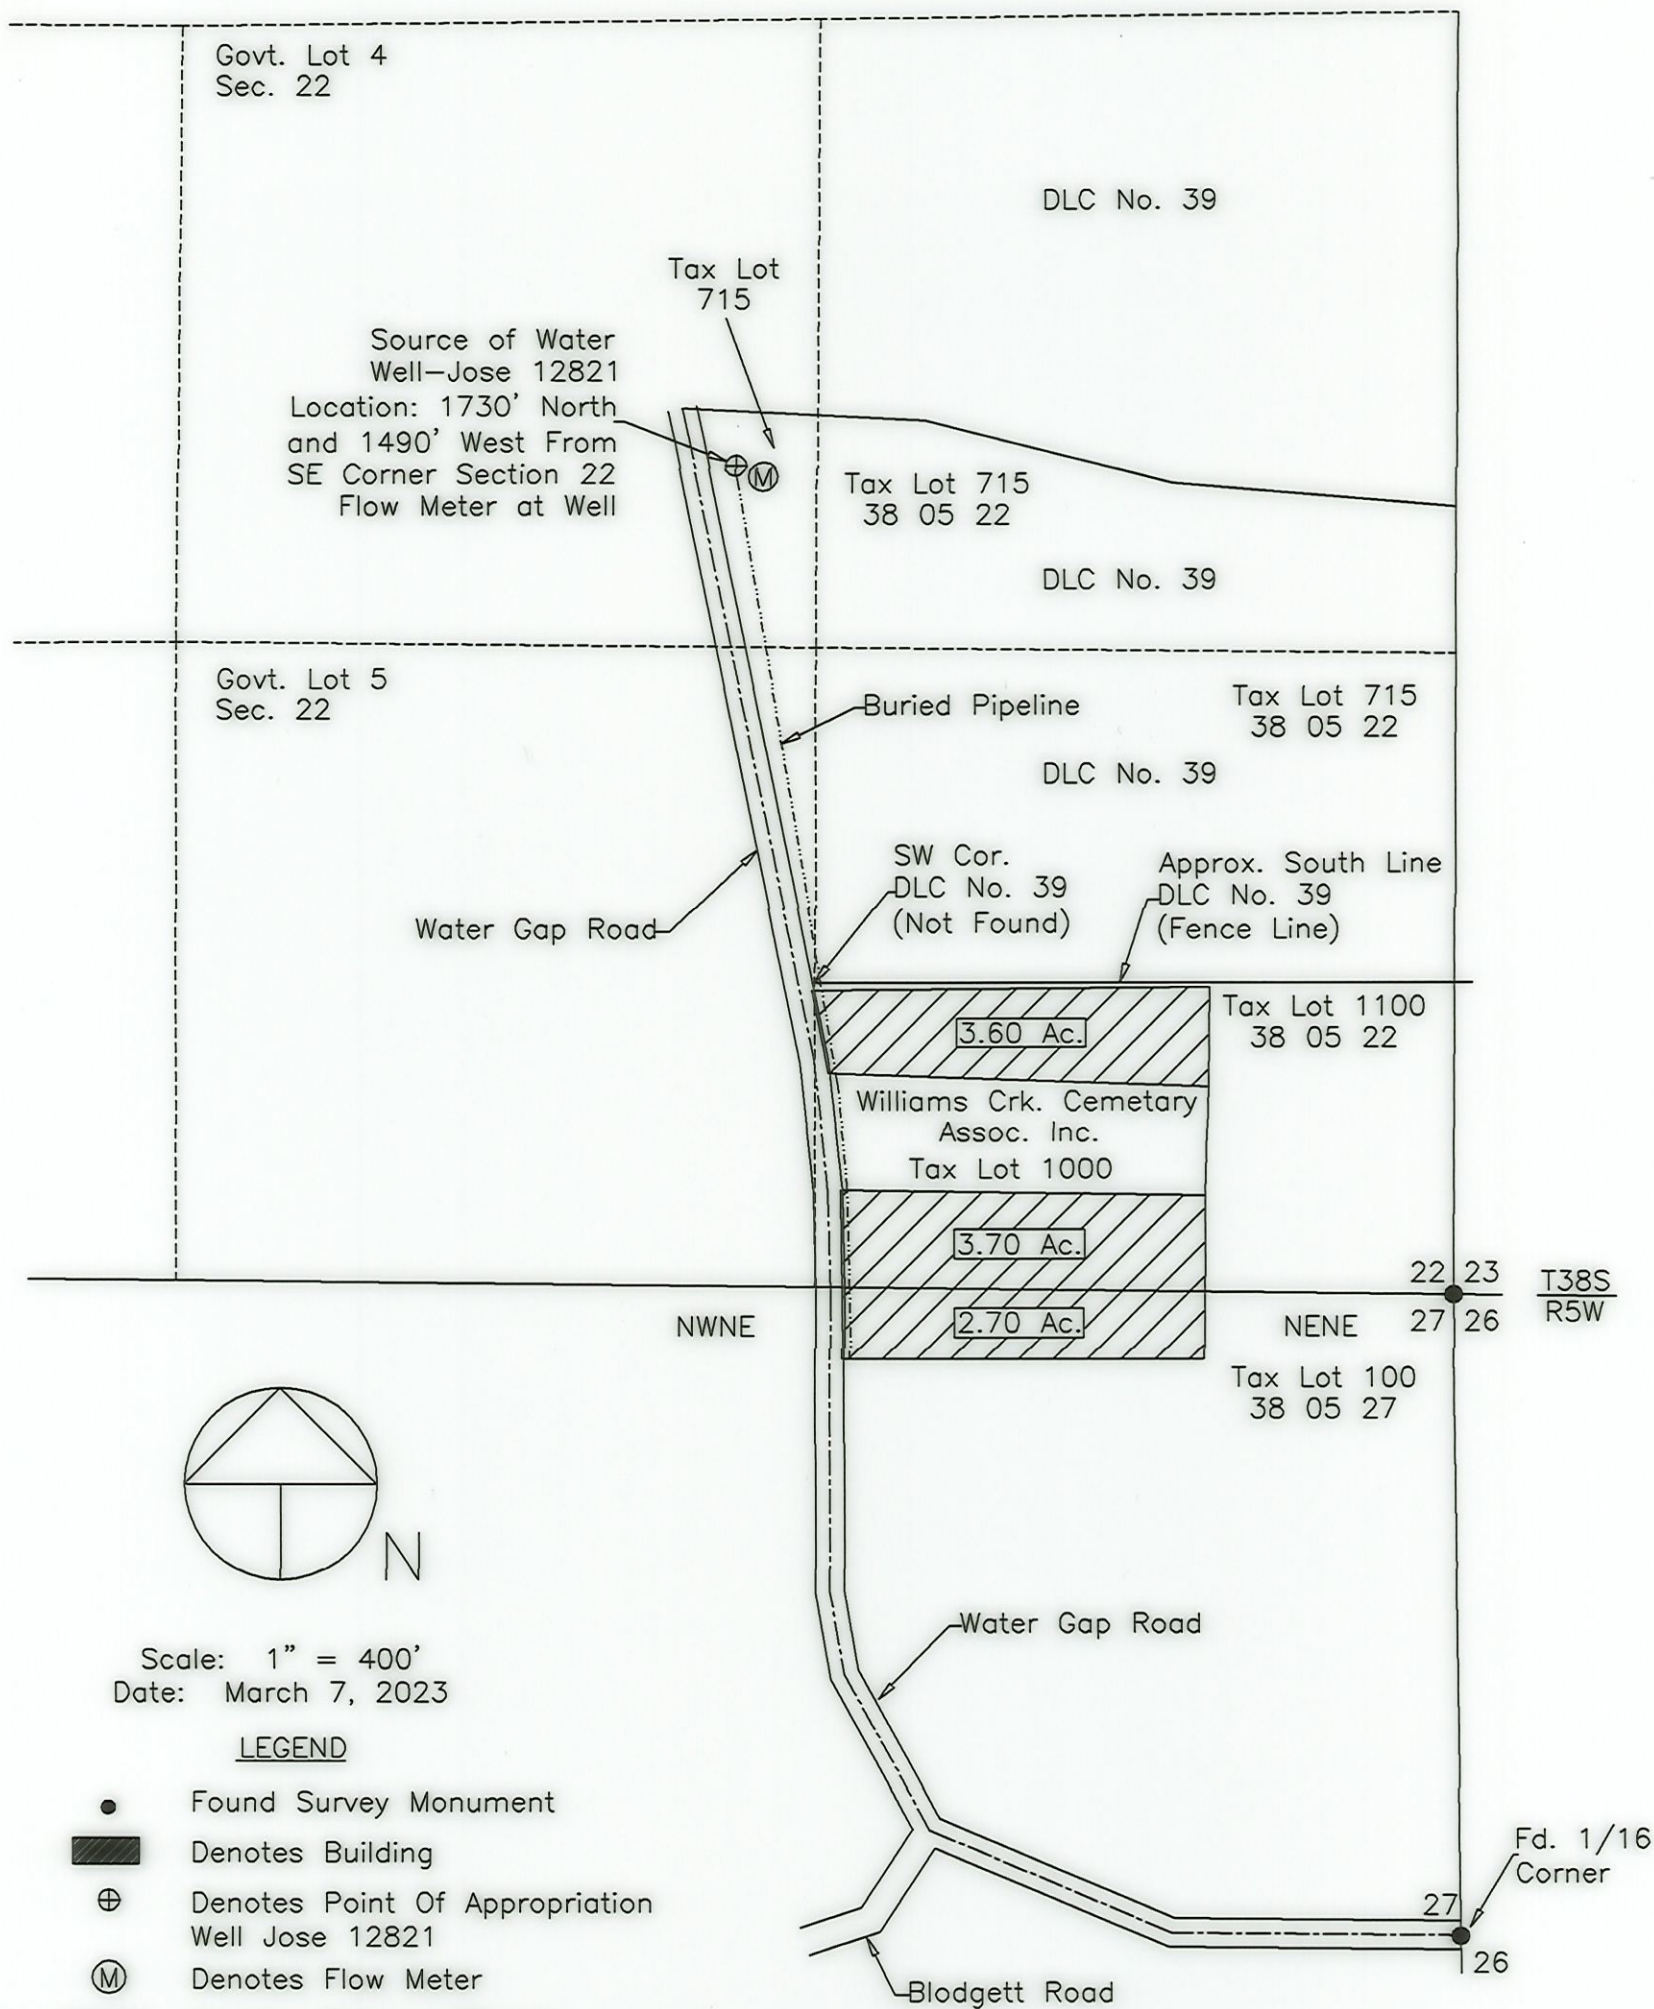

This map was prepared for the purpose of identifying the location of a water right only and is not intended to provide legal dmensions or location of property ownership.

Project: 22-7 GINET

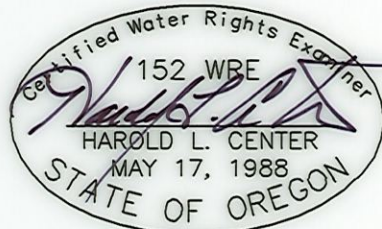

Renews: 12/31/23

HAROLD L. CENTER
 2604 David Lane
 Medford, OR. 97504
 Phone 541-535-6108
 Oregon Certificate No. 152

RECEIVED
 APR 19 2023
 OWRD