


G9612
52879

T.27S.,R.19E.,W.M.

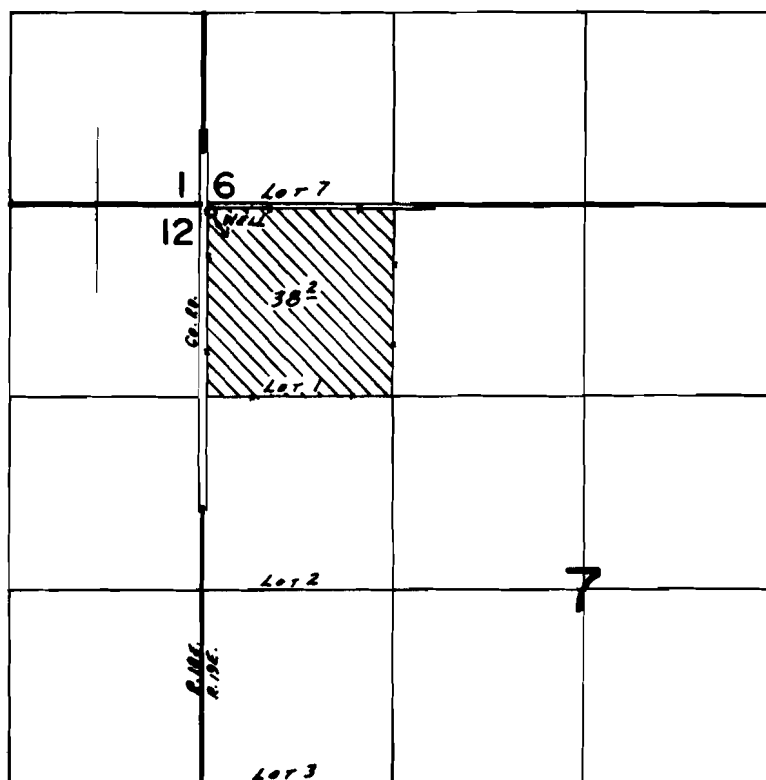

WELL LOC: 30'S. & 30'E. FROM NW COR. SEC. 7

SCALE: 1"=1320'



FINAL PROOF SURVEY
UNDER

Application No. G-10442 Permit No. G-9612.....
IN NAME OF

.....HARLAN F. OSTER.....

Surveyed OCT. 12... 19.84, by B.W. BISHOP.....

**T27S R19E, WM,
LAKE COUNTY, OR**

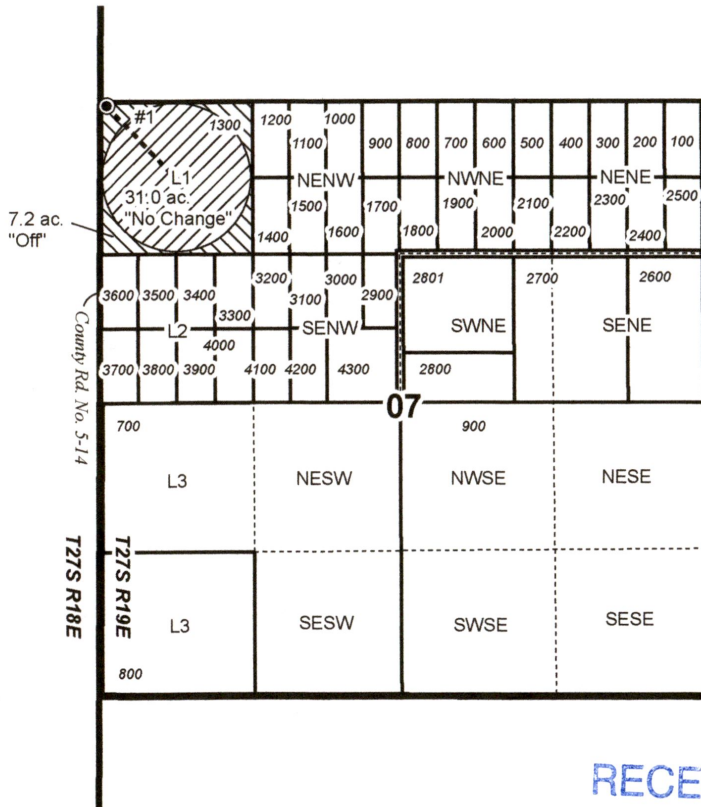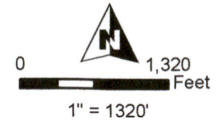

- Well
- Pipeline
- POU IR C-52879 "OFF"
- POU IR C-52879 "NO CHANGE"
- Township
- Section
- Quarter Quarter
- Tax Lot

Well Location:

#1 (LAKE 1164): 30' S, 50' E of NW Cor Sec 7



RENEWAL DATE 12/31/2024

RECEIVED

MAY 18 2023

**OWRD
SALEM, OREGON**

14245 -

**PERMANENT TRANSFER "OFF" MAP
OSTER**

Date: 3/22/2023

C-52879 7/10/1981 Priority

This map is not intended
to provide legal dimensions
or locations of property
ownership lines.

WATER RIGHT SERVICES, LLC

PO BOX 1830, BEND, OR 97709

WWW.OREGONWATER.US 541-389-2837

johnshort@usa.com

CCB # 197121