


T. 26 S., R. 19 E., W.M.

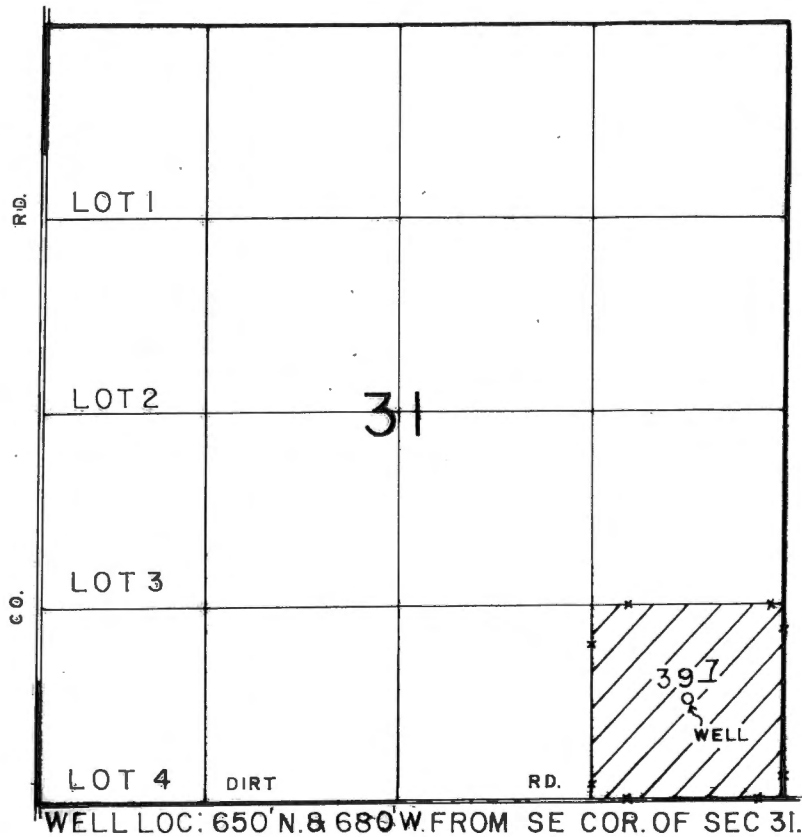

SCALE 1"=1320'

FINAL PROOF SURVEY

UNDER

TRANSFER NO. 5531
IN NAME OF

HARLAN F. & ELOISE OSTER



Surveyed APRIL 7, 1992, by B.W. BISHOP

RECEIVED

MAY 18 2023

OWRD
SALEM, OREGON

T26S R19E, WM,
LAKE COUNTY, OR

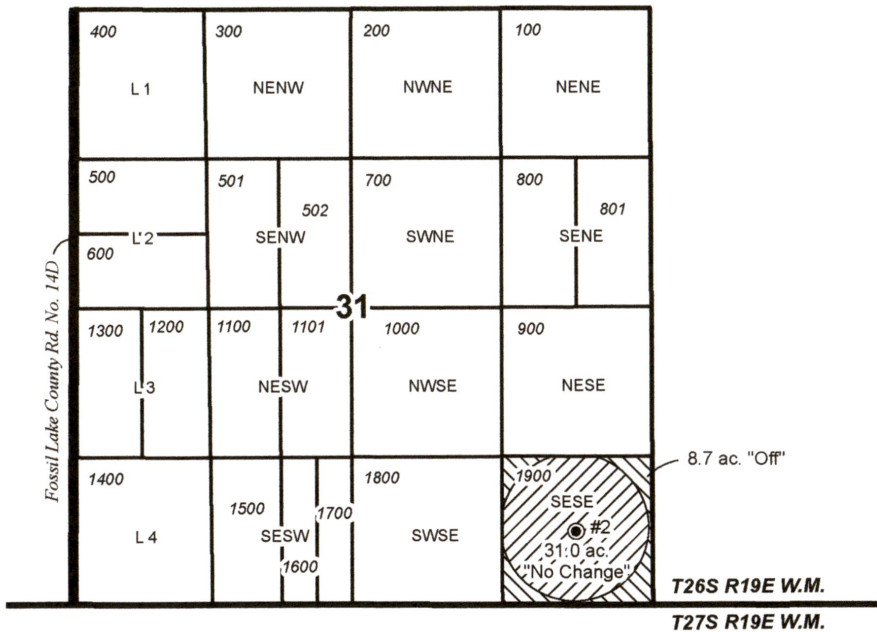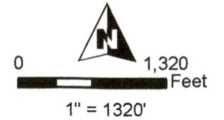

● Well

POU IR C-96715 "OFF"

POU IR C-96715 "NO CHANGE"

Township

Section

Tax Lot

Well Location:

#2 (No Log No. Assigned): 650' N, 680' W of SE Cor Sec 31



14245 - =

RENEWAL DATE 12/31/2024

**PERMANENT TRANSFER "OFF" MAP
OSTER**

Date: 3/22/2023

C-96715 9/25/1975 Priority

This map is not intended
to provide legal dimensions
or locations of property
ownership lines.

WATER RIGHT SERVICES, LLC
PO BOX 1830, BEND, OR 97709

WWW.OREGONWATER.US 541-389-2837

johnshort@usa.com

CCB # 197121