


T37S R4W & T38S R4W WM, JACKSON COUNTY, OR

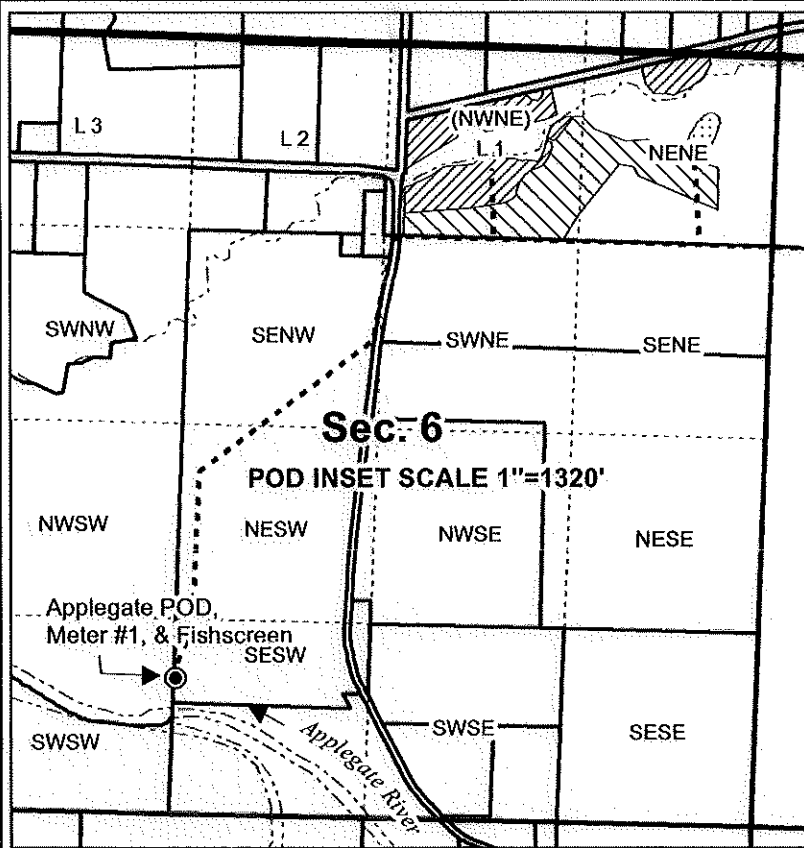

● POD & Fishscreen

□ Meter

----- Creek/River Bank

----- Pipeline

POU IR S-54863

POU (IS) S-54863

Reservoir

Township

Section

----- DLC


----- Quarter Quarter

Tax Lot

RECEIVED

DEC 28 2023

OWPD

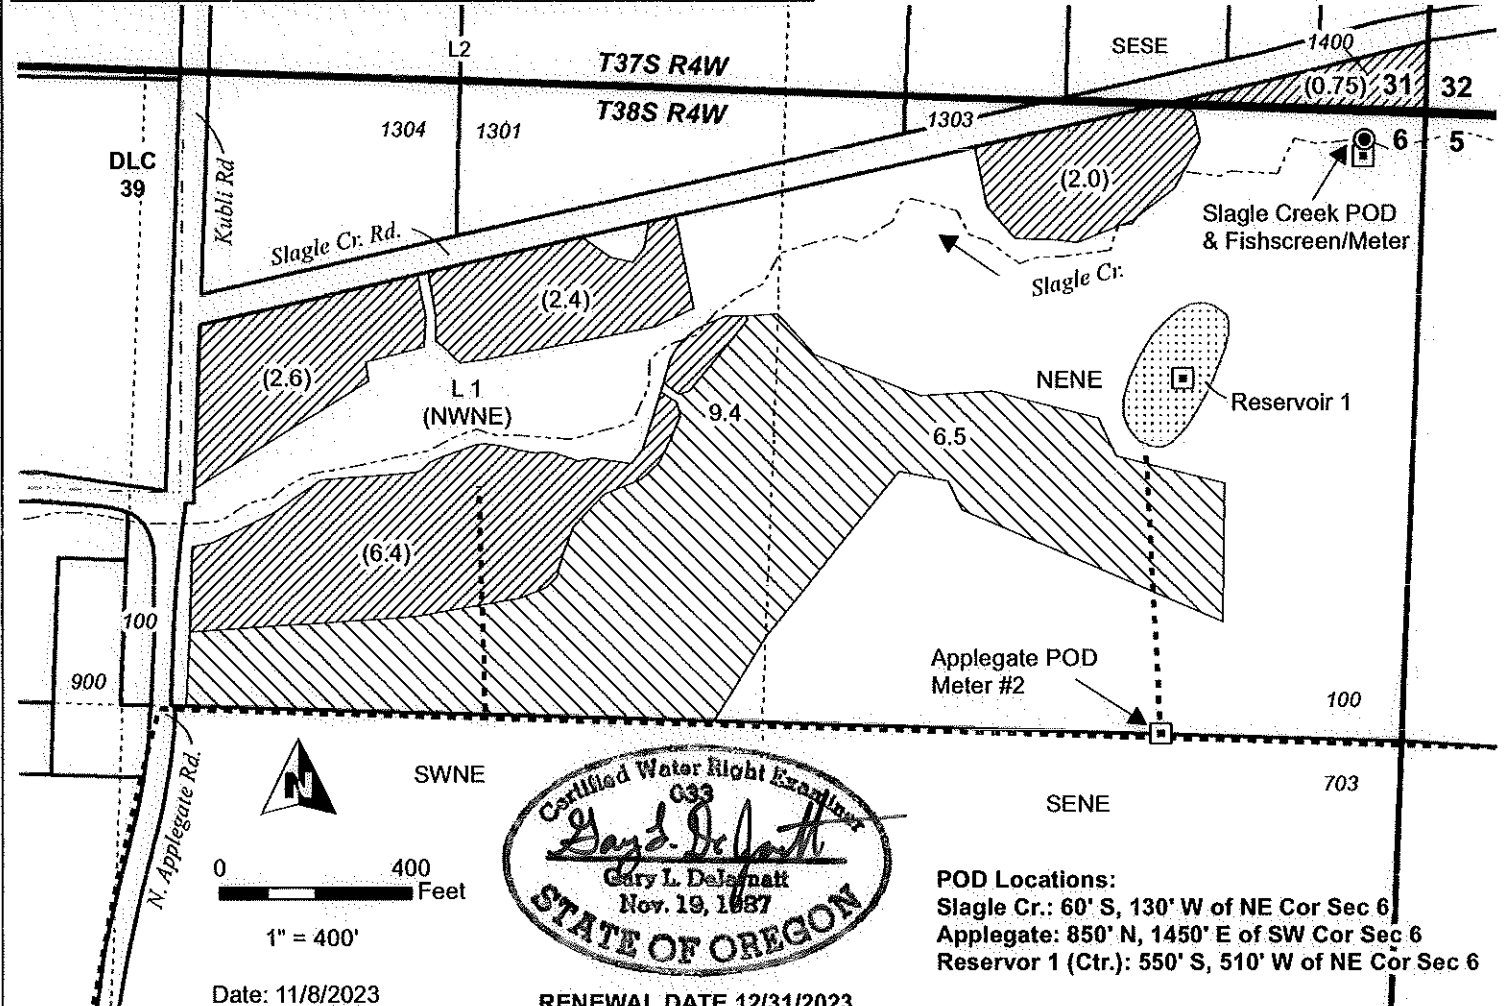

POD Locations:

Slagle Cr.: 60' S, 130' W of NE Cor Sec 6

Applegate: 850' N, 1450' E of SW Cor Sec 6

Reservoir 1 (Ctr.): 550' S, 510' W of NE Cor Sec 6

CLAIM OF BENEFICIAL USE MAP Ressler

Project #23053 / Ap R-87640 / Permit R-15024
Project #23054 / Ap S-87641 / Permit S-54863

This map is not intended
to provide legal dimensions
or locations of property
ownership lines.

WATER RIGHT SERVICES, LLC

PO BOX 1830, BEND, OR 97709

WWW.OREGONWATER.US CCB # 197121

johnshort@usa.com 541-389-2837