


PORTLAND GENERAL ELECTRIC COMPANY
CARTY PLANT - CLAIM OF BENEFICIAL USE MAP
PERMIT NO. S-54925
LOCATED IN SECTIONS 33 AND 34, TOWNSHIP 3 NORTH, RANGE 24 EAST OF
THE WILLAMETTE MERIDIAN

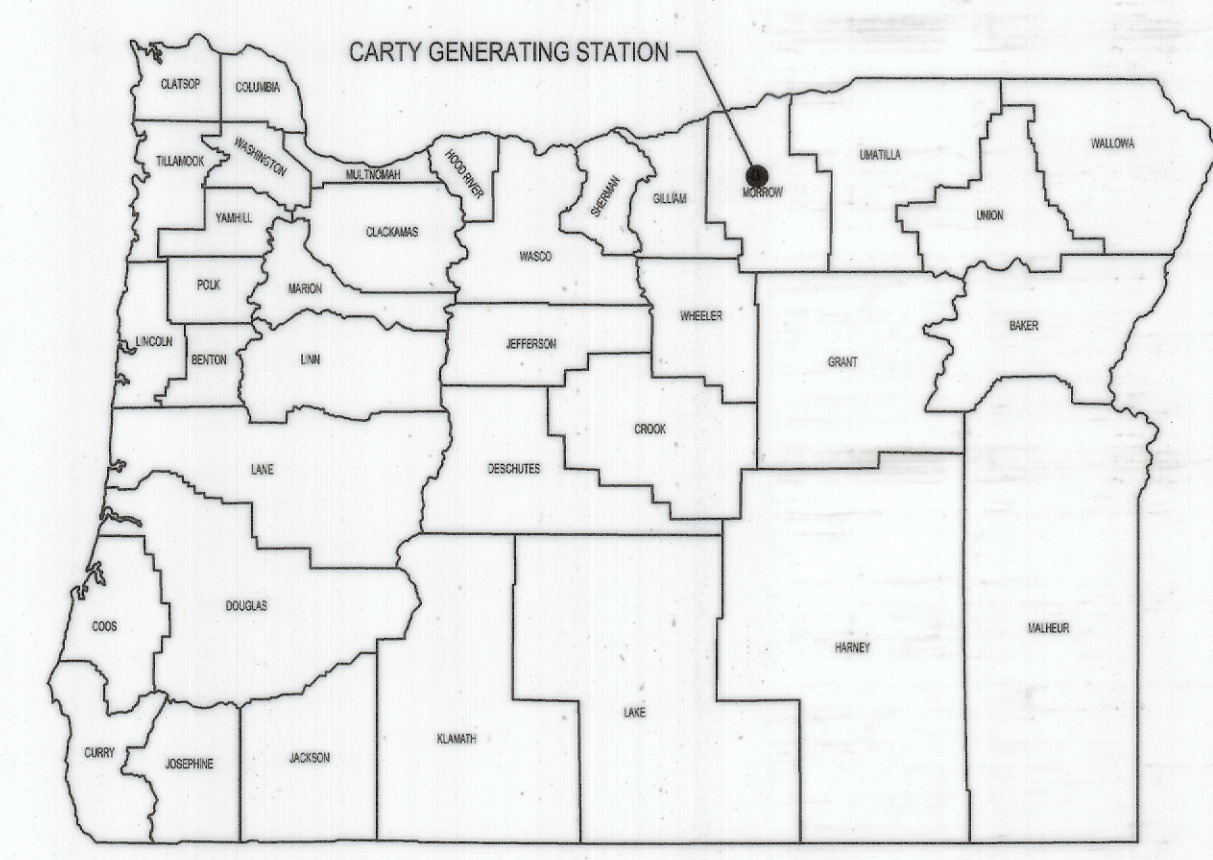

OREGON STATE LOCATION MAP
SCALE: N.T.S.

NOTES

1. THE PURPOSE OF THIS MAP IS TO SHOW FEATURES FOR A CLAIM OF BENEFICIAL USE APPLICATION FOR PERMIT S-54925.
2. THIS MAP IS NOT INTENDED TO PROVIDE LEGAL DIMENSIONS OR LOCATIONS OF PROPERTY OWNERSHIP LINES.


PROJECT ADDRESS:
CARTY GENERATING STATION
73396 TOWER ROAD
BOARDMAN, OR 97818

OWNER:
PORTLAND GENERAL ELECTRIC
121 SW SALMON ST.
PORTLAND, OR 97204

SURVEYOR:
PORTLAND GENERAL ELECTRIC
121 SW SALMON ST.
PORTLAND, OR 97204
PHONE: 503-464-8149
CONTACT: JEFF DANIELSON

LEGEND



- PROPERTY LINE
- QUARTER/QUARTER SECTION LINE
- FENCE LINE
- UNDERGROUND WATER LINE
- PLACE OF USE (PGE PROPERTY)
- WTR WATER METER

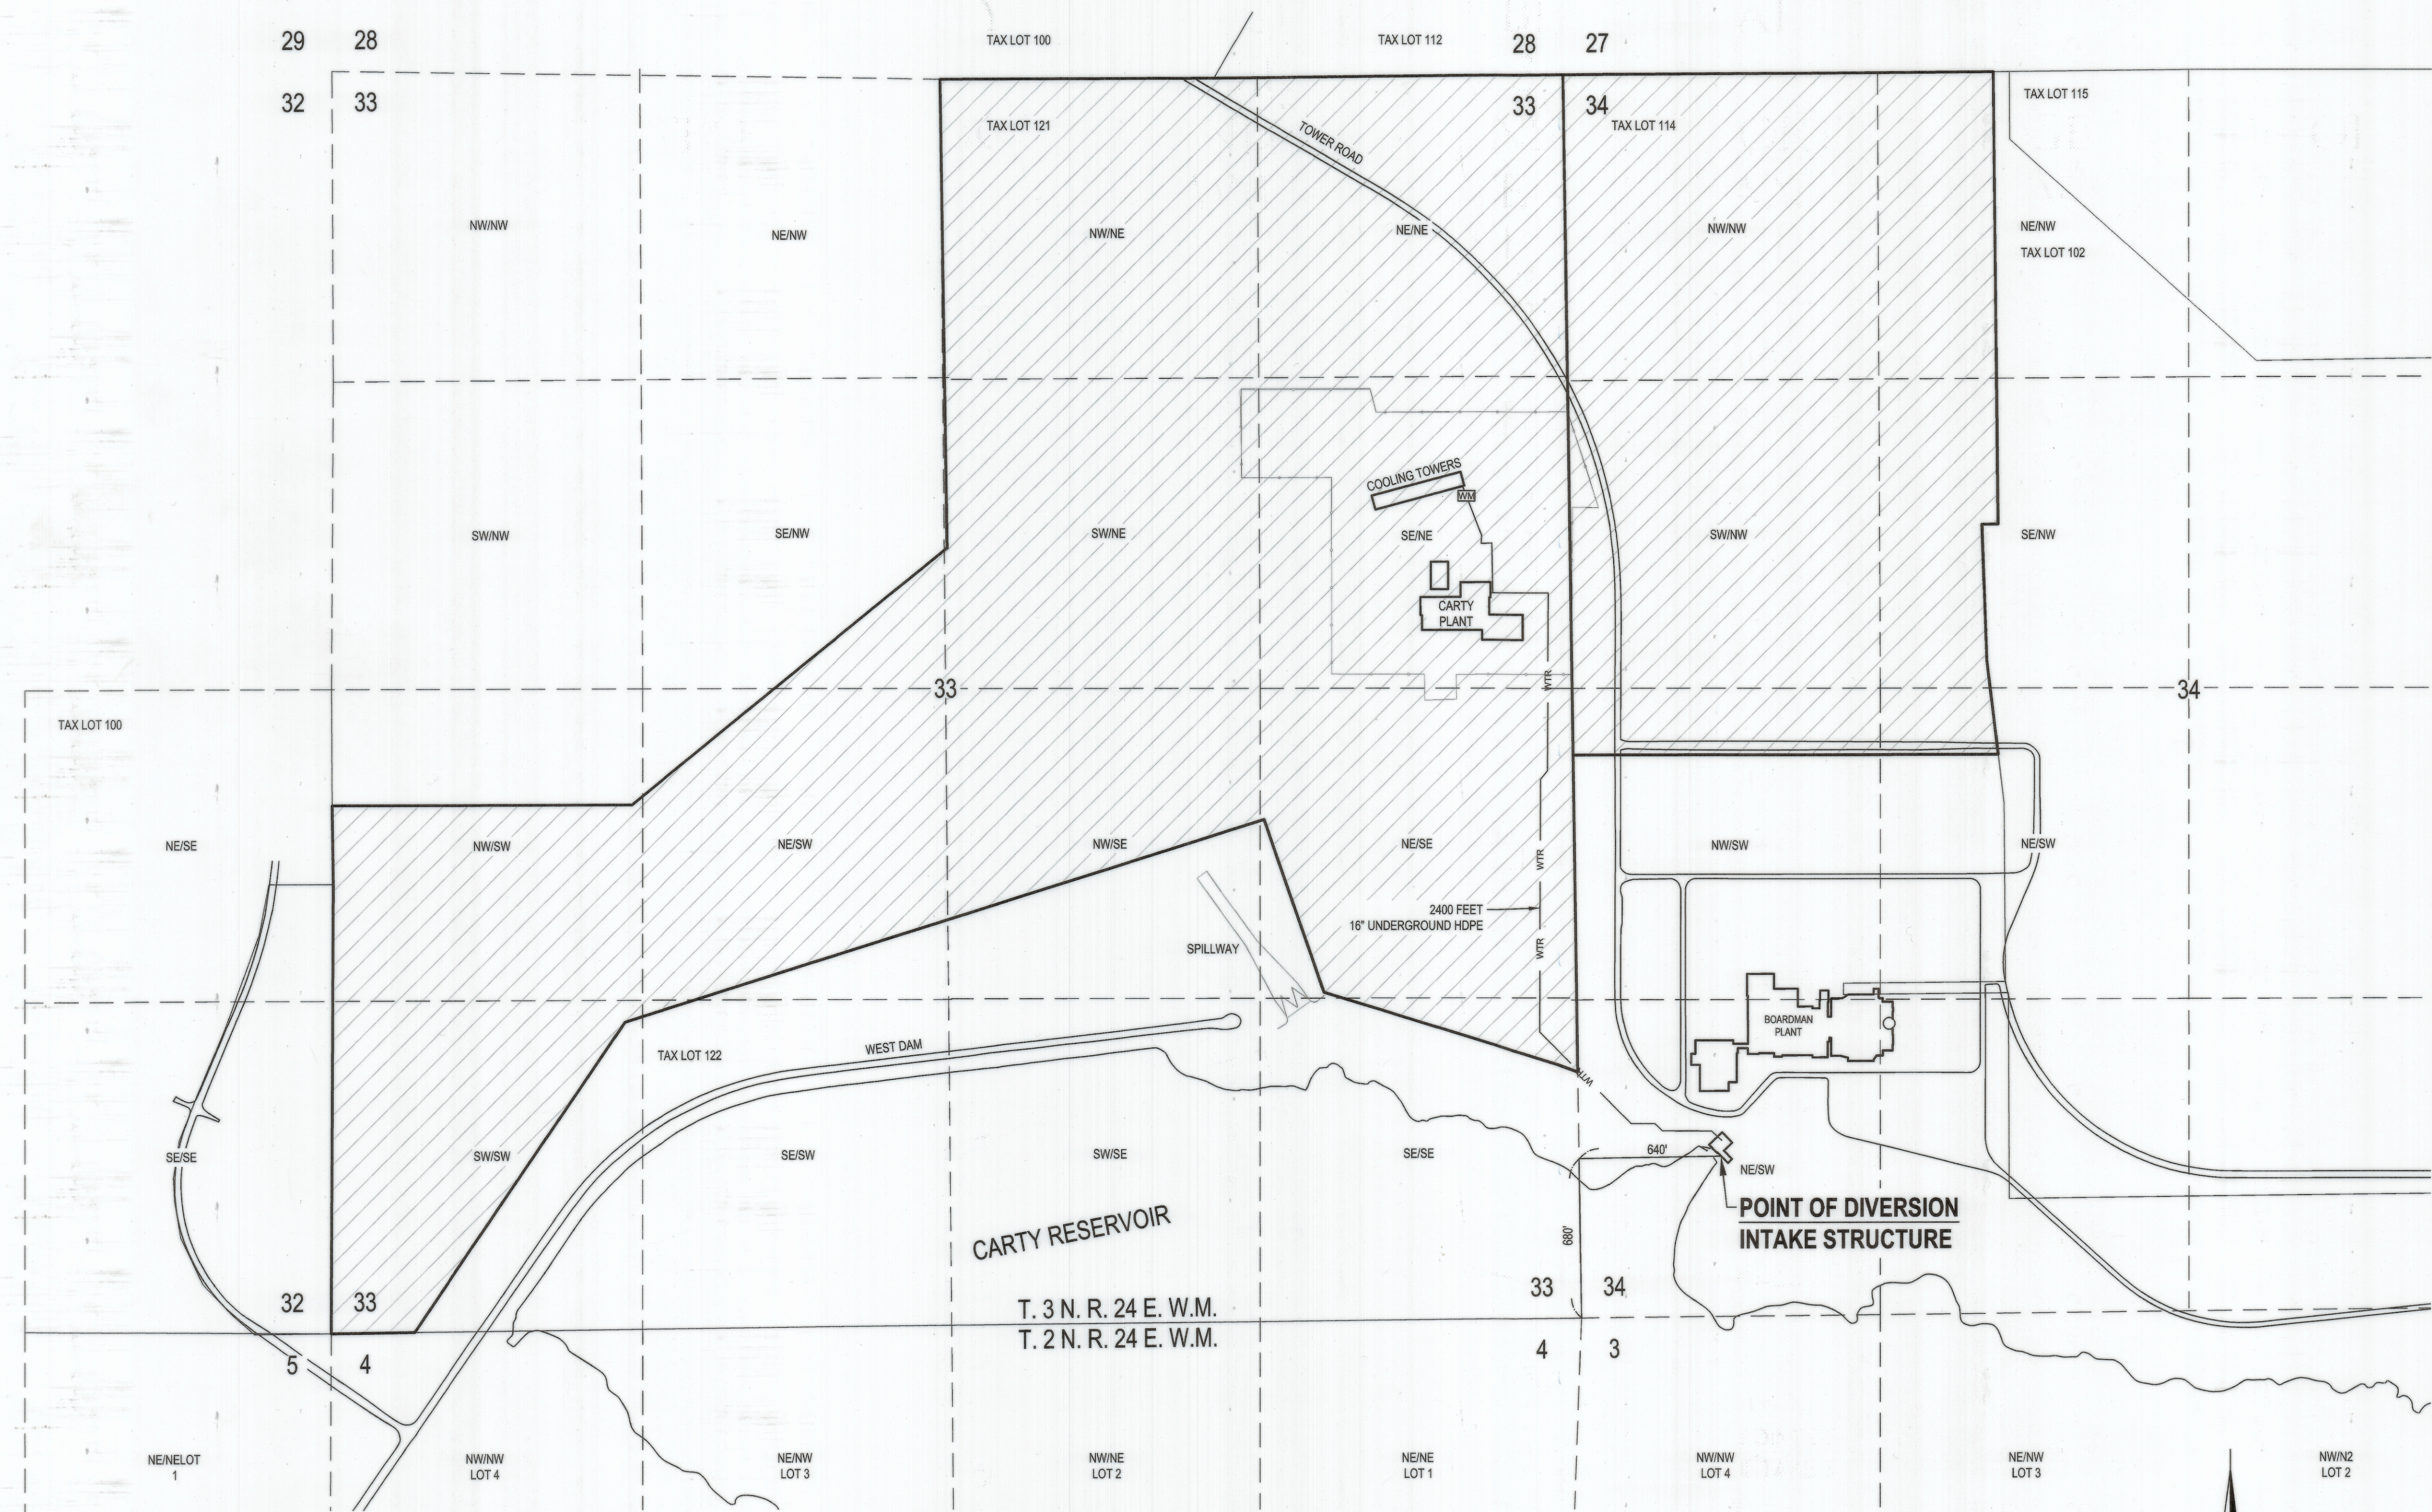

CARTY RESERVOIR
T. 3 N. R. 24 E. W.M.
T. 2 N. R. 24 E. W.M.

POINT OF DIVERSION
INTAKE STRUCTURE

RECEIVED
APR 23 2021
OWRD

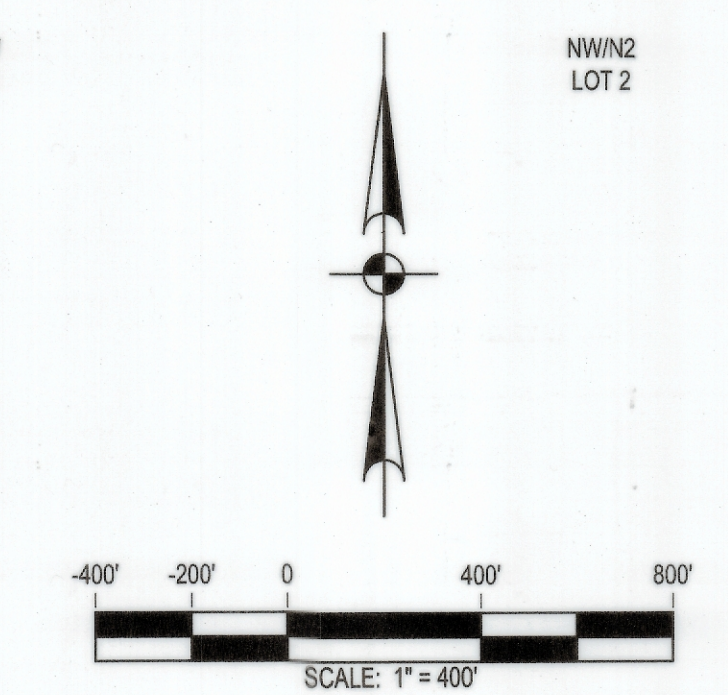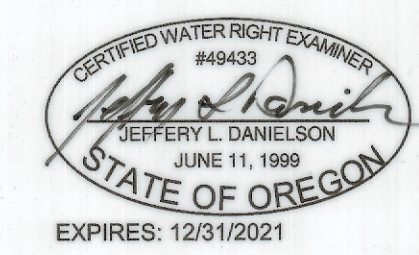

WARNING
IF THIS DRAWING IS NOT MEASURED
THEN DRAWING IS NOT TO SCALE
Public
Access Not Limited

DATE: MM/DD/YYYY	WORK ORDER NO.:	CHECKED BY:
DRAWN BY:	FOR:	MANAGER: JEFF DANIELSON
SCALE: AS-SHOWN	CAD FILE NAME: CY-COBU-PERMIT-S-54925_CXMP	
PORTLAND GENERAL ELECTRIC CO. 121 SW SALMON ST. PORTLAND, OR 97204		
CARTY PLANT MAP TO ACCOMPANY CLAIM OF BENEFICIAL USE APPLICATION PERMIT NO. S-54925 MORROW COUNTY, OREGON		
DRAWING NO.:	SHEET NO.:	REV. NO.:
	CARTY-COBU -V1	