
## T12S, R4W & R5W, WM

LINN COUNTY

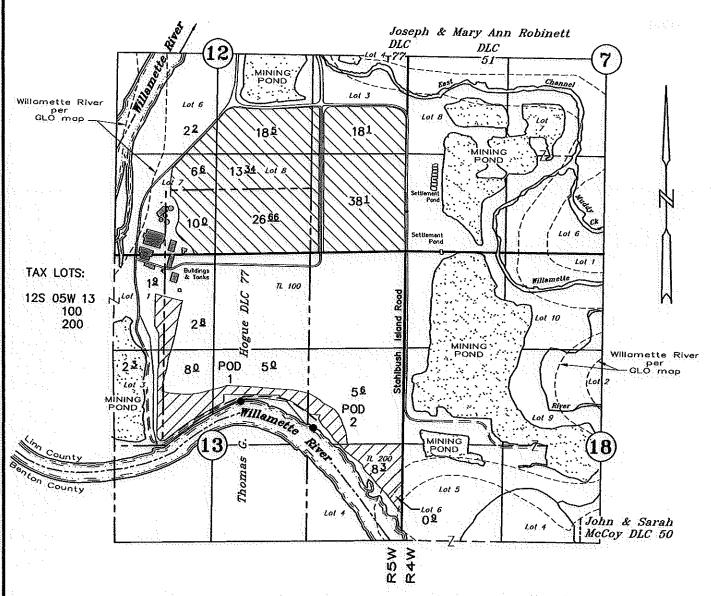

POD 1, RAIL PUMP: POD 1 METER:

2050' SOUTH AND 2268' WEST OF NE COR SECTION 13

POD 2, BEACH PUMP:

2020' SOUTH AND 2273' WEST OF NE COR SECTION 13

POD 2 METER:

2414' SOUTH AND 1276' WEST OF NE COR SECTION 13

2353' SOUTH AND 1222' WEST OF NE COR SECTION 13 ODFW APPROVED FISH SCREENS ARE ON THE END OF THE INTAKE PIPE AT EACH POD

## CLAIM of BENEFICIAL USE

IRRIGATION

Application No. S-87999

Permit No. S-54951

SUPPLEMENTAL **IRRIGATION** 

## WK&K LAND, LLC

**AUGUST 27, 2020** SCALE 1'' = 1320'

NOTE: This map is not intended to provide legal dimensions or locations of property ownership lines.



Renewal Date: December 31, 2021