


CLAIM OF BENEFICIAL USE MAP

FOR: HARVEY & DOLORES WHITE
 BY: NATHAN REED, PE, CWRE
 T28S, R6W, W.M. SECTION 21, DLC 52
 APPLICATION NO. S-88102
 PERMIT NO. S-54963

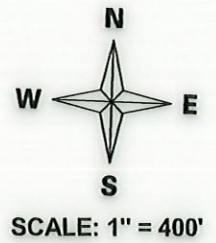


DATE SURVEYED: APRIL 30, 2021

RECEIVED

MAY 12 2021

OWRD

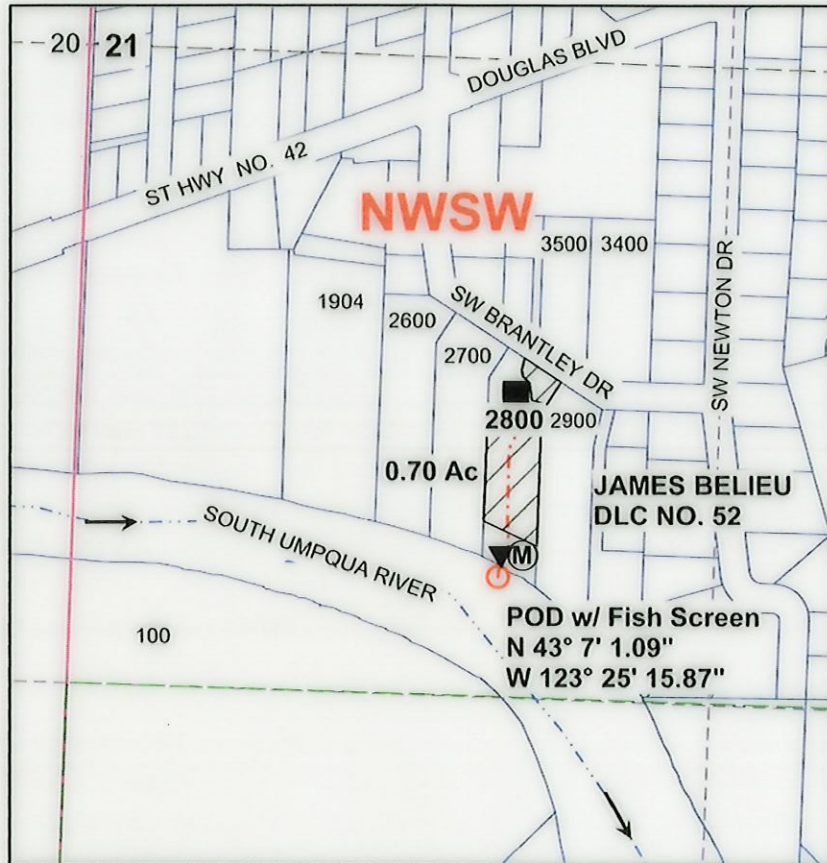


POD IS LOCATED 1610 FEET NORTH AND 880 FEET EAST FROM THE SW CORNER, SECTION 21 AS PROJECTED IN JAMES BELIEU DLC NO. 52.

MAP PREPARED FOR:
 HARVEY & DOLORES WHITE
 121 SW BRANTLEY DR
 WINSTON, OR 97496

Legend

	Stream		Meter		Section
	Flow arrow		PUMP		Quarter
	POD		Structures		Sixteenth
	Pipeline		Irrigation Area		Parcels

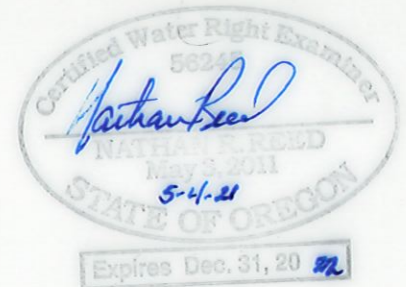

THE PURPOSE OF THIS MAP IS TO IDENTIFY THE LOCATION OF THE WATER RIGHT. IT IS NOT INTENDED TO PROVIDE INFORMATION RELATIVE TO THE LOCATION OF PROPERTY OWNERSHIP BOUNDARY LINES.

MAP PREPARED BY:
 NATHAN R. REED, PE, CWRE
 157 WEST BODIE STREET
 ROSEBURG, OR 97471