


T.6S. R.1E. Sec. 16, 17, & 20, W.M.

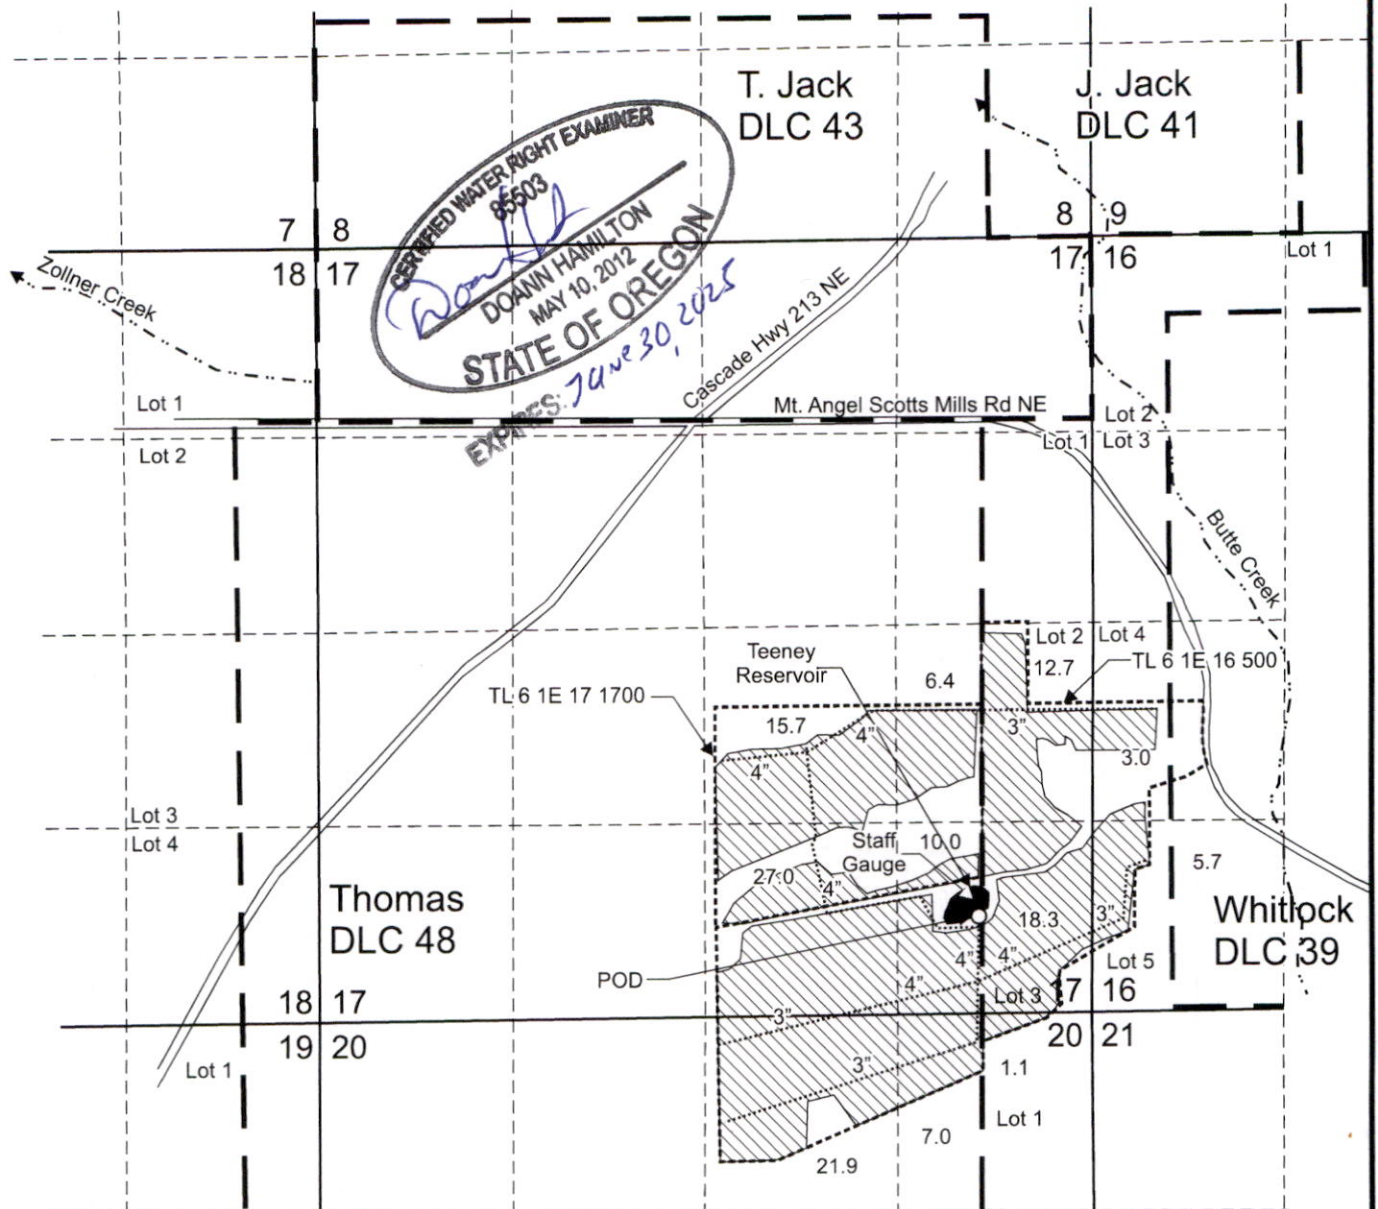

POD for Teeney Reservoir is located 660 feet north and 775 feet west from the SE corner, Section 17.

Area (128.8 Acres) irrigated under Application S-88755, Permit S-55209.

- Tax lot boundary
- . — Donation Land Claim boundary
- Irrigation mainline

Scale: 1" = 1,320'



RECEIVED

OCT. 10 2023

OWRD

This map was prepared for the purpose of identifying the location of a water right only and is not intended to provide legal dimensions or location of property ownership lines.

Claim of Beneficial Use Map
Application S-88755, Permit S-55209

Kraemer Farms (Teeney)
T.6S. R.1E. Sec. 16, 17, & 20, W.M.

Pacific Hydro-Geology Inc.

07/2023