

Claim of Beneficial Use - Point of Diversion Map Permit S-47330, Application S-64559

A Water Right held by City of Jefferson Marion County

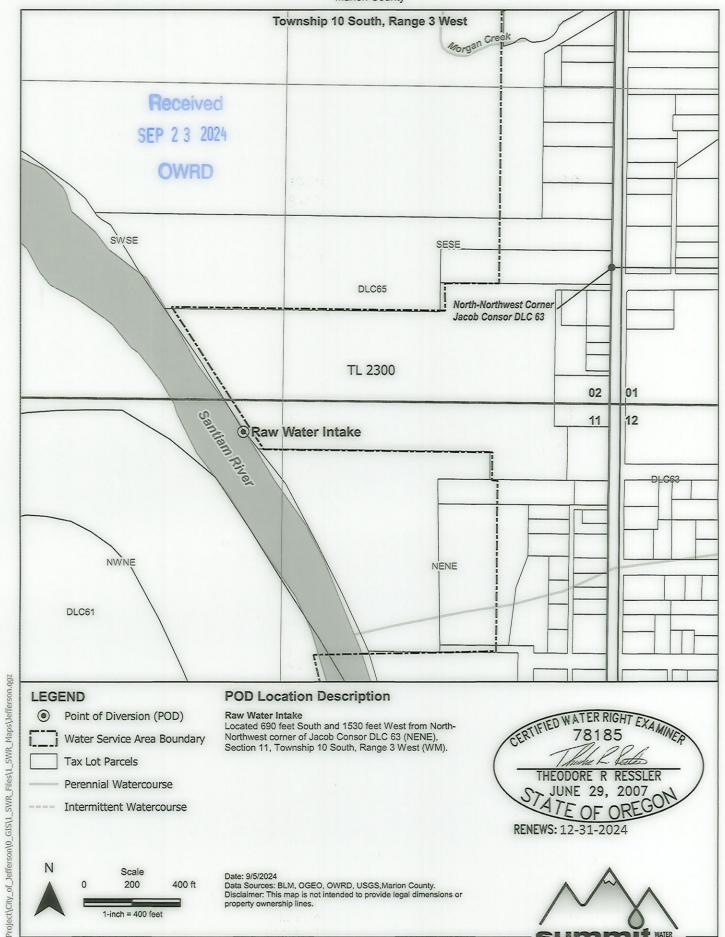

Claim of Beneficial Use - Place of Use Map Permit S-47330, Application S-64559

A Water Right held by City of Jefferson Marion County

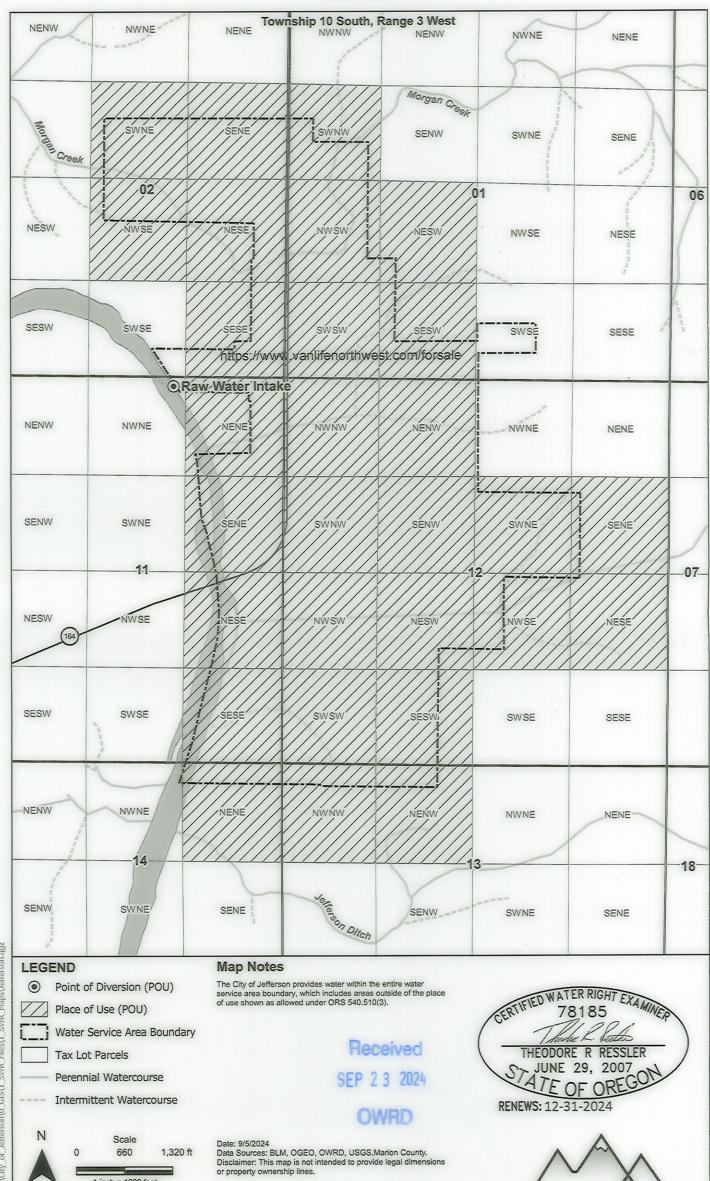

Project\City_of_Jefferson\0_GIS\1_SWR_Files\1_SWR_Maps\Jeffers