


T. 16S., R. 24E., W.M.

RECEIVED

OCT 01 2014

WATER RESOURCES DEPT
SALEM, OREGON

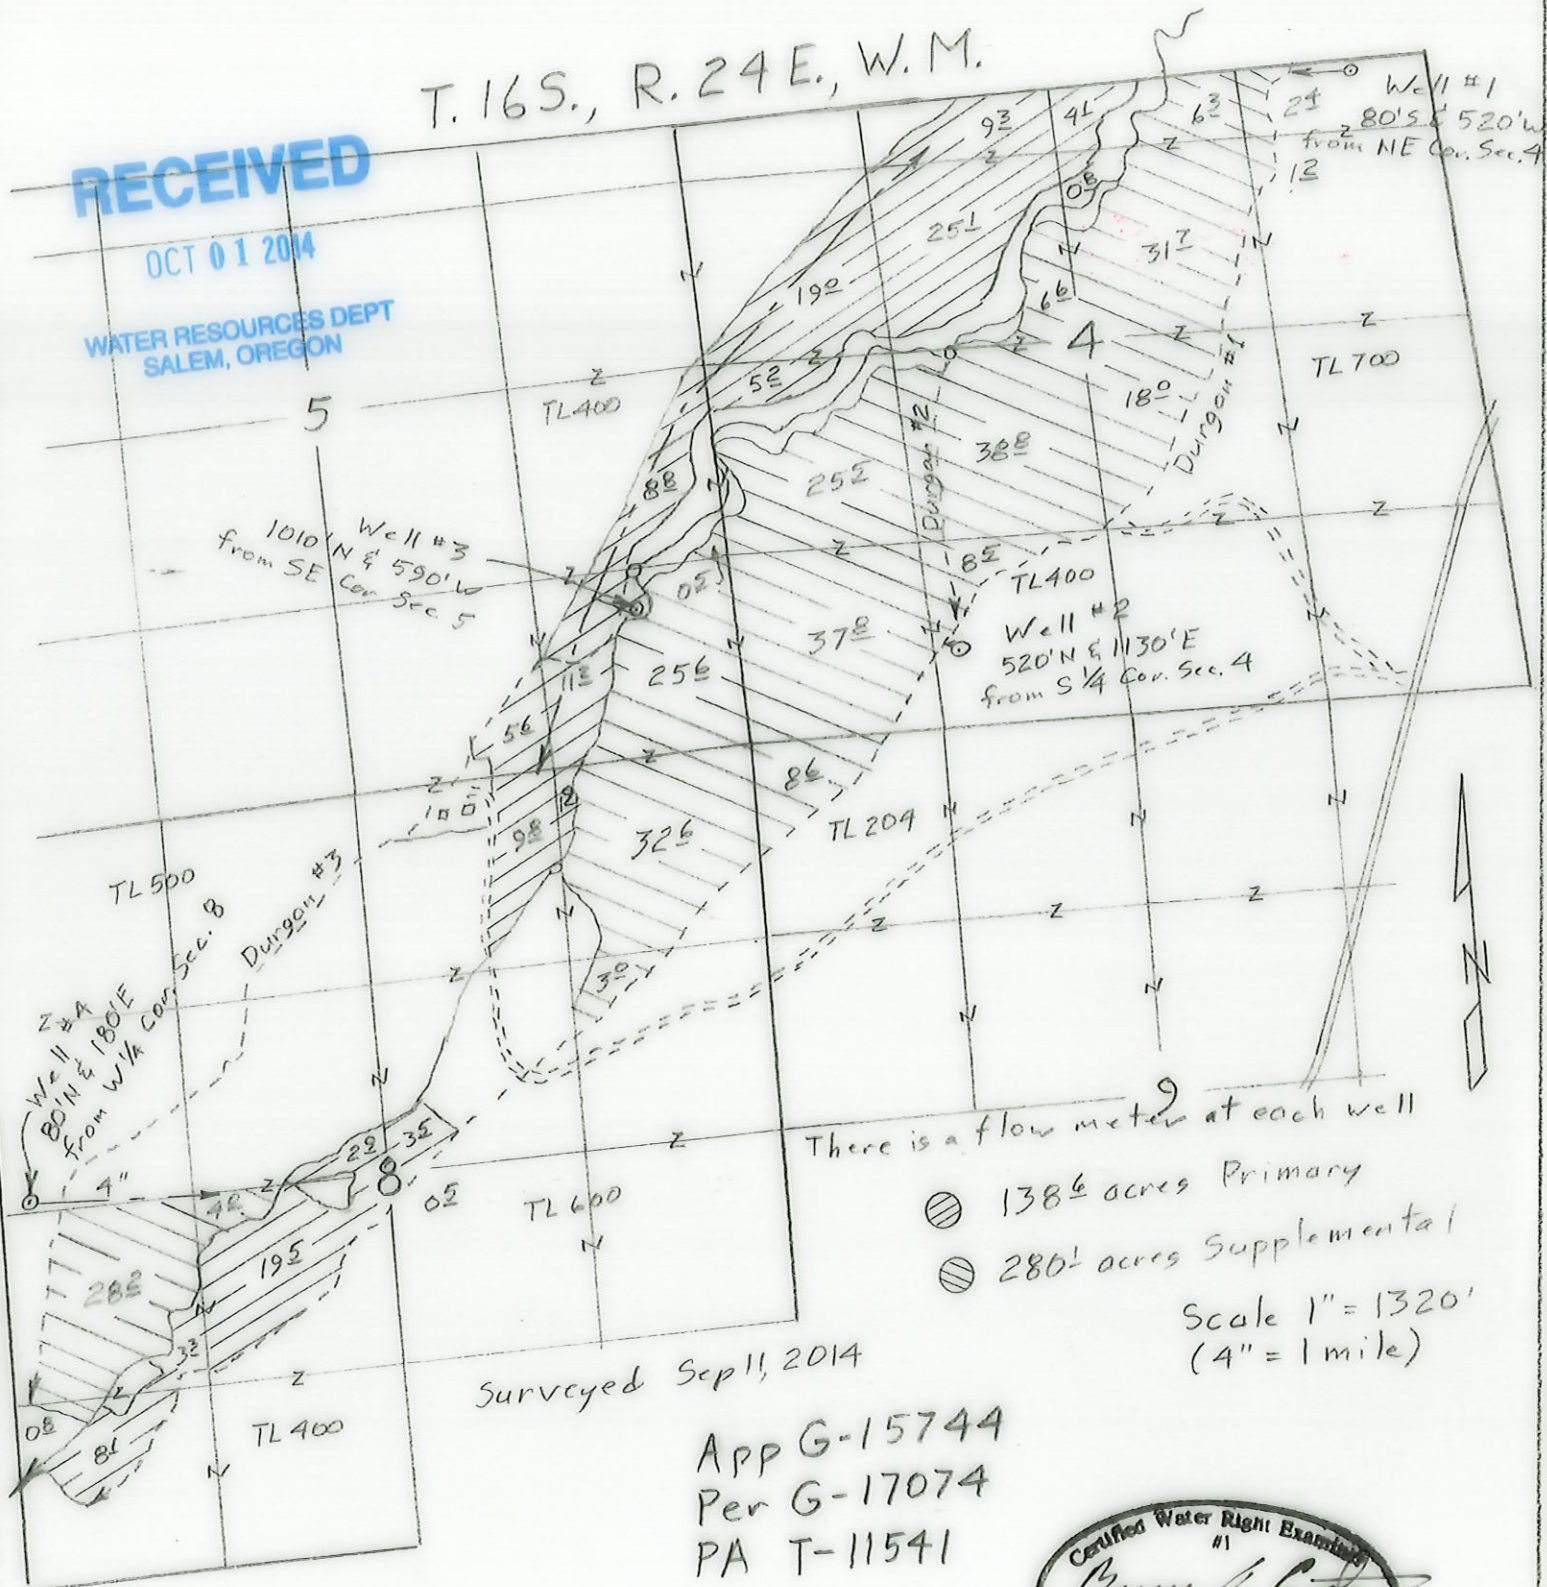

There is a flow meter at each well

- 138.6 acres Primary
- 280.1 acres Supplemental

Scale 1" = 1320'
(4" = 1 mile)

Surveyed Sep 11, 2014

APP G-15744
Per G-17074
PA T-11541

Claim of Beneficial Use Map
for
Durgan Ranch, LLC

This map is for the purpose of
locating a water right only
and has no intent to provide
legal dimensions or the location
of property lines.



Renewal Dec 31, 2015

ESTES SURVEYS, LLC

PO Box 17519
Salem, OR 97305-7519
(503) 585-7583

60382 Arnold Rd
Bend, OR 97702
(541) 382-7391