



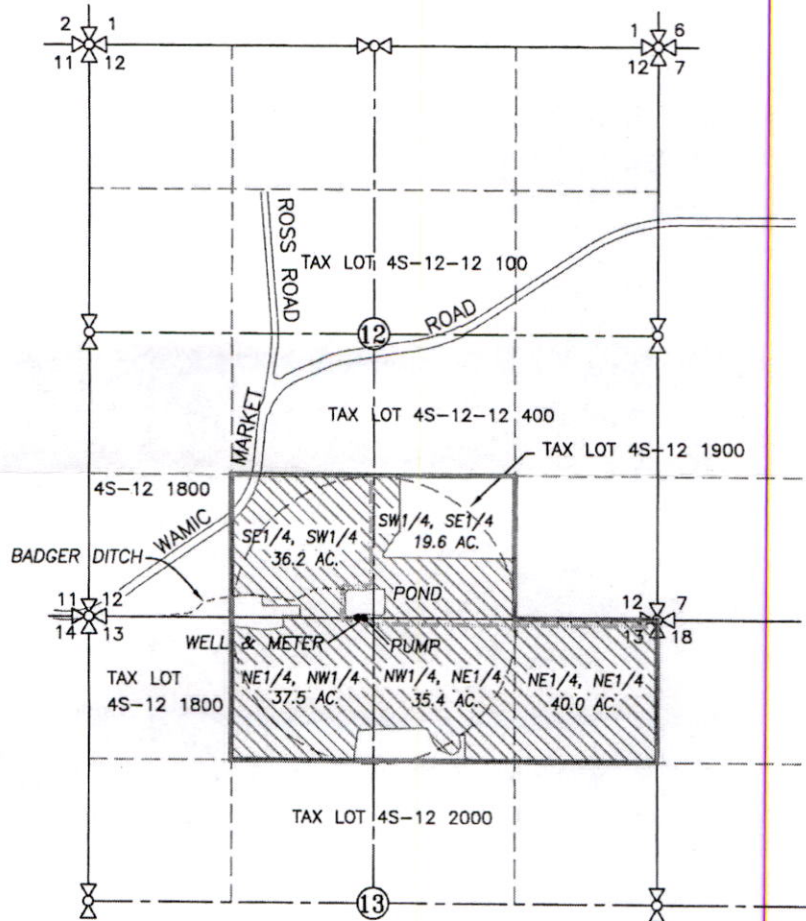


CLAIM OF BENEFICIAL USE MAP

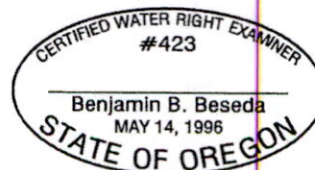

"THIS MAP IS NOT INTENDED TO PROVIDE
LEGAL DIMENSIONS OR LOCATIONS OF
PROPERTY OWNERSHIP LINES."

W.O. #12821wr

OWRE