



T.6S. R.1W. Section 19, W.M.

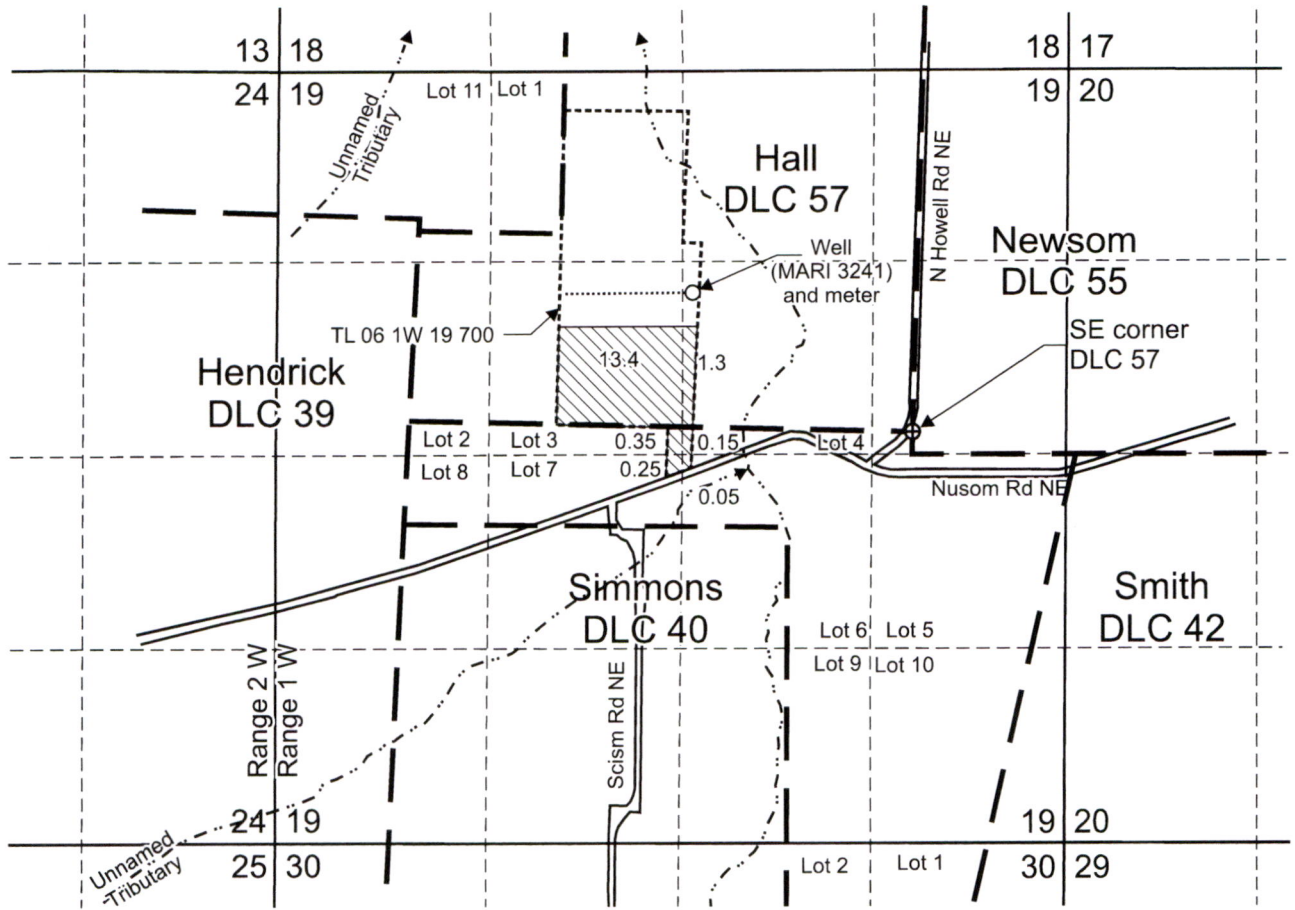

Well (MARI 3241) is located 950 feet north and 1,500 feet west from the SE corner, DLC 57.

 Area (15.5 Acres) irrigated under T-11299, formerly Certificate 86681, priority date: 6-24-1992.

----- Tax lot boundary

— · — Donation Land Claim boundary

..... Water main line - portable



Scale: 1" = 1,320'



This map was prepared for the purpose of identifying the location of a water right only and is not intended to provide legal dimensions or location of property ownership lines.



Claim of Beneficial Use Map
T-11299, formerly Certificate 86681

Blue Harvest Farms LLC
T.6S. R.1W. Section 19, W.M.

Received
SEP 06 2024
OWRD

Pacific Hydro-Geology Inc.

08/2024