


Received
SEP 26 2024
OWRD

T.2N. R.1W. Section 4, W.M.

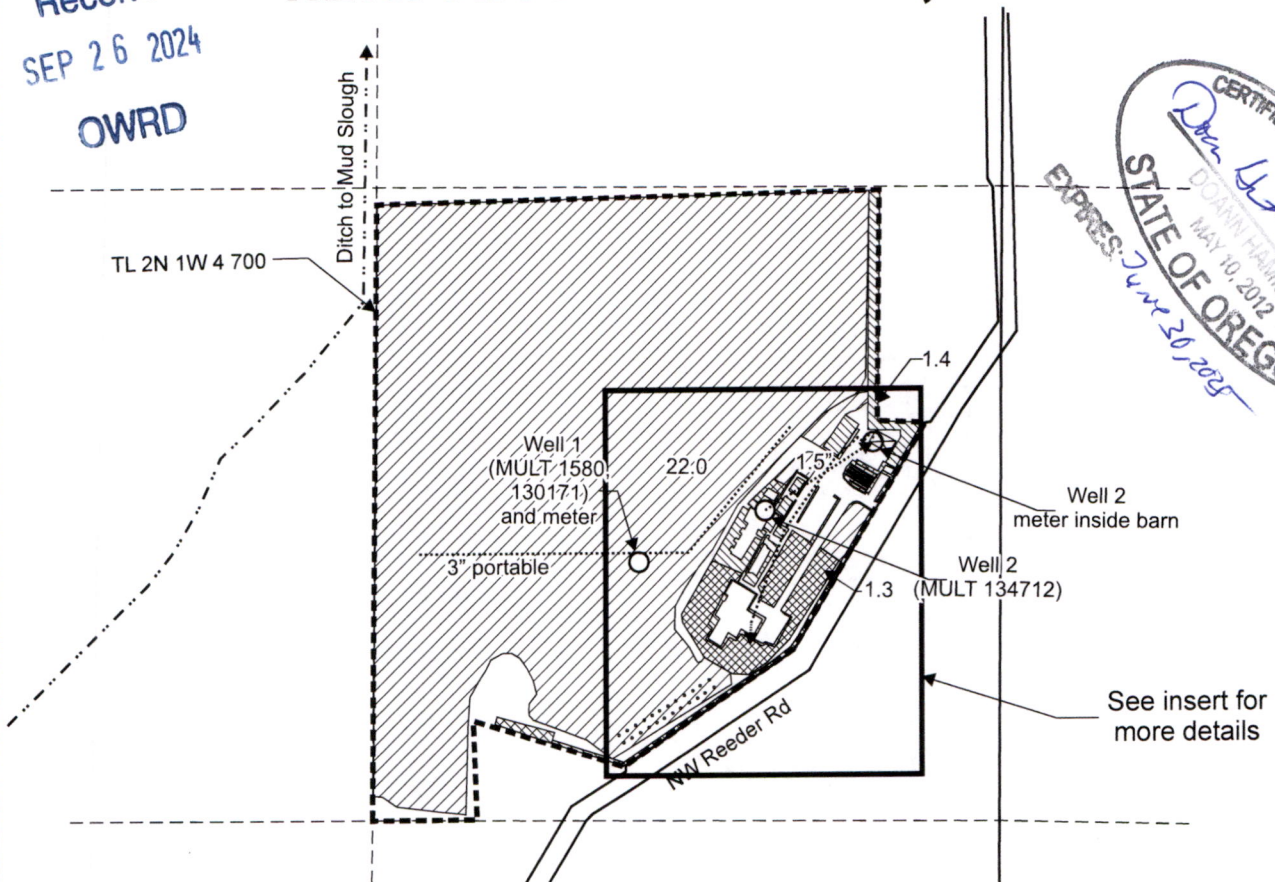

Well 1 (MULT 1580, 130171) is located 1,830 feet north and 740 feet west from the SE corner, Section 4.

Well 2 (MULT 134712) is located 1,935 feet north and 475 feet west from the SE corner, Section 4.

Area (22.0 Acres) irrigated under Application G-18629, Permit G-18860, T-13539 using Well 1 only.


Area (1.4 Acres) irrigated under Application G-18629, Permit G-18860, T-13539 using Well 2 only.

Area (1.3 Acres) irrigated under Application G-18629, Permit G-18860, T-13539 using both wells..

----- Tax lot boundary Water main line



Scale: 1" = 400'

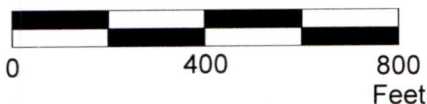

This map was prepared for the purpose of identifying the location of a water right only and is not intended to provide legal dimensions or location of property ownership lines.

Claim of Beneficial Use Map
Application G-18629, Permit G-18860, T-13539


Pacific Hydro-Geology Inc.

Columbia Holdings LLC c/o Peter Stott
T.2N. R.1W. Section 4, W.M.

09/2024

Received
SEP 28 2024
OWRD

T.2N. R.1W. Section 4, W.M.

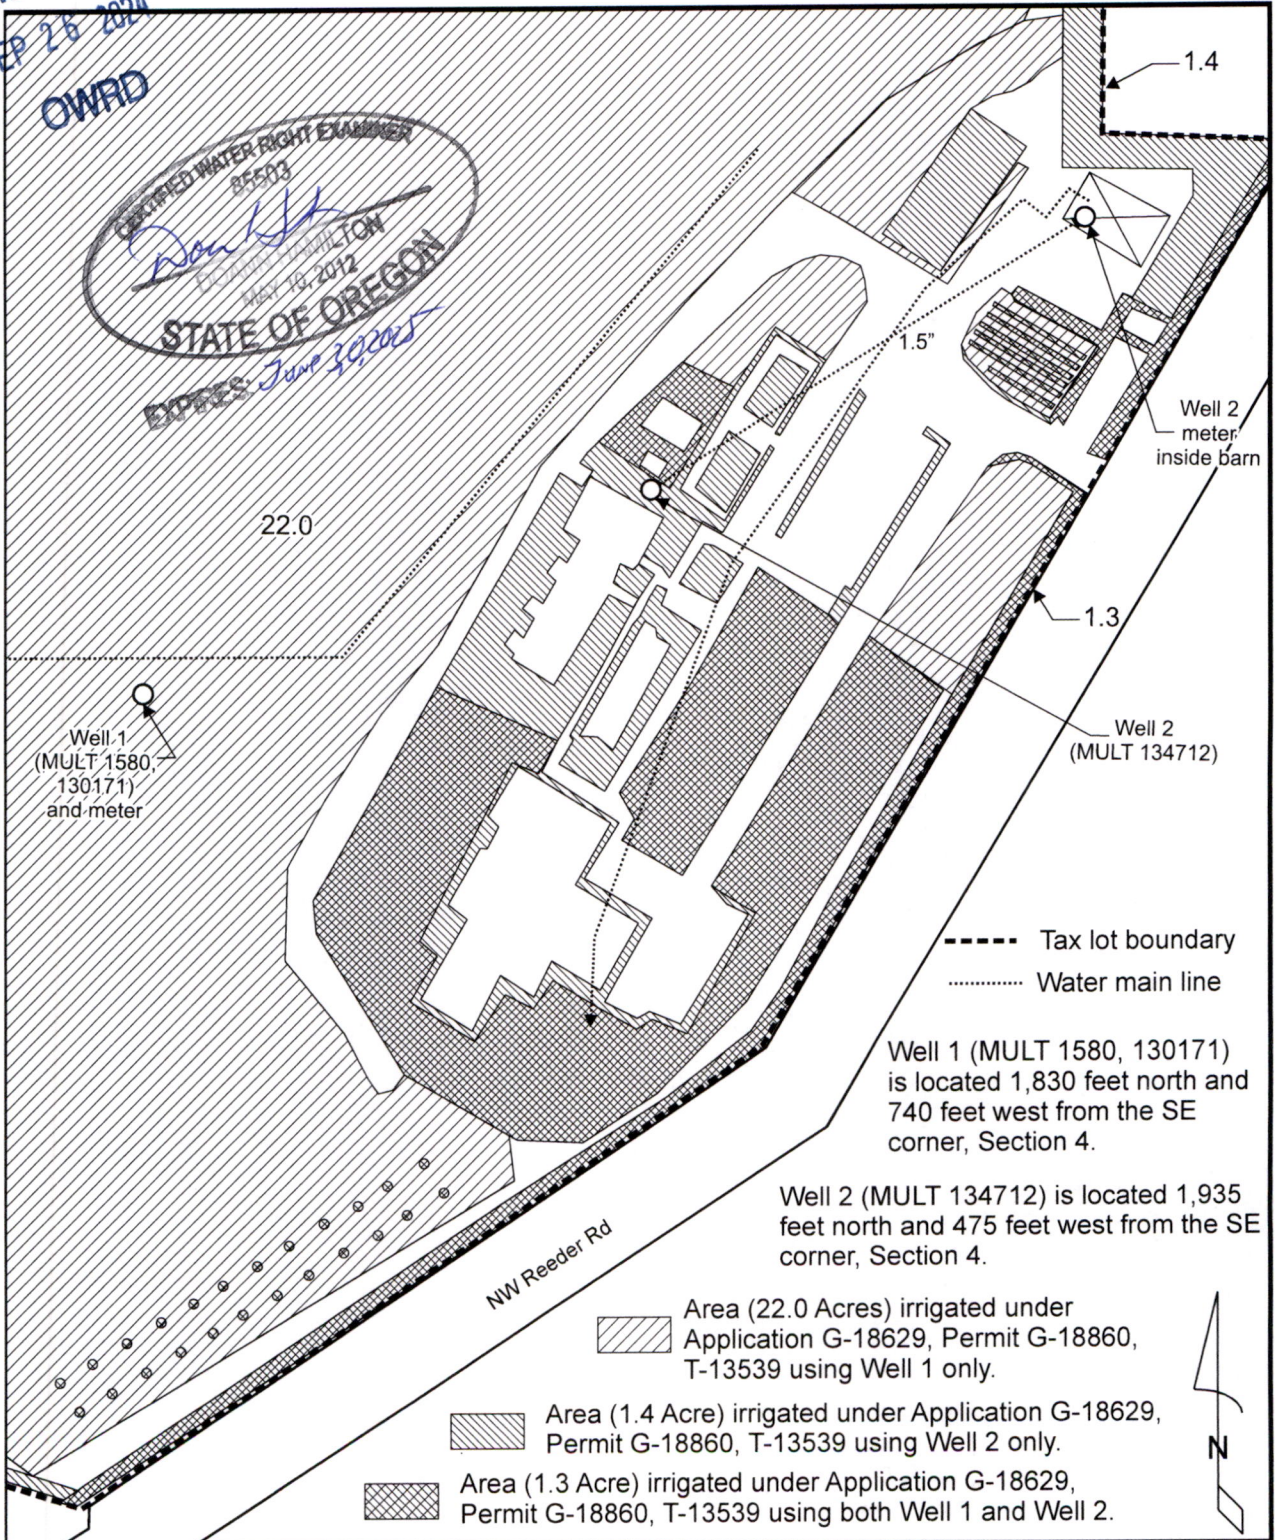

This map was prepared for the purpose of identifying the location of a water right only and is not intended to provide legal dimensions or location of property ownership lines.

Insert Box for Claim of Beneficial Use Map
Application G-18629, Permit G-18860, T-13539

Pacific Hydro-Geology Inc.

Columbia Holdings LLC c/o Peter Stott
T.2N. R.1W. Section 4, W.M.

09/2024