

Received

OCT 07 2024

OWRD

T.2S. R.3E. Section 13, W.M.

11 12
14 13

SE:Rebman,Rd.

NW 1/16th corner
Section 13



Spillway

Margaret
Reservoir

Lined area

POD
center of pond

Staff gauge

Impounded area

SE Amisigger Rd

TL 2 3E 13 300

SE Pawprint Ln


POD (center of pond) is located 615 feet south and 135 feet east from the NW 1/16 corner, Section 13.



Margaret Reservoir Area (0.8 Acres) under Application R-88018, Permit R-15088.

----- Tax lot boundary

Scale: 1" = 400'

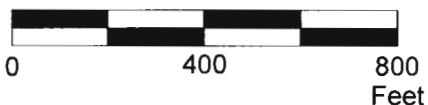

This map was prepared for the purpose of identifying the location of a water right only and is not intended to provide legal dimensions or location of property ownership lines.



Claim of Beneficial Use Map
Application R-88018, Permit R-15088

Pacific Hydro-Geology Inc.

Michael Townsend
T.2S. R.3E. Section 13, W.M.

09/2024

TownsendAmisiggerR-88018COBUNMap.cdr