


Claim of Beneficial Use - Transfer T-11426
J. Bacon Farms, LLC

Township 5S, Range 5W, W.M.

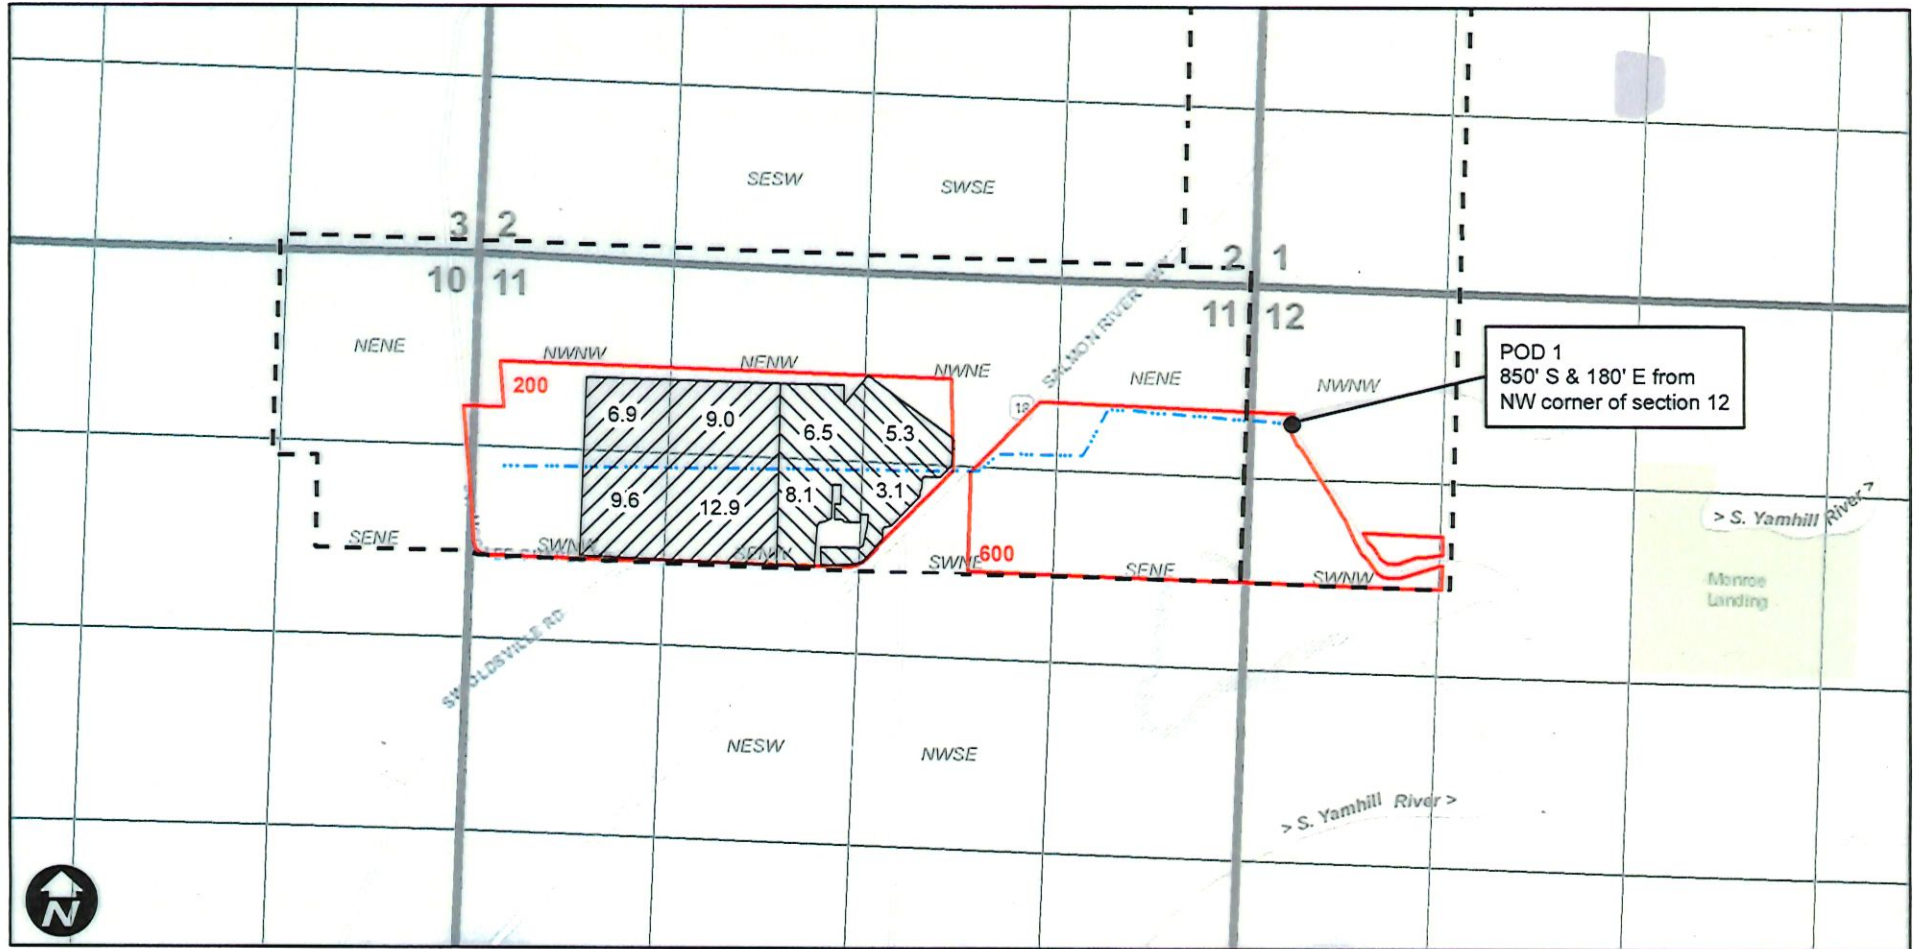

0 660 1,320 2,640 Feet

This map is not intended to provide legal dimensions or locations of property ownership lines.

Legend

- Place of Use (from 40415) DLC
- Place of Use (from 45126) Tax Lot
- Mainline

RECEIVED

MAY 3 2011

CWRD



WILL MCGILL SURVEYING LLC

