


Claim of Beneficial Use
Transfer T-11523 - Ditchen Berry Company, LLC

RECEIVED

MAY 4 2022

DWRD

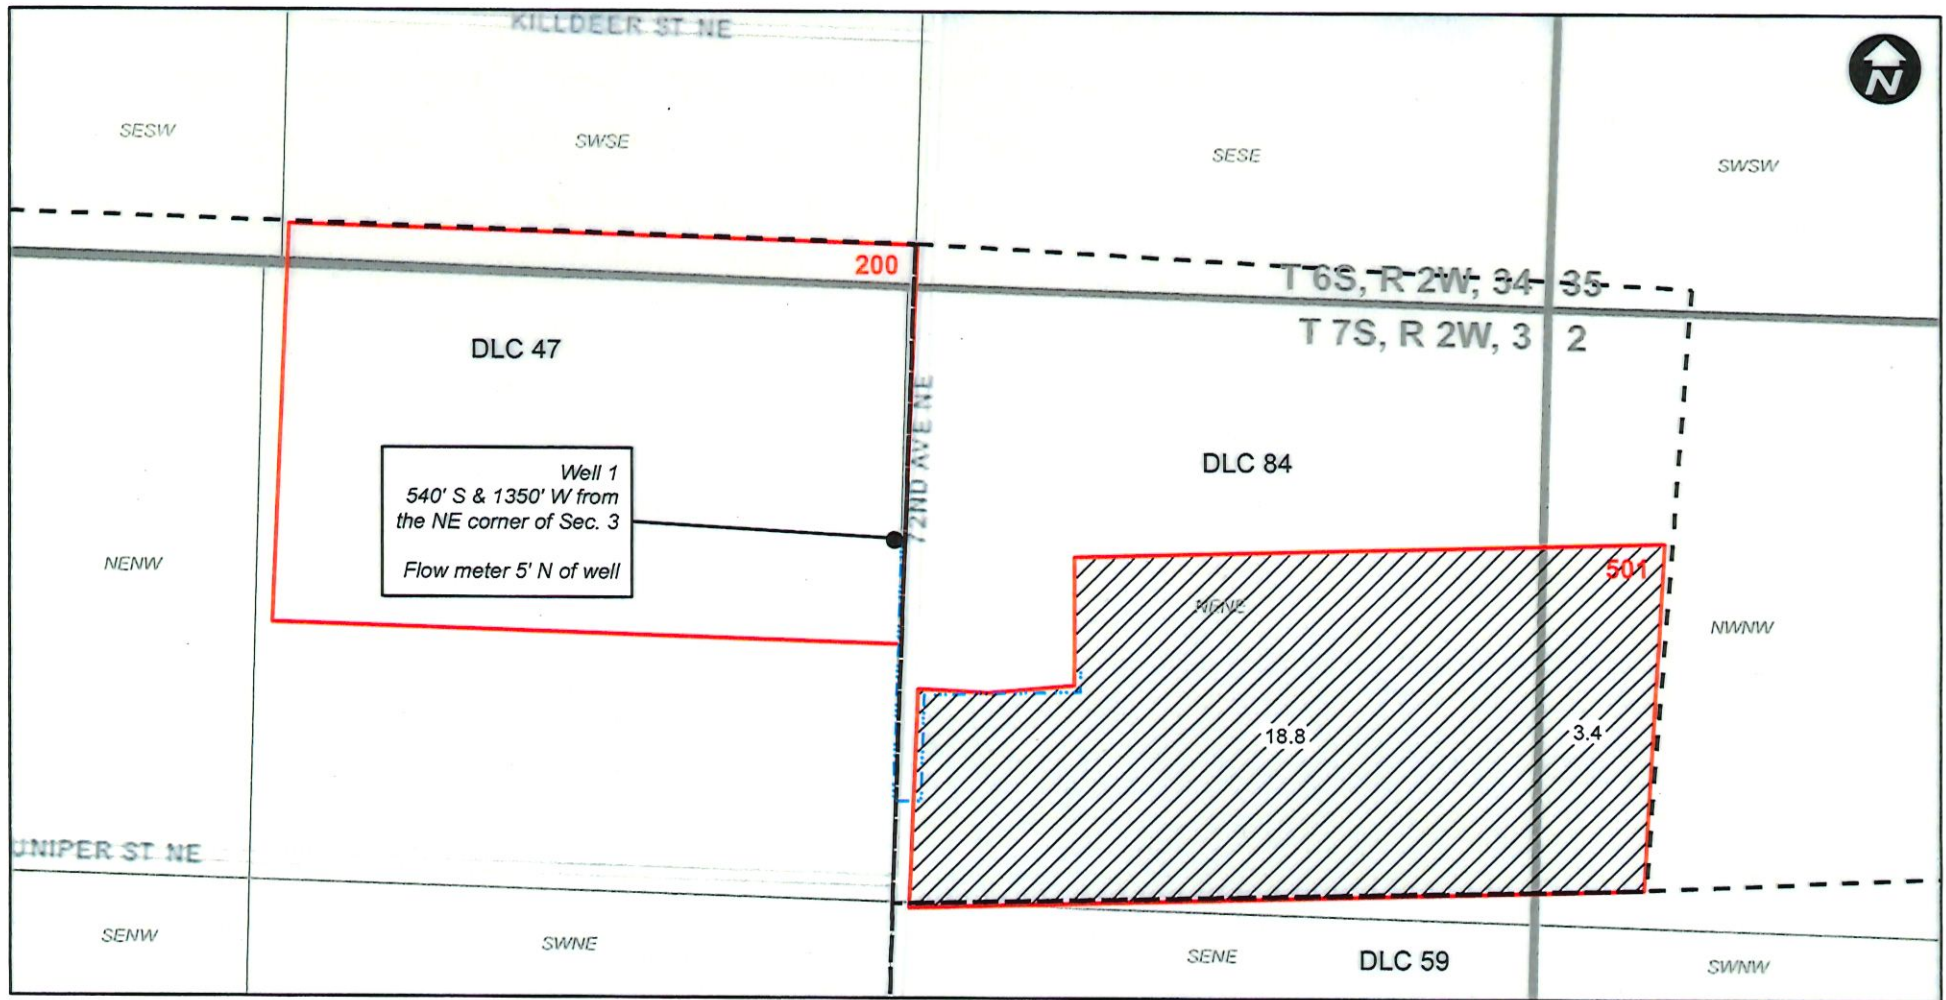

Legend

- Mainline
- ▨ T-11523 POU (New POA)
- ▭ Tax Lots
- - - DLC

This map is not intended to provide legal dimensions or locations of property ownership lines.