


Havel Place LLC Claim of Beneficial Use Transfer T-11644

Township 9S, Range 2E, W.M.

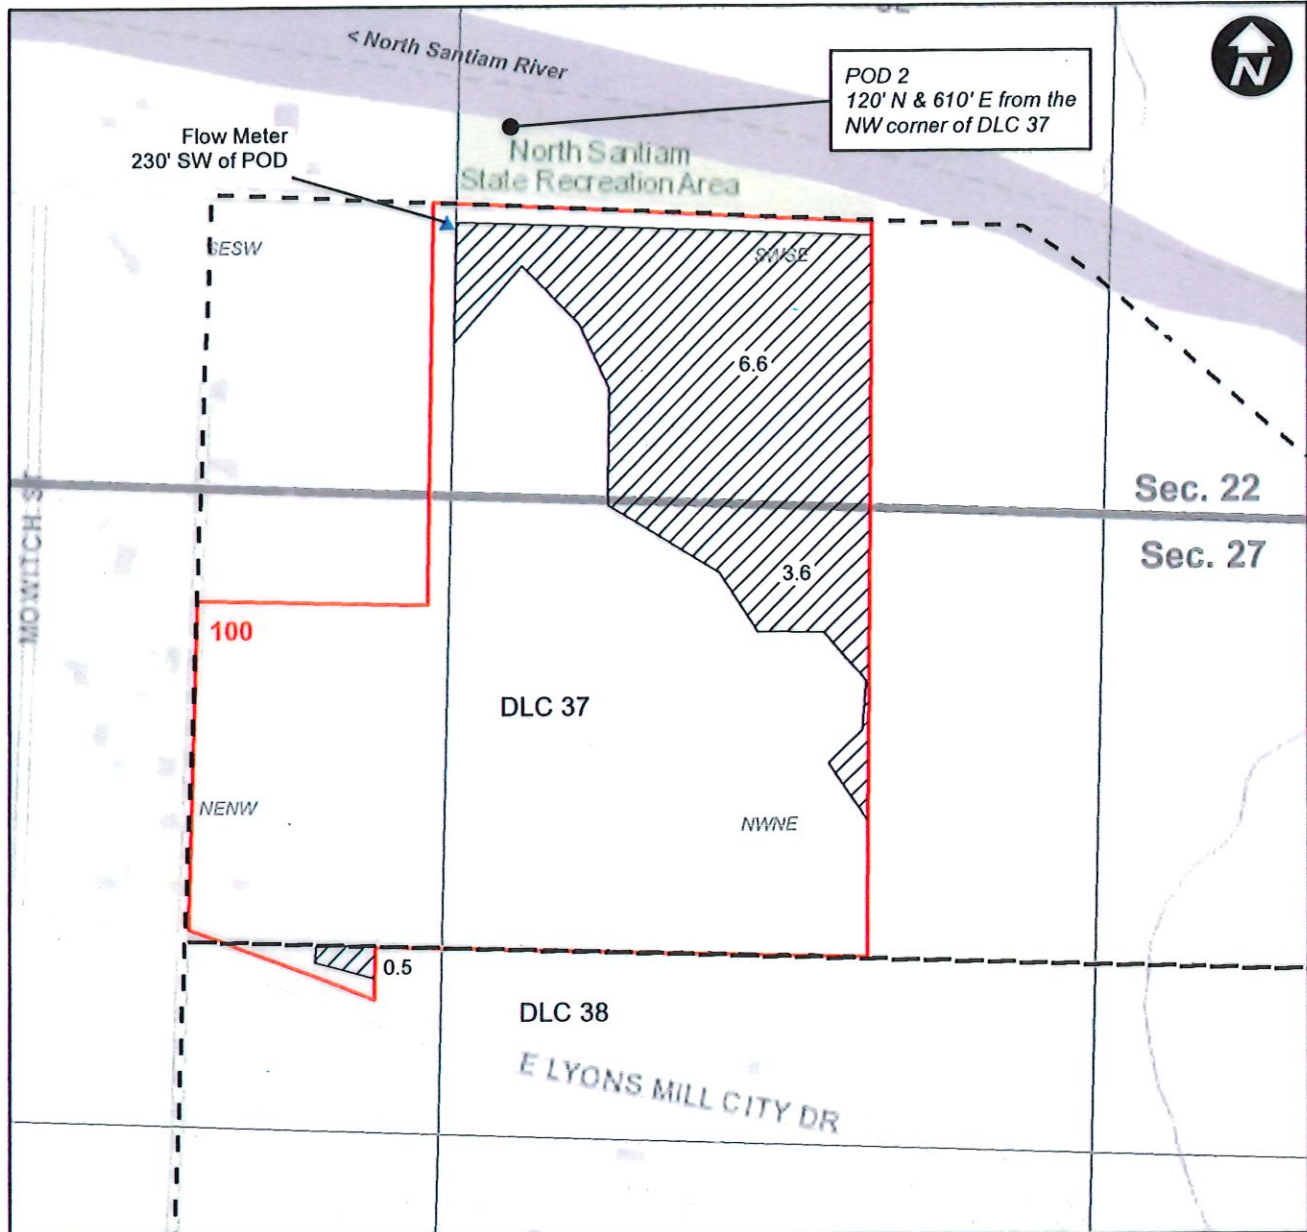

This map is not intended to provide legal dimensions or locations of property ownership lines.

0 200 400 800 Feet

Legend

POU Taxlot DLC



RECEIVED
APR 05 2023