


#### LEGEND

- |                            |                           |
|----------------------------|---------------------------|
| ● Point of Diversion (POD) | □ Tax Lot                 |
| M Meter                    | Donation Land Claim (DLC) |
| F Fish Screen              | Major Road                |
| ◇ Staff Gauge              | Watercourse               |
| — Conveyance Line          | Waterbody                 |
| ▨ Place of Use (POU)       |                           |

#### CERTIFIED WATER RIGHTS EXAMINER STAMP

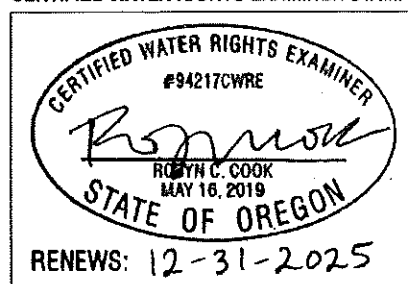

#### LOCATION DESCRIPTION

**DAM**  
 Located 445 feet South and 835 feet East from the Northern corner of DLC 66, Township 9 South, Range 5 West (W.M.)

**POD 1**  
 Located 375 feet North and 500 feet East from the Northern corner of DLC 66, Township 9 South, Range 5 West (W.M.)

**POD 2**  
 Located 375 feet South and 240 feet West from the Northern corner of DLC 66, Township 9 South, Range 5 West (W.M.)

### Claim of Beneficial Use in the Name of Hamilton Farms, LLC

Application R-88340, Permit R-15211

Polk County  
 Township 9 South, Range 5 West (W.M.)

Received  
 MAY 16 2019

QWRD

#### DISCLAIMER

This map was prepared for the purpose of identifying the location of a water right only and it is not intended to provide legal dimensions or location of property ownership lines.

Date: April 24, 2024

Data Sources: BLM, ESRI, QWRD, USGS

