



LEGEND


- ⊙ Point of Diversion (POD)
- Staff Gauge
- ▨ Place of Use (POU)
- Taxlot
- Donation Land Claim (DLC)
- Government Lot (GL)
- Watercourse
- Waterbody

Claim of Beneficial Use Map City of Hillsboro

Application R-88419; Permit R-15295

Township 1 South, Range 2 West (W.M.)
Washington County

CERTIFIED WATER RIGHTS EXAMINER STAMP

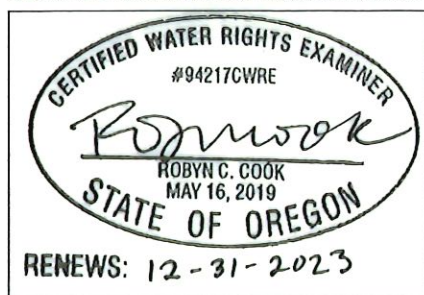

RECEIVED

NOV 21 2023

WRD

POD LOCATION DESCRIPTION

Outlet
Located 1365 feet South and 1300 feet East from the NW corner of Section 7, Township 1 South, Range 2 West (W.M.)

DISCLAIMER

This map was prepared for the purpose of identifying the location of a water right only and it is not intended to provide legal dimensions or location of property ownership lines.

Date: November 1, 2023

Data Sources: BLM, ESRI, OWRD, USGS

