

RECEIVED

FEB 22 2019

Historic Change in Point of Diversion/Appropriation Map


Certificate 86049

Sections 14, 15, and 22, Township 6S, Range 1W, W.M.

RECEIVED

FEB 01 2019

OWRD

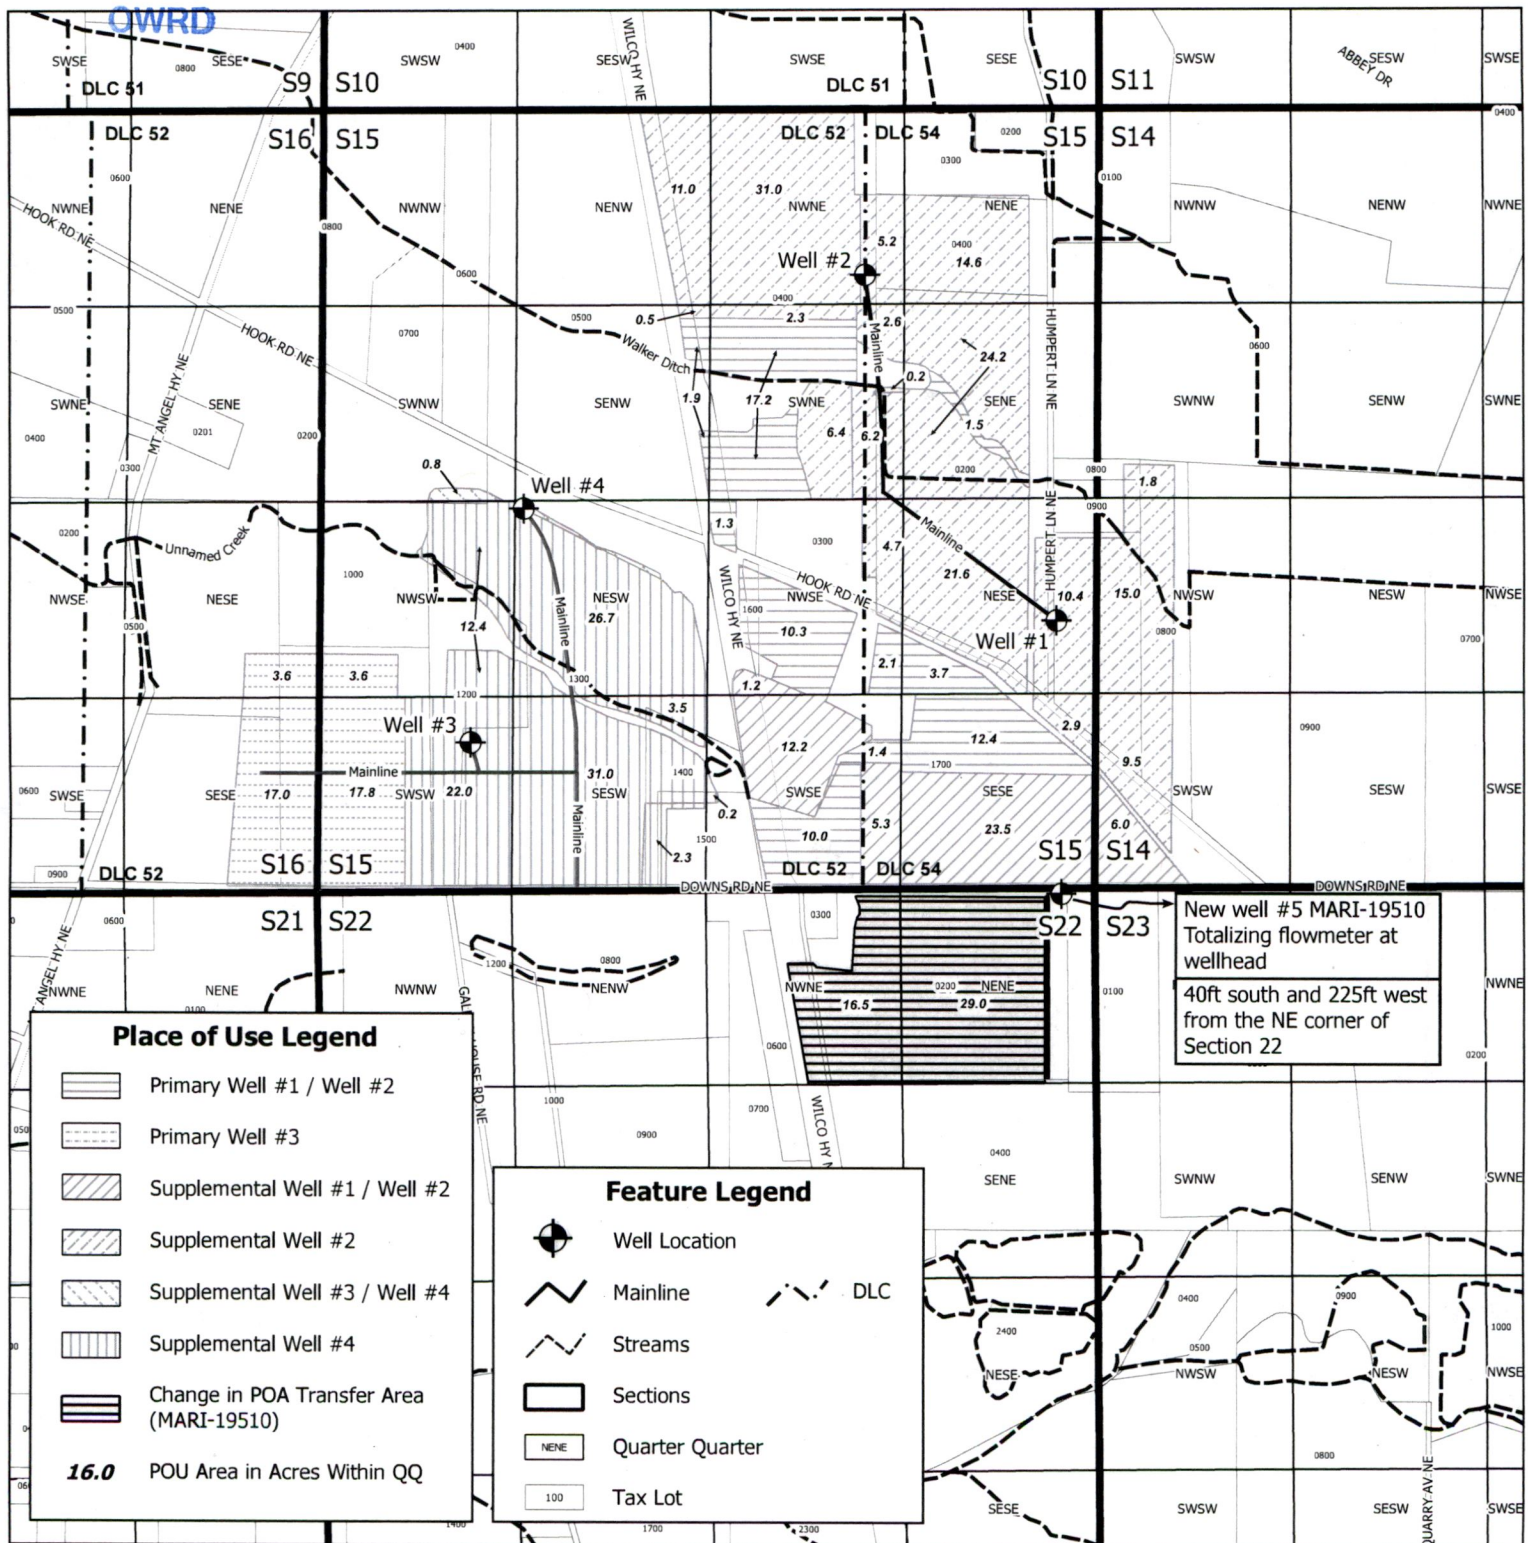

CWM-H2O

Complete Water Management



1319 SE MLK Jr. Blvd, Suite 204
Portland, Oregon 97214
(503) 954-1326

This map is not intended to provide legal dimensions or property ownership lines.

1	11/6/2017	RMD	DRAFT
2	1/21/2019	REL	FINAL
No.	Date	By	Revisions




0 660 1320 ft

Proj#: 1719001 - Jaeger Water Right POA
Transfer and CBU

13007 Downs Road
Mt. Angel, Oregon 97132

13130

T. 6 S., R. 1 W., W.M.

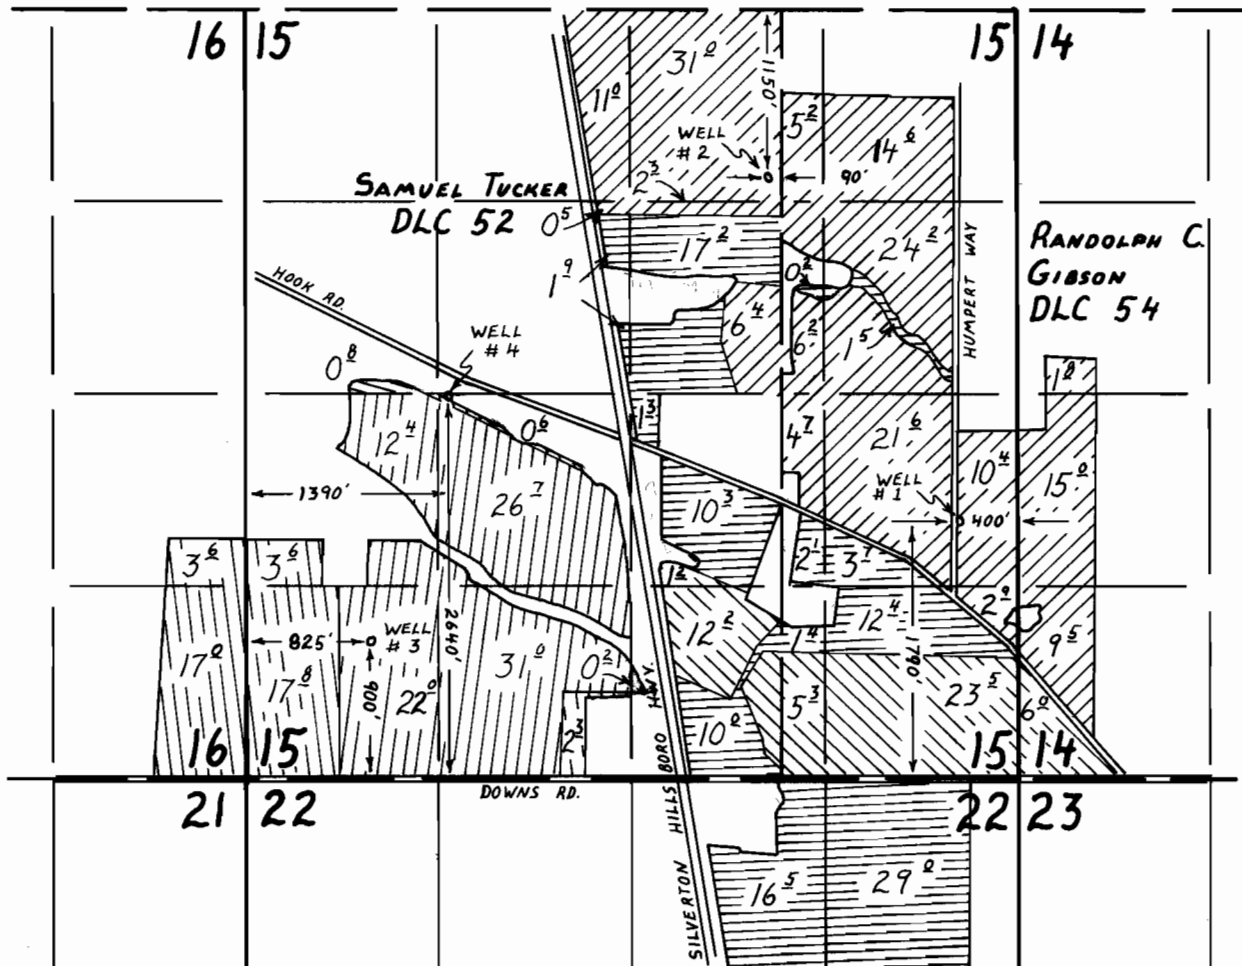

	PRIMARY WELL 3		PRIMARY WELL 1 & 2
	SUPPLEMENTAL WELL 4		SUPPLEMENTAL WELL 2
	SUPPLEMENTAL WELL 3 & 4		SUPPLEMENTAL WELL 1 & 2

FINAL PROOF SURVEY UNDER

Application No. G-11504 Permit No. G-10828
IN NAME OF

CHARLES WAVRA

Surveyed AUGUST 11, 1992, by R.W. Klassen



1" = 1320'


RECEIVED

AUG 23 2021

OWRD

Map to Accompany Application
For Transfer to Change Points of Appropriation
In the Name of
Eileen M. Clark Living Trust

T. 6 S., R. 1 W., WM

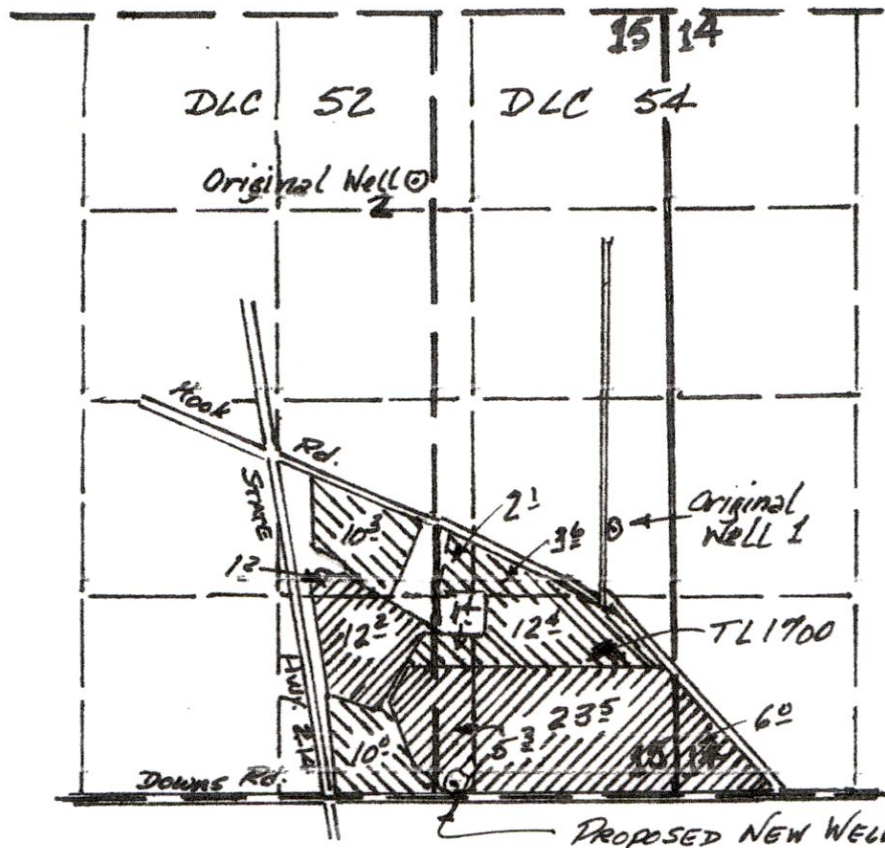

Scale ; 1" = 1,320'

POA's Located:

Original Well 1- 1,790' N & 400' W from SE Cor. Sec. 15

Original Well 2- 1,150' S & 90' W from NE Cor. DLC 52

Proposed New Well- 50' N & 1,520' W from SE Cor. Sec. 15

 - Primary Irrigation

 - Supplemental Irrigation



Expires:

This map is for the purpose of identifying the location of water rights only, and is not
Intended to provide legal dimensions or locations of property lines.

13804